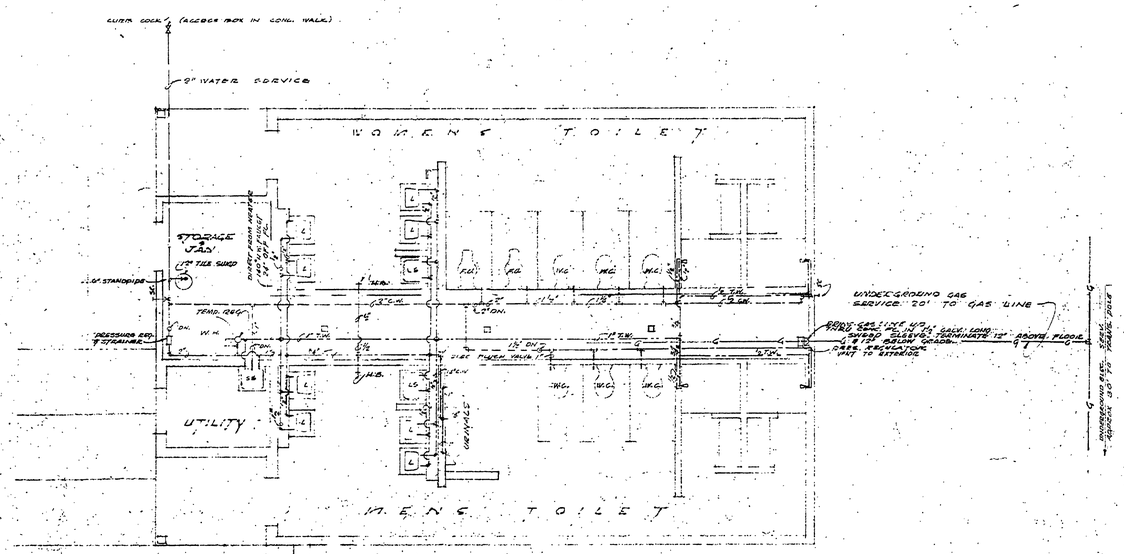

PLUMBING PLAN

SCALE ¼" = 1'-0"

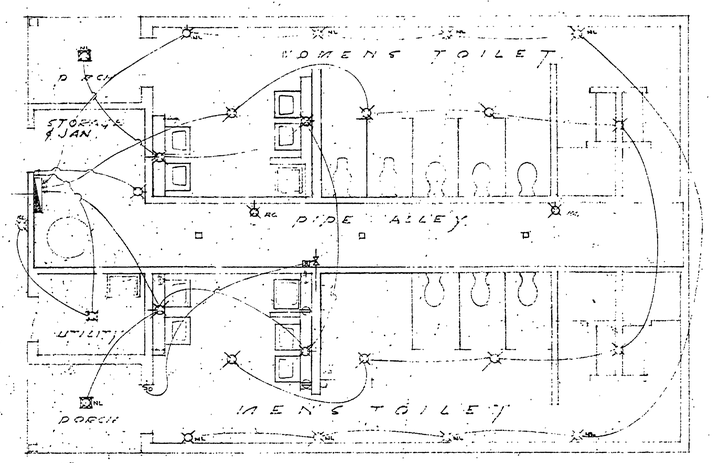

ELECTRICAL PLAN

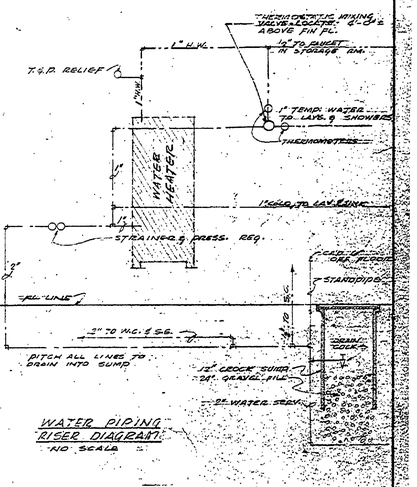

WATER PIPING RISER DIAGRAM

NO SCALE

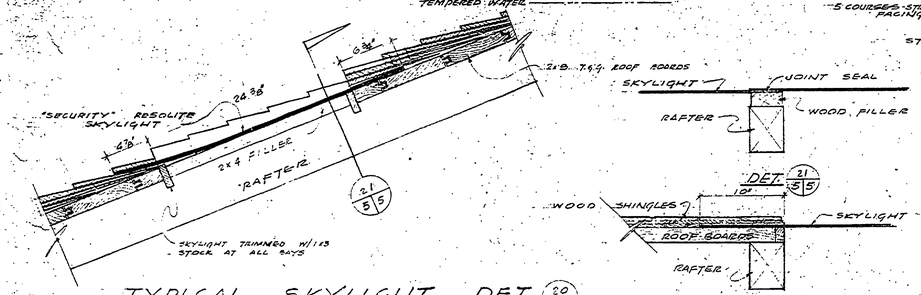

TYPICAL SKYLIGHT DET. 20/3/5

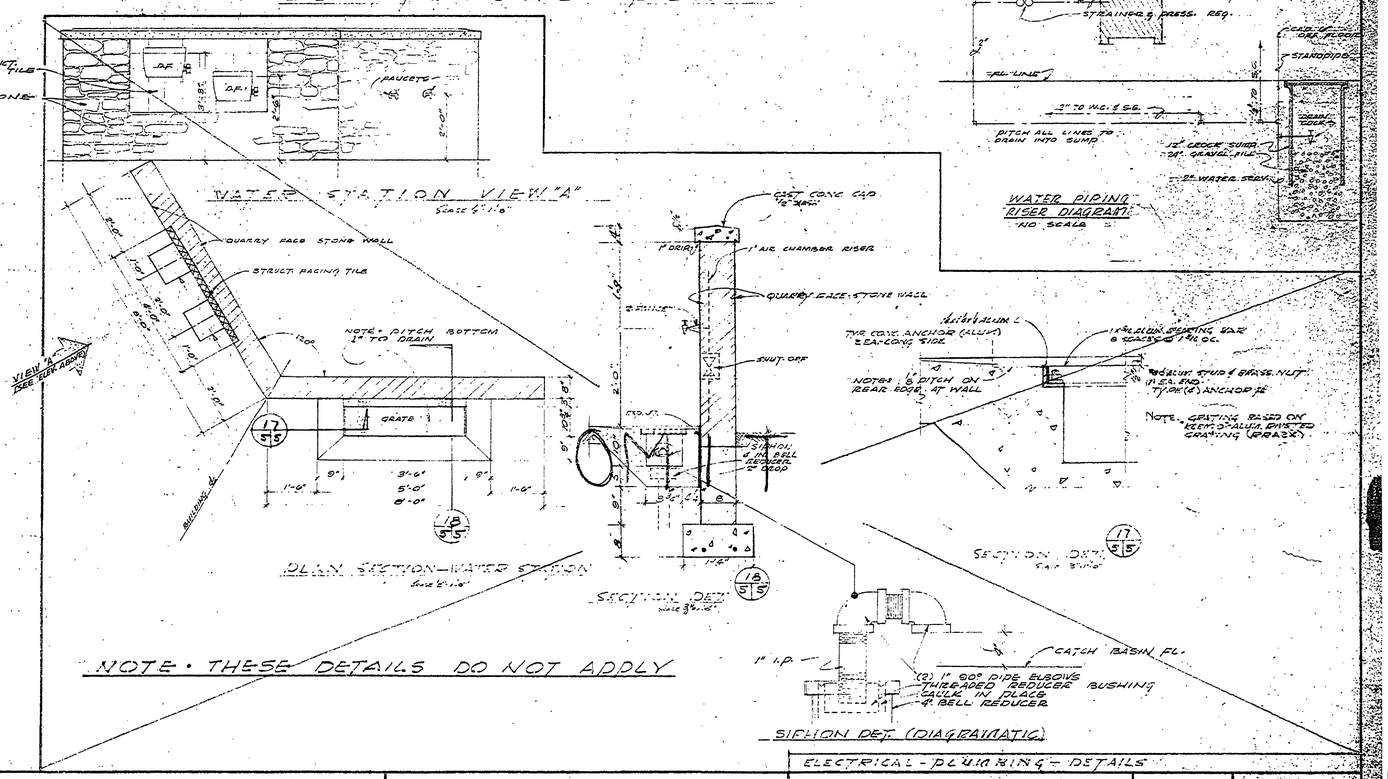

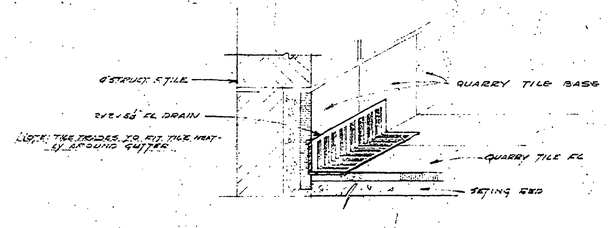

DET. OF GUTTER TYPE FL. DRAIN (SEEQD.)

NOTE • THESE DETAILS DO NOT APPLY

NO.	DATE	BY	REVISIONS
1			
2			
3			
4			
5			
6			

	DATE	REVIEWED	DATE	APPROVED	DATE
DESIGNED BY W.J.G.		ARCHITECTURAL W.J.G.	10-17-62		
DRAWN BY		ENGINEERING	10-25-62		
CHECKED BY		LANDSCAPE	10-25-62		

MICHIGAN
DEPARTMENT OF CONSERVATION
PARKS AND RECREATION DIVISION

ELECTRICAL - PLUMBING - DETAILS

TRAVERSE CITY STATE PARK
TOILET AND SHOWER BUILDING # 5

SHEET NO. 5 OF 6

PLAN NO. A-103