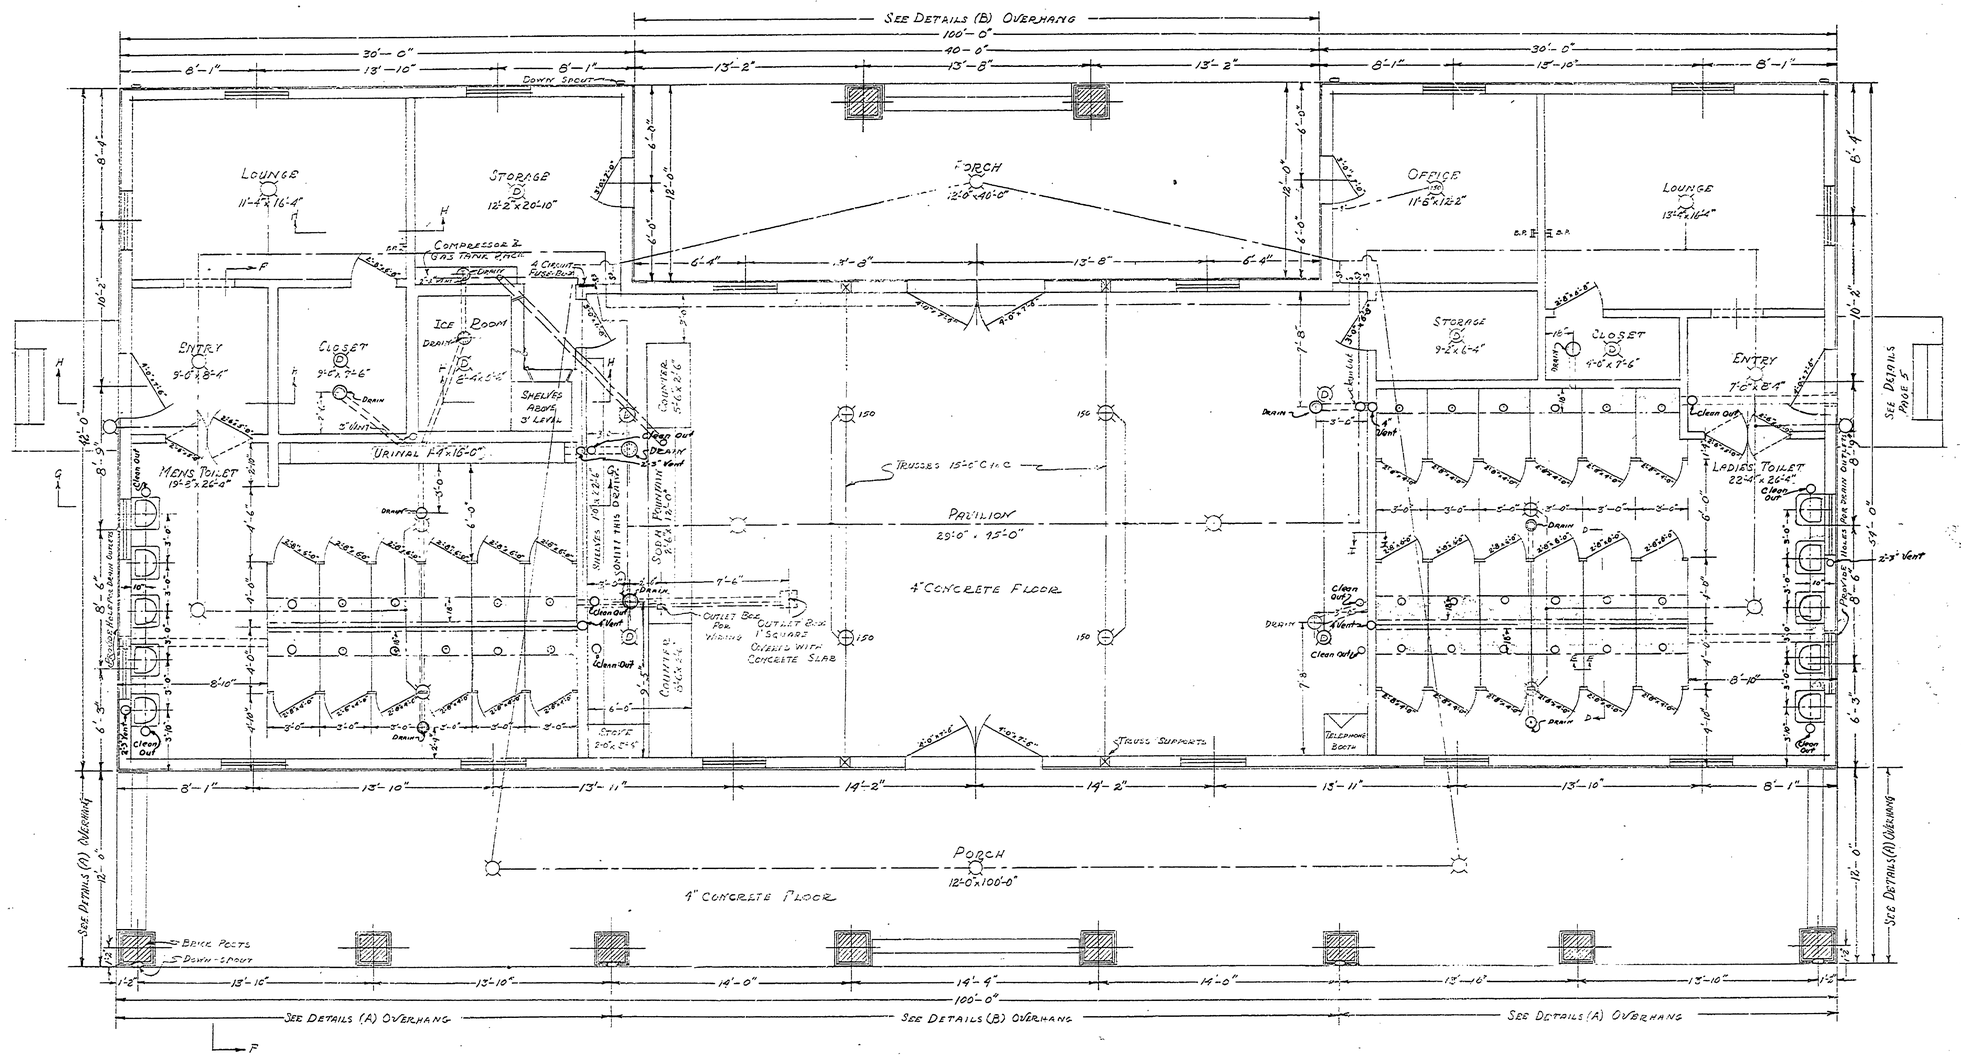

NOTE:

ALL OUTSIDE WALLS ON FLOOR PLAN WERE ORIGINALLY DRAWN FOR TILE CONSTRUCTION AND ARE SHOWN AS 16" THICK. SPECIFICATIONS NOW CALL FOR WOOD CONSTRUCTION - SIZE OF ROOMS AND DIMENSIONS ONLY ARE CORRECTED; ALLOW 4" WHEN SCALING FROM INSIDE of EXTERIOR WALLS ON BLUE PRINT -

ALL LIGHTS 100 WATTS EXCEPT THOSE NOTED -

PLAN OF PAVILION -
DEPARTMENT OF CONSERVATION
DIVISION OF STATE PARKS
SCALE: 1" = 8'-0"
10-7-31. R.M.S. - H.C.M.

A-96

BAY CITY

INSURANCE No. 10

P25-A - PAGE 2 of 6

P.R. Herrick Reg. Archt.