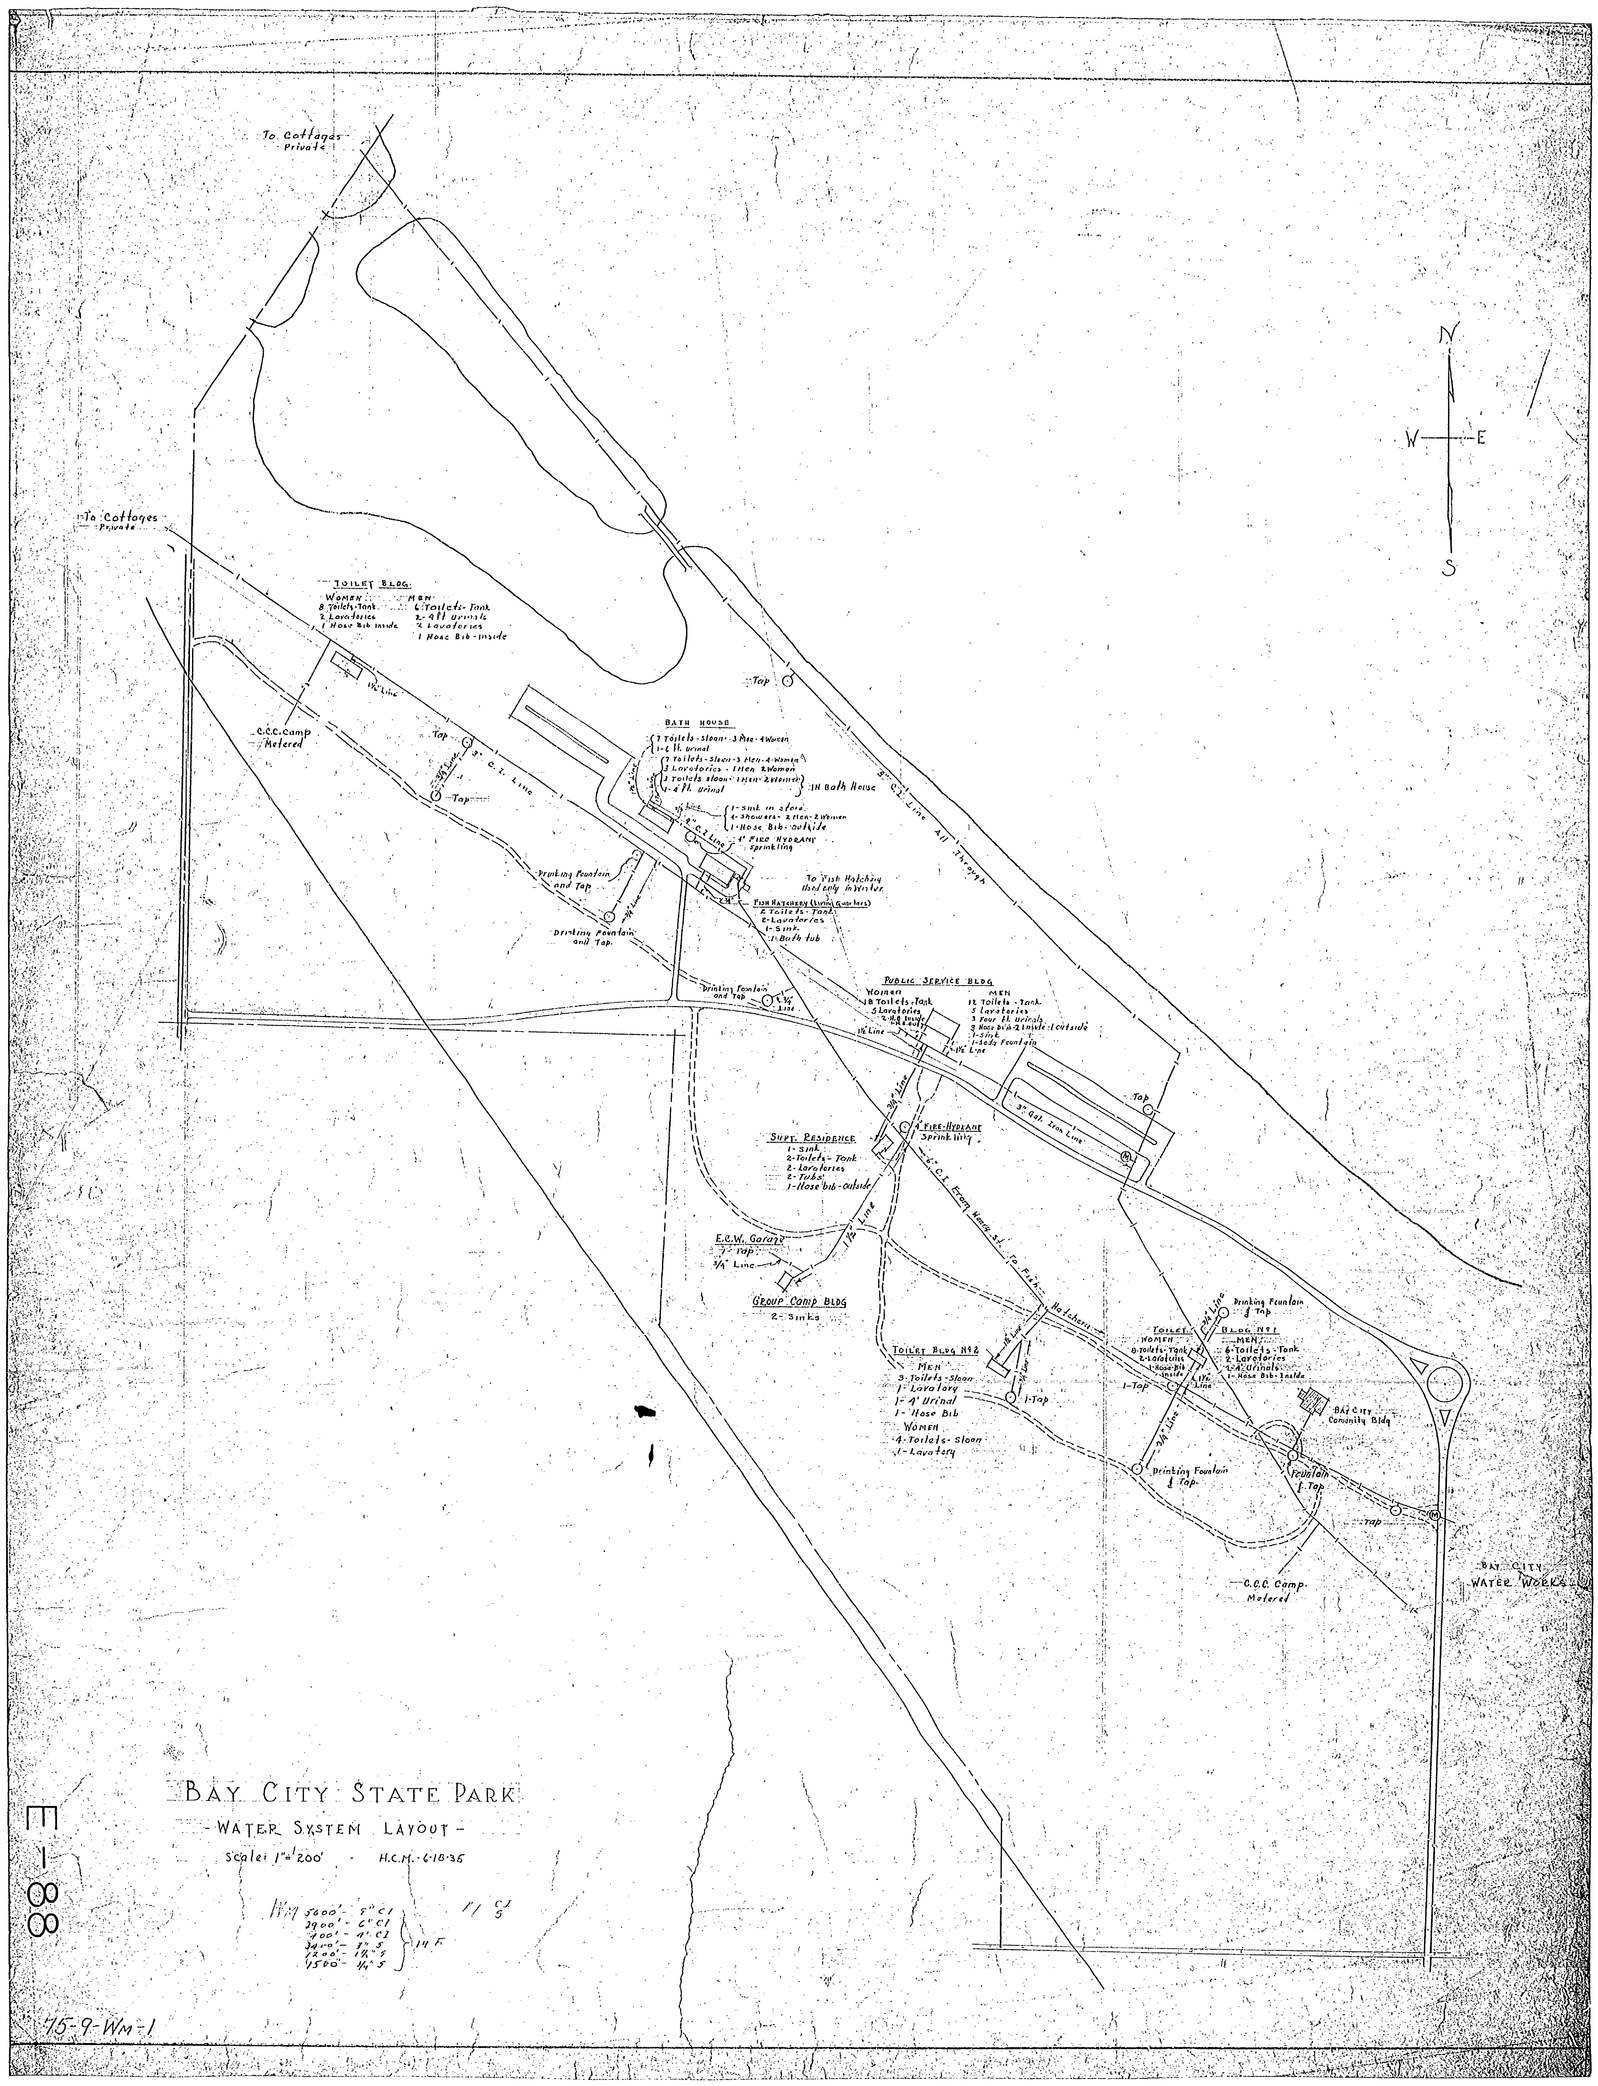

BAY CITY STATE PARK

-WATER SYSTEM LAYOUT-

Scale: 1" = 200' H.C.M. - 6-18-35

5600' - 5" CI
2900' - 6" CI
400' - 4" CI
3400' - 3" S
1200' - 1½" S
1500' - 1¼" S
14 F

11 CI
5

M 1 88

75-9-WM-1