




DESIGNED BY	DATE	REVIEWED	DATE	APPROVED	DATE	NO.	DATE	BY
ARCHITECTURAL	3-6-67	W.B.C.	3-6-67			1		
ENGINEERING	3-6-64	K.E.B.	3-6-64			2		
LANDSCAPE	3-11-64	M.L.C.	3-11-64			3		
CHECKED BY						4		
						5		
						6		

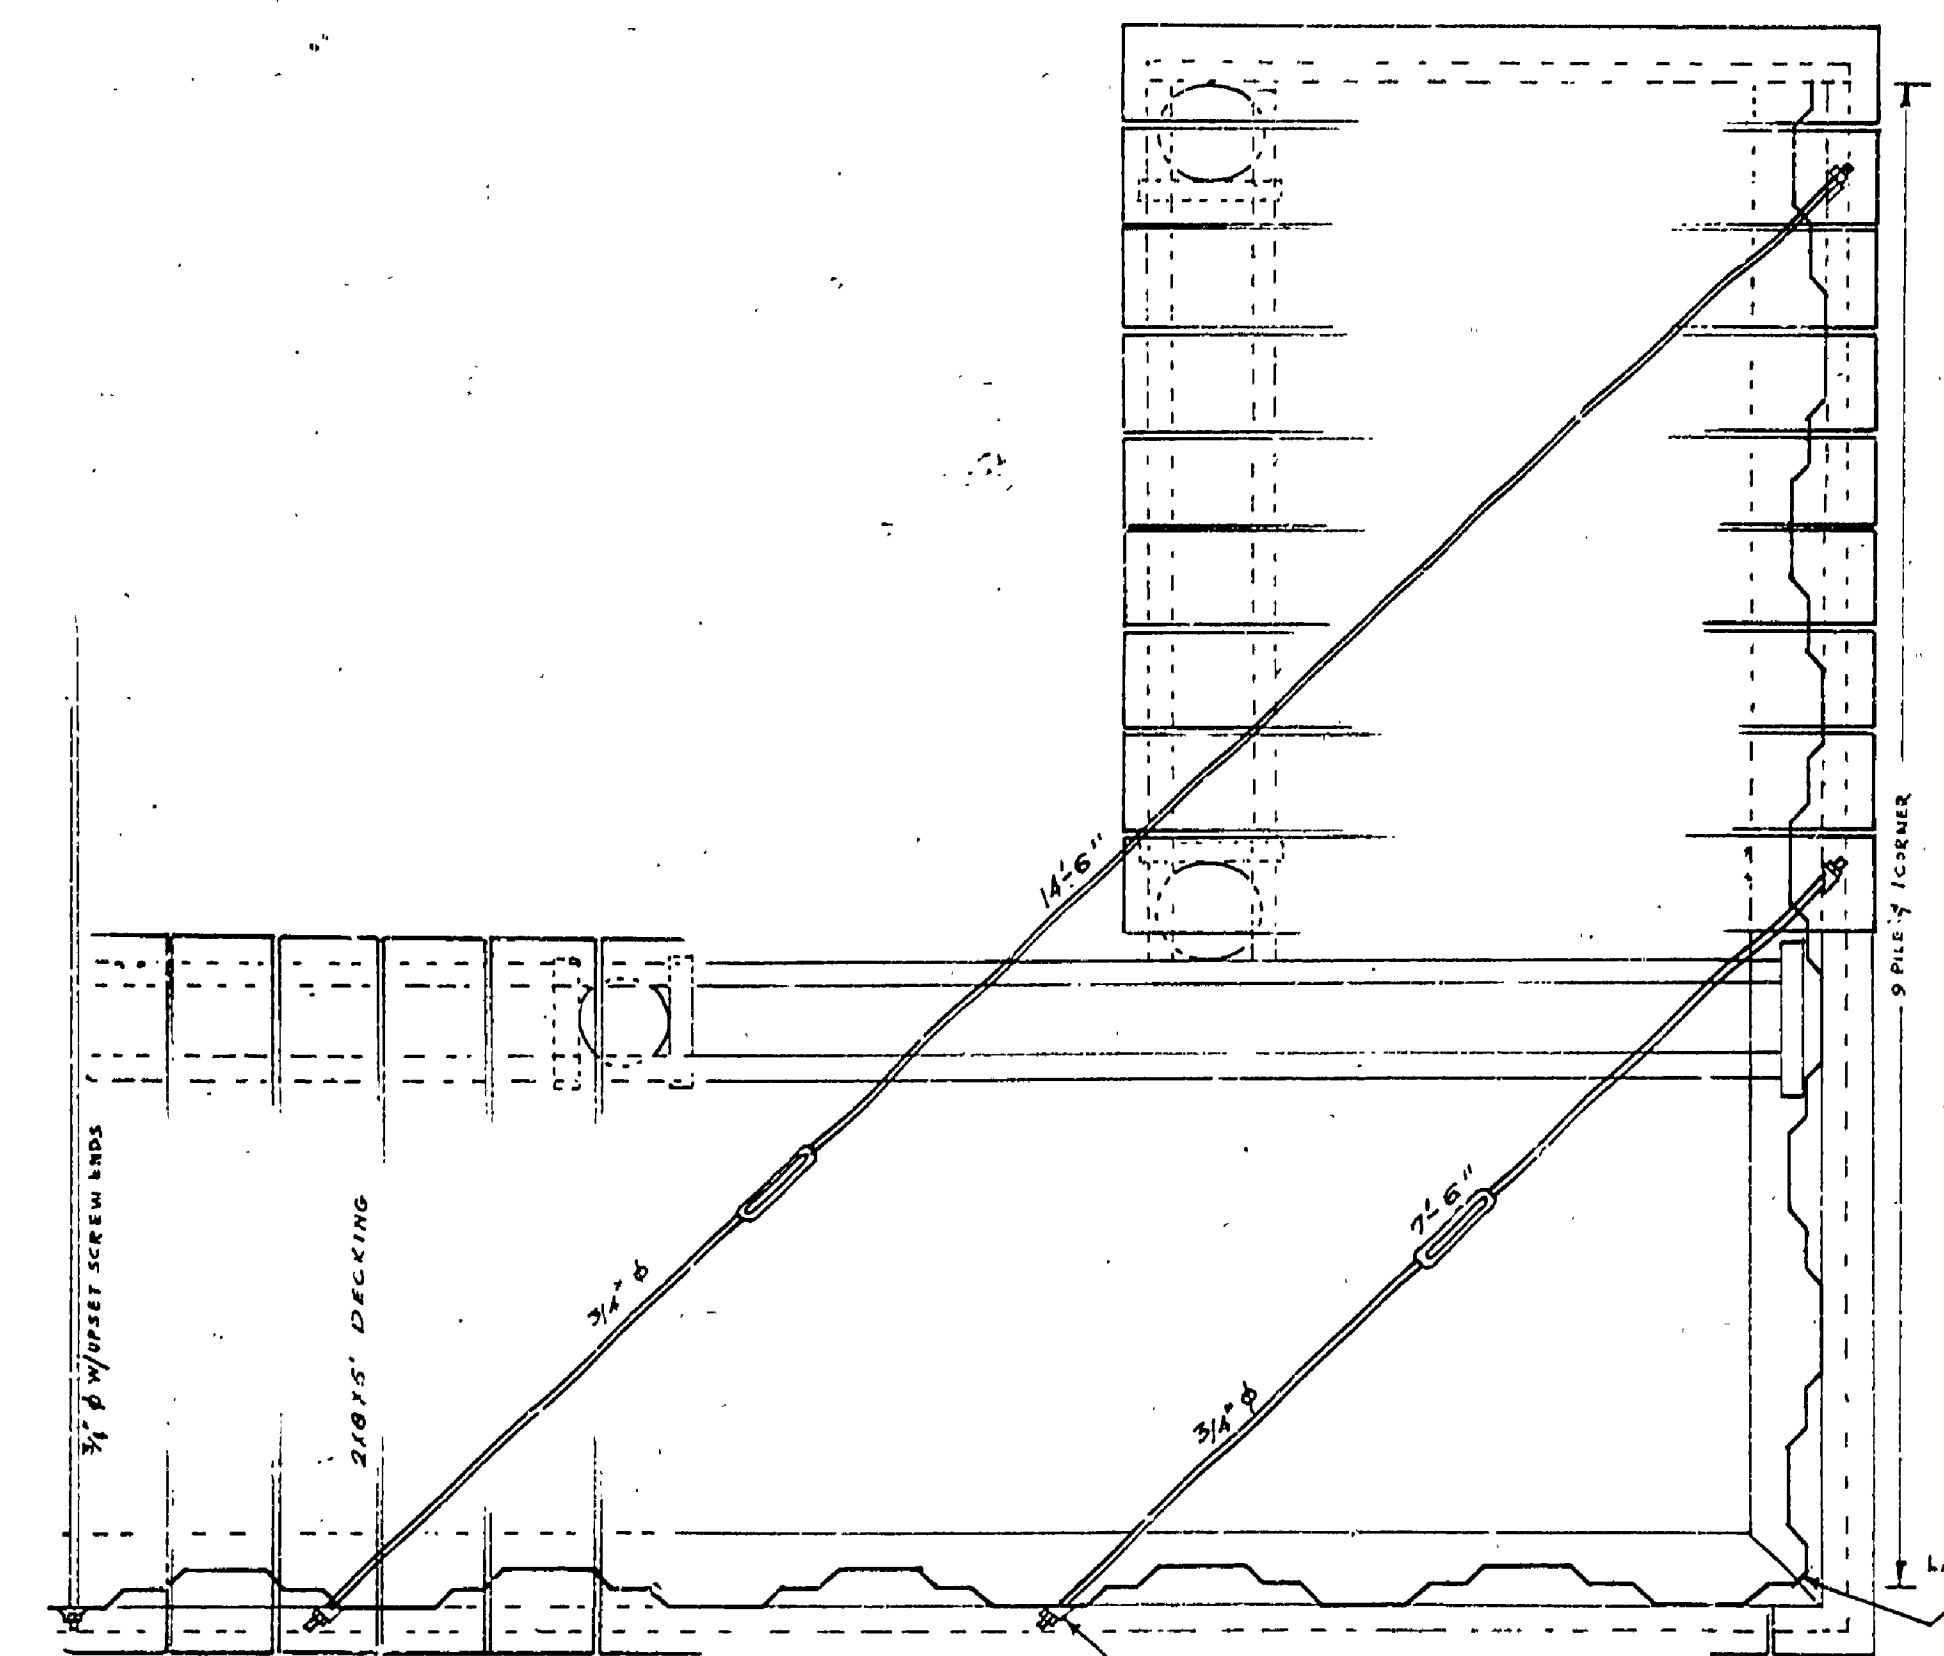


DETAIL B
 3/4" - 1" 0"

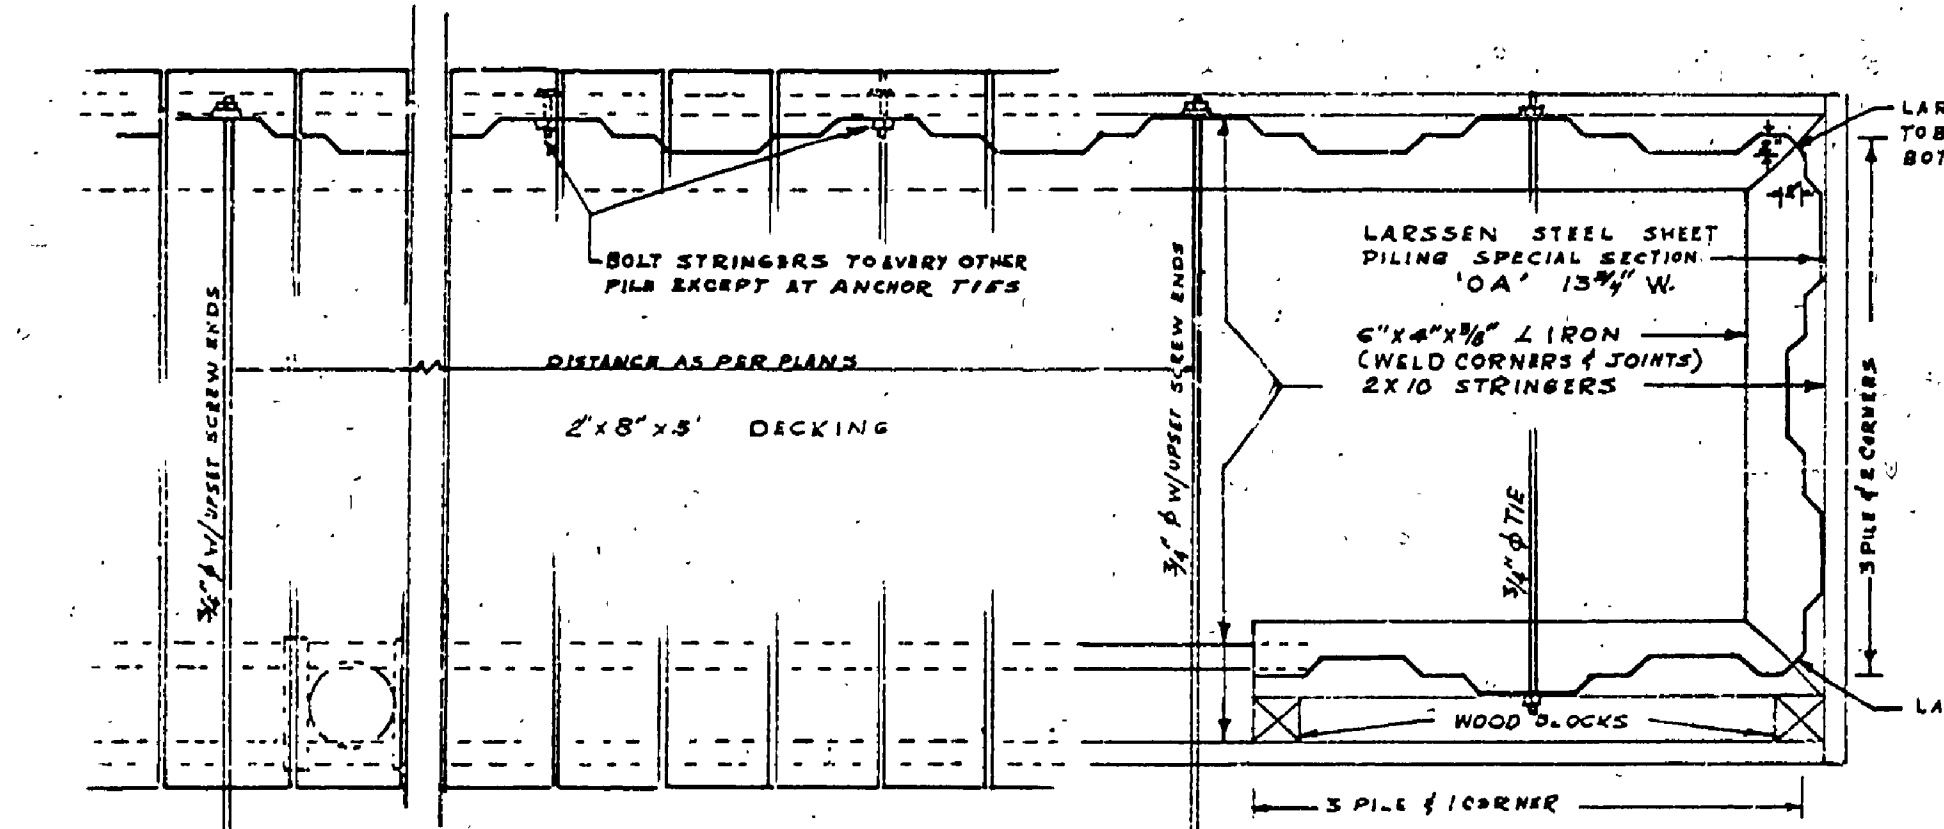



DETAIL A
 3/4" - 1" 0"

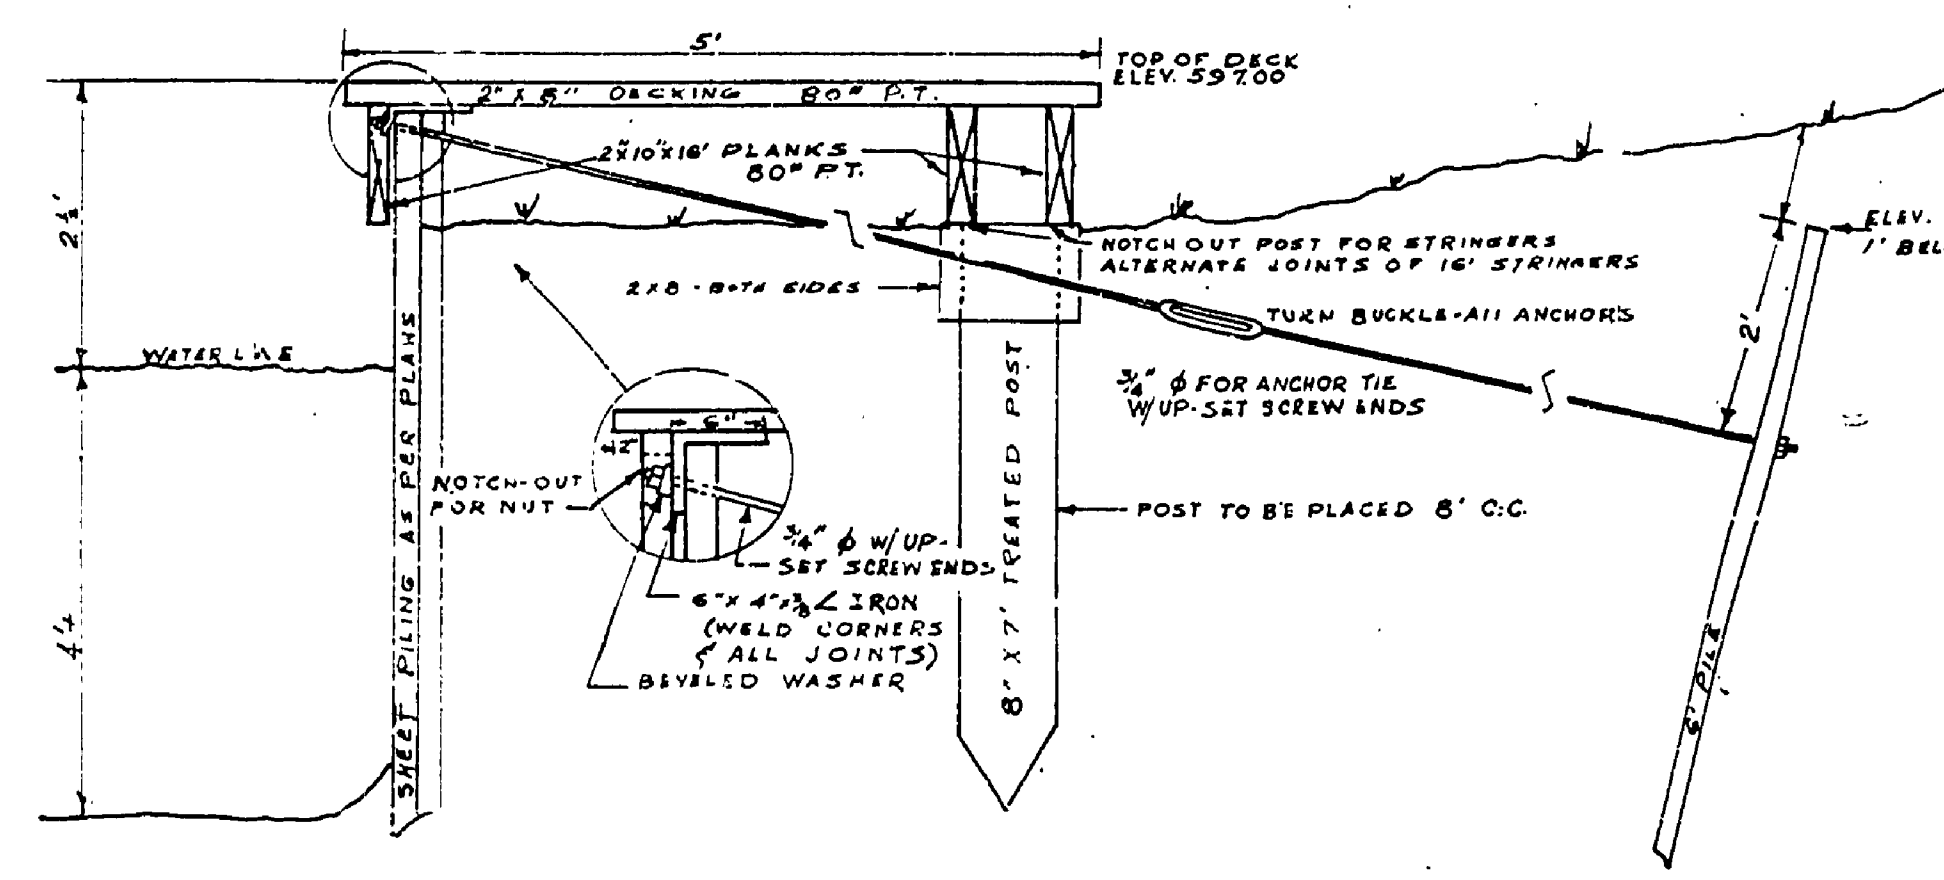


END DETAIL OF DOCK
 SCALE 3/4" - 1" 0"

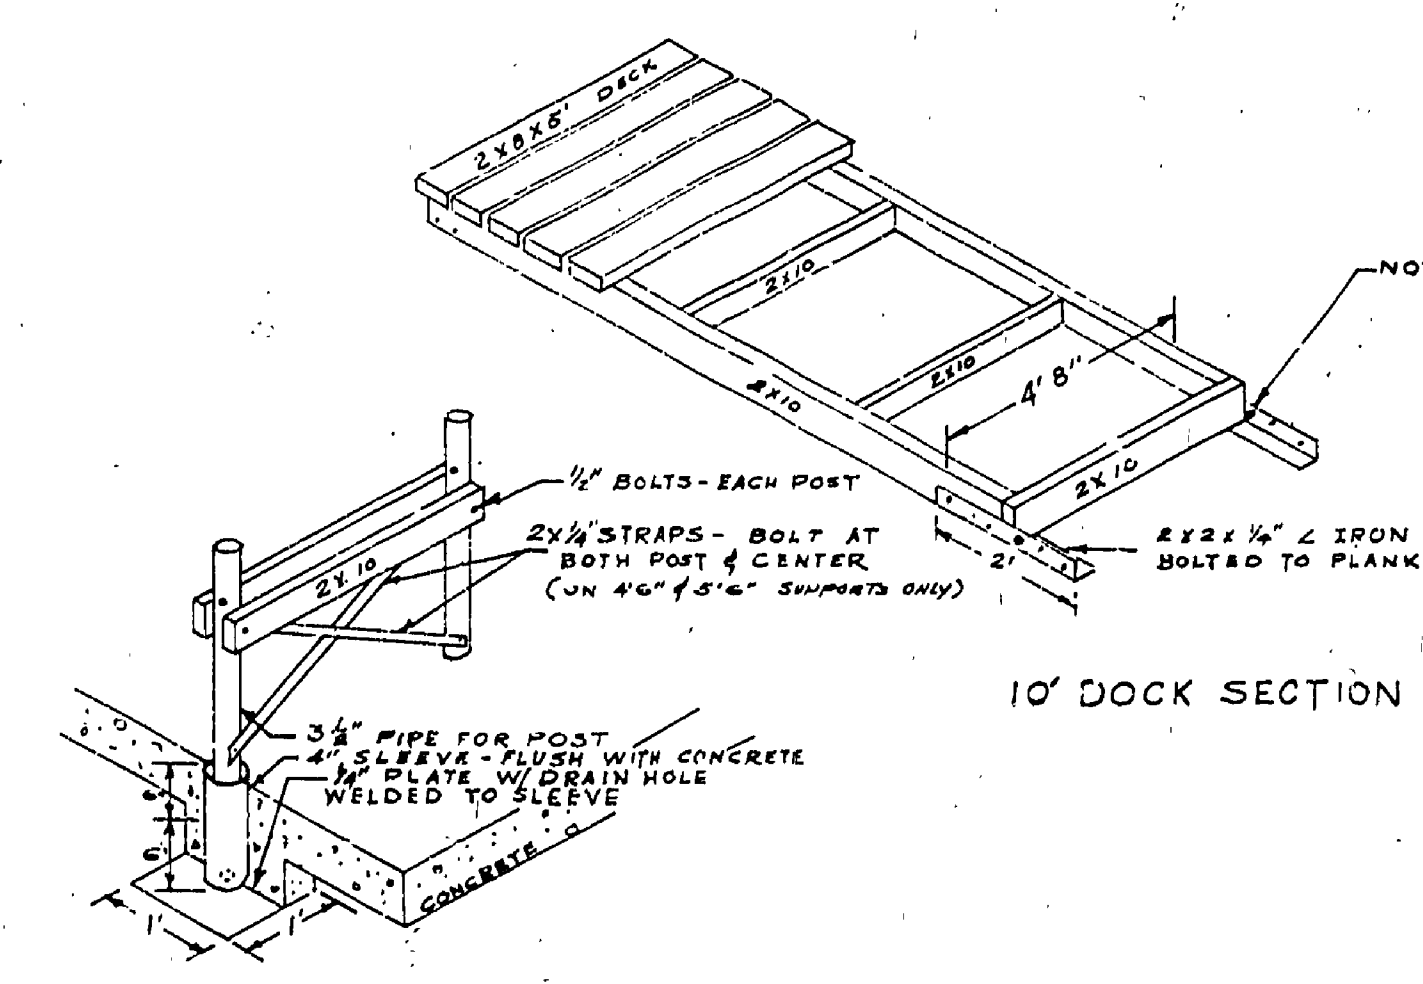

PORTABLE DOCK DETAILS
 NO SCALE

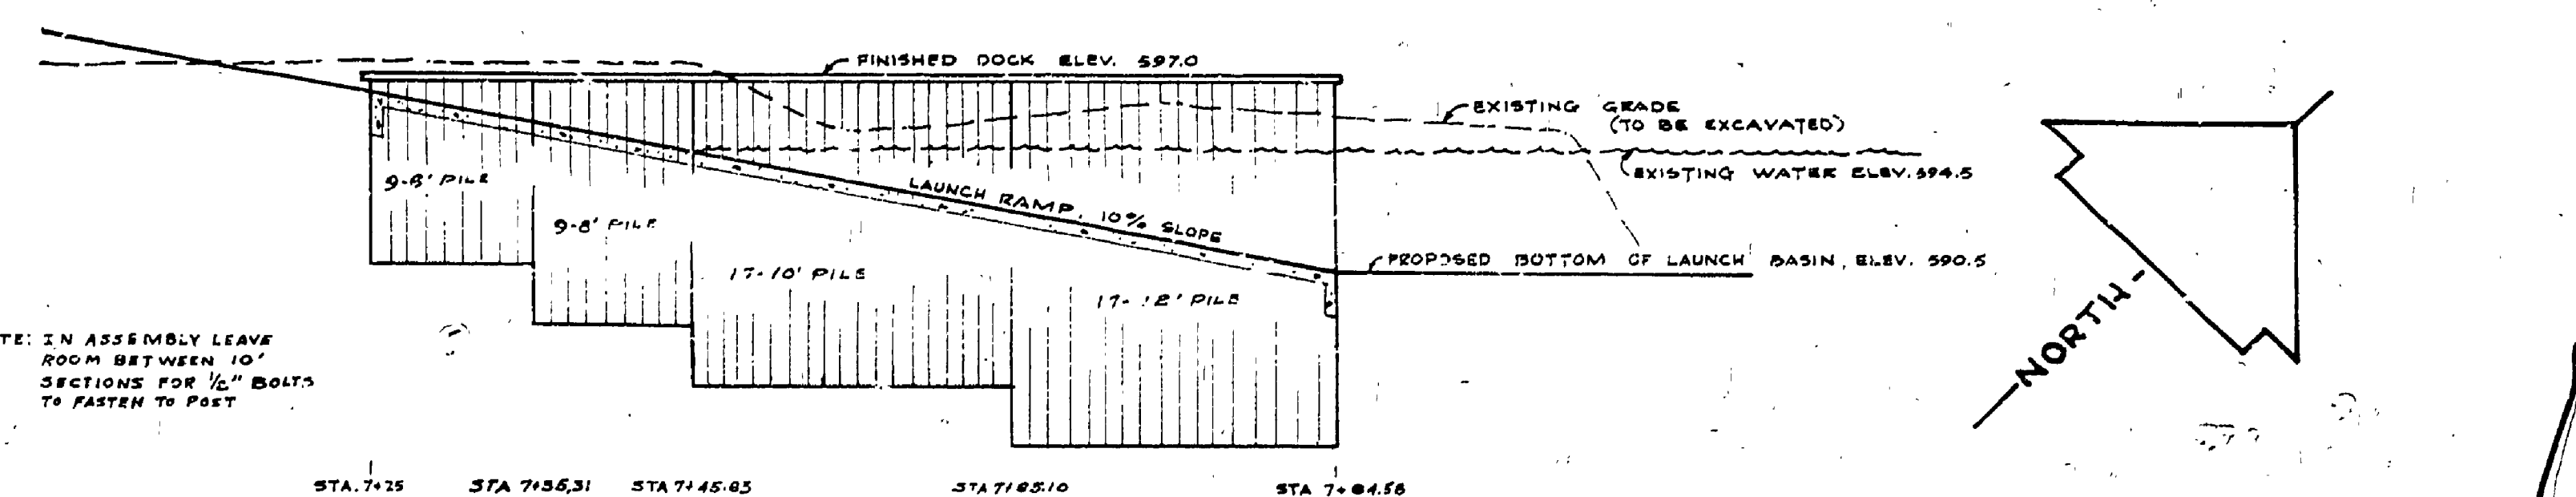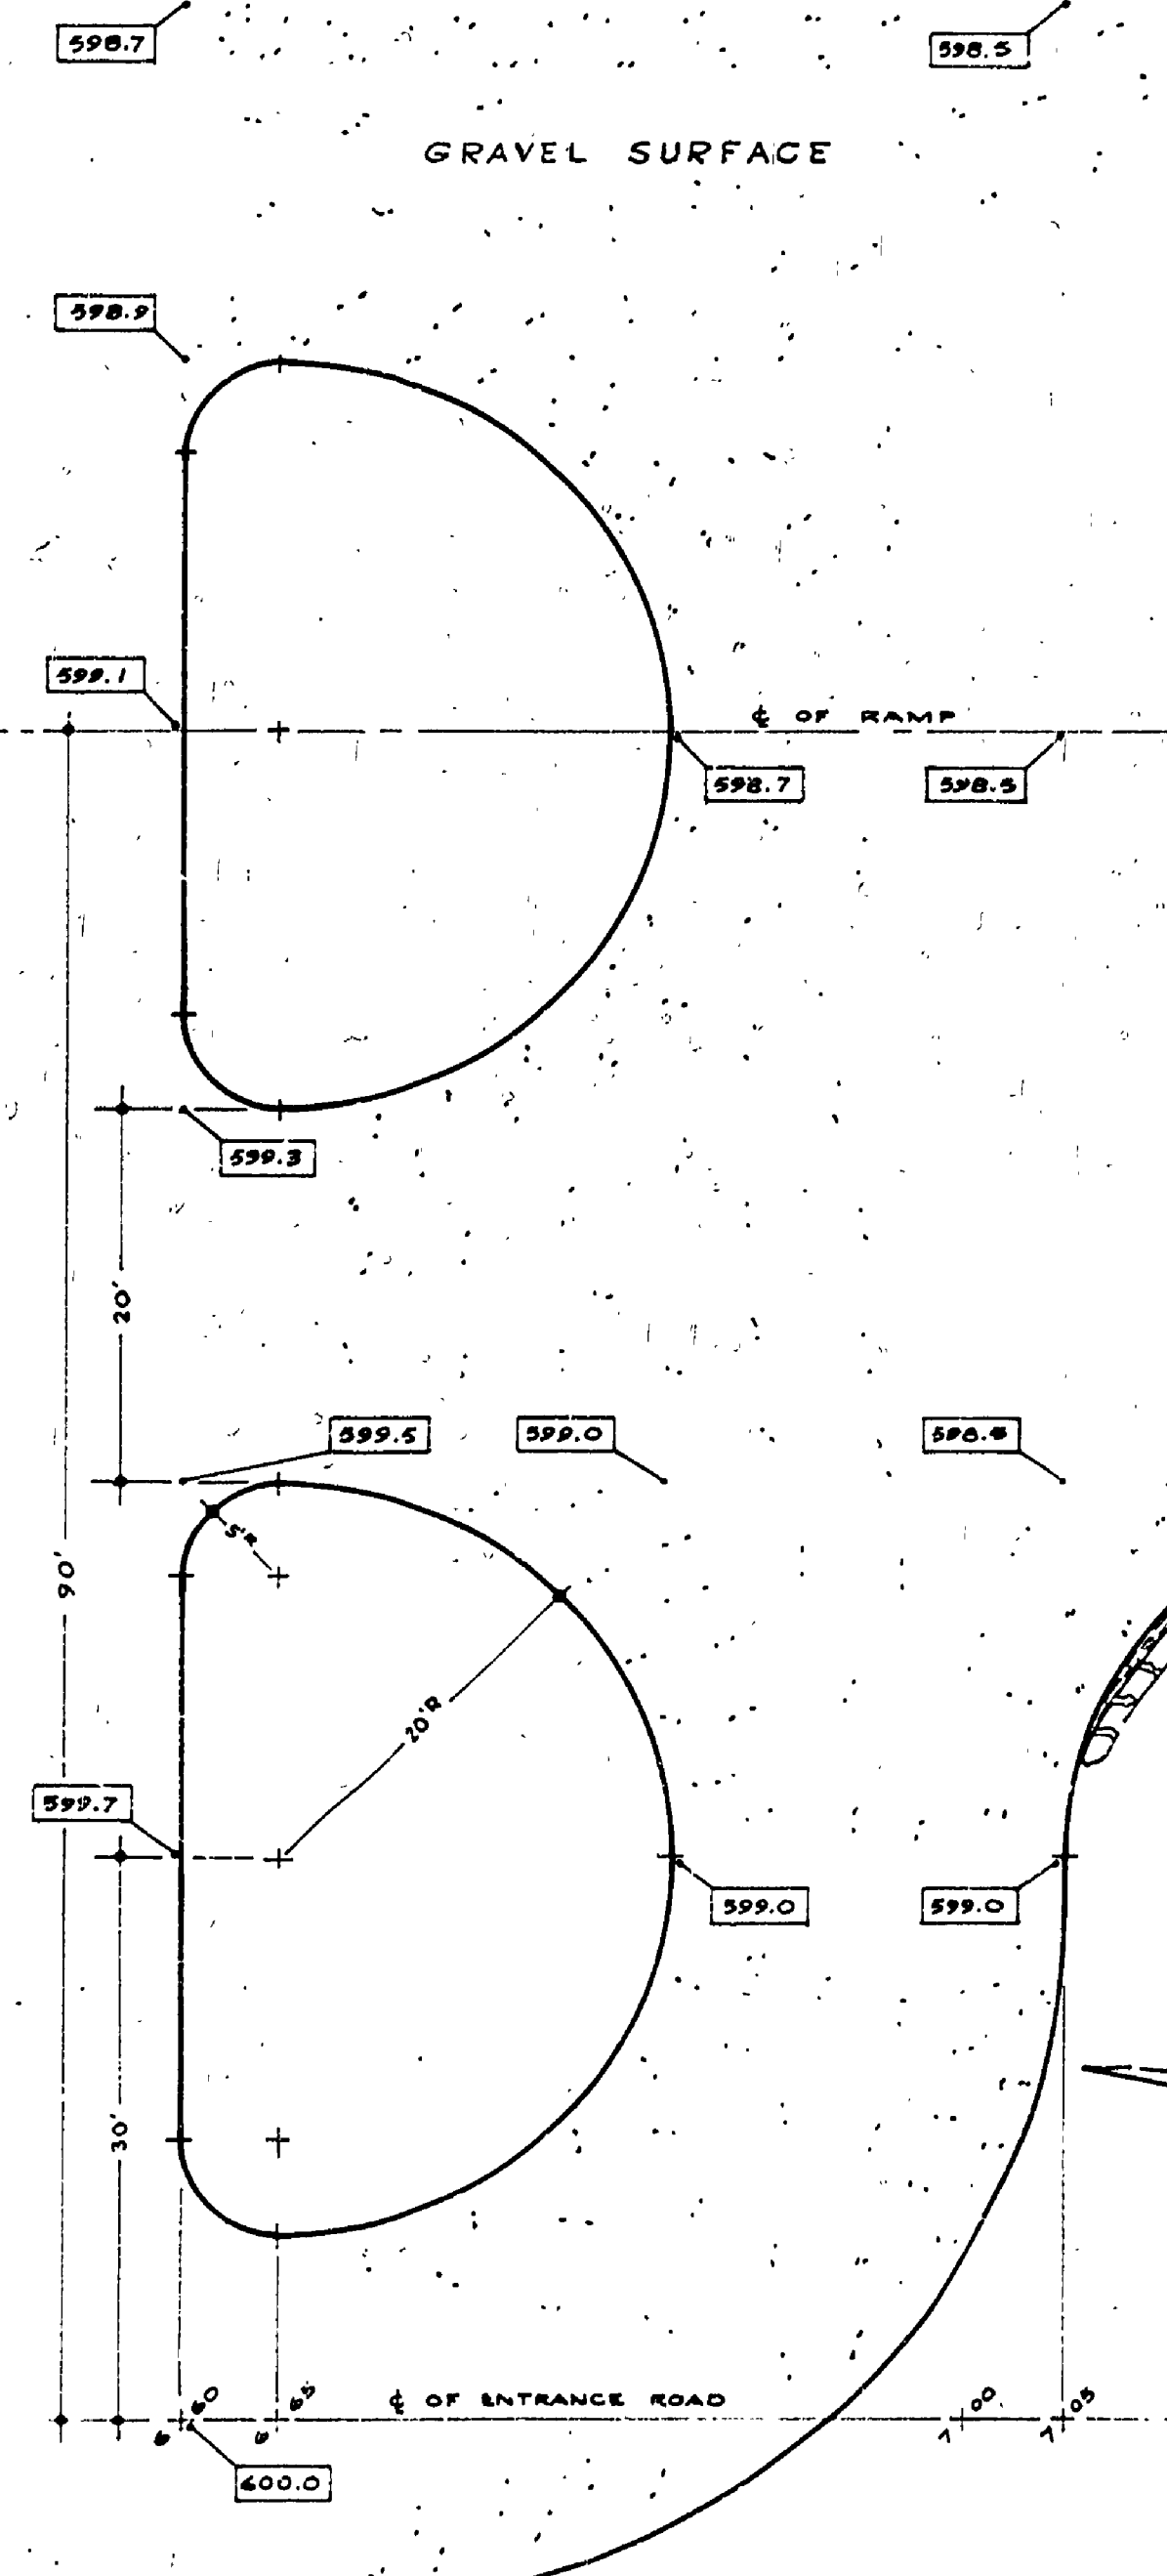

WEST DOCK DIAGRAM
 VERT. SCALE: 1" = 5', HORIZ. SCALE: 1" = 10'

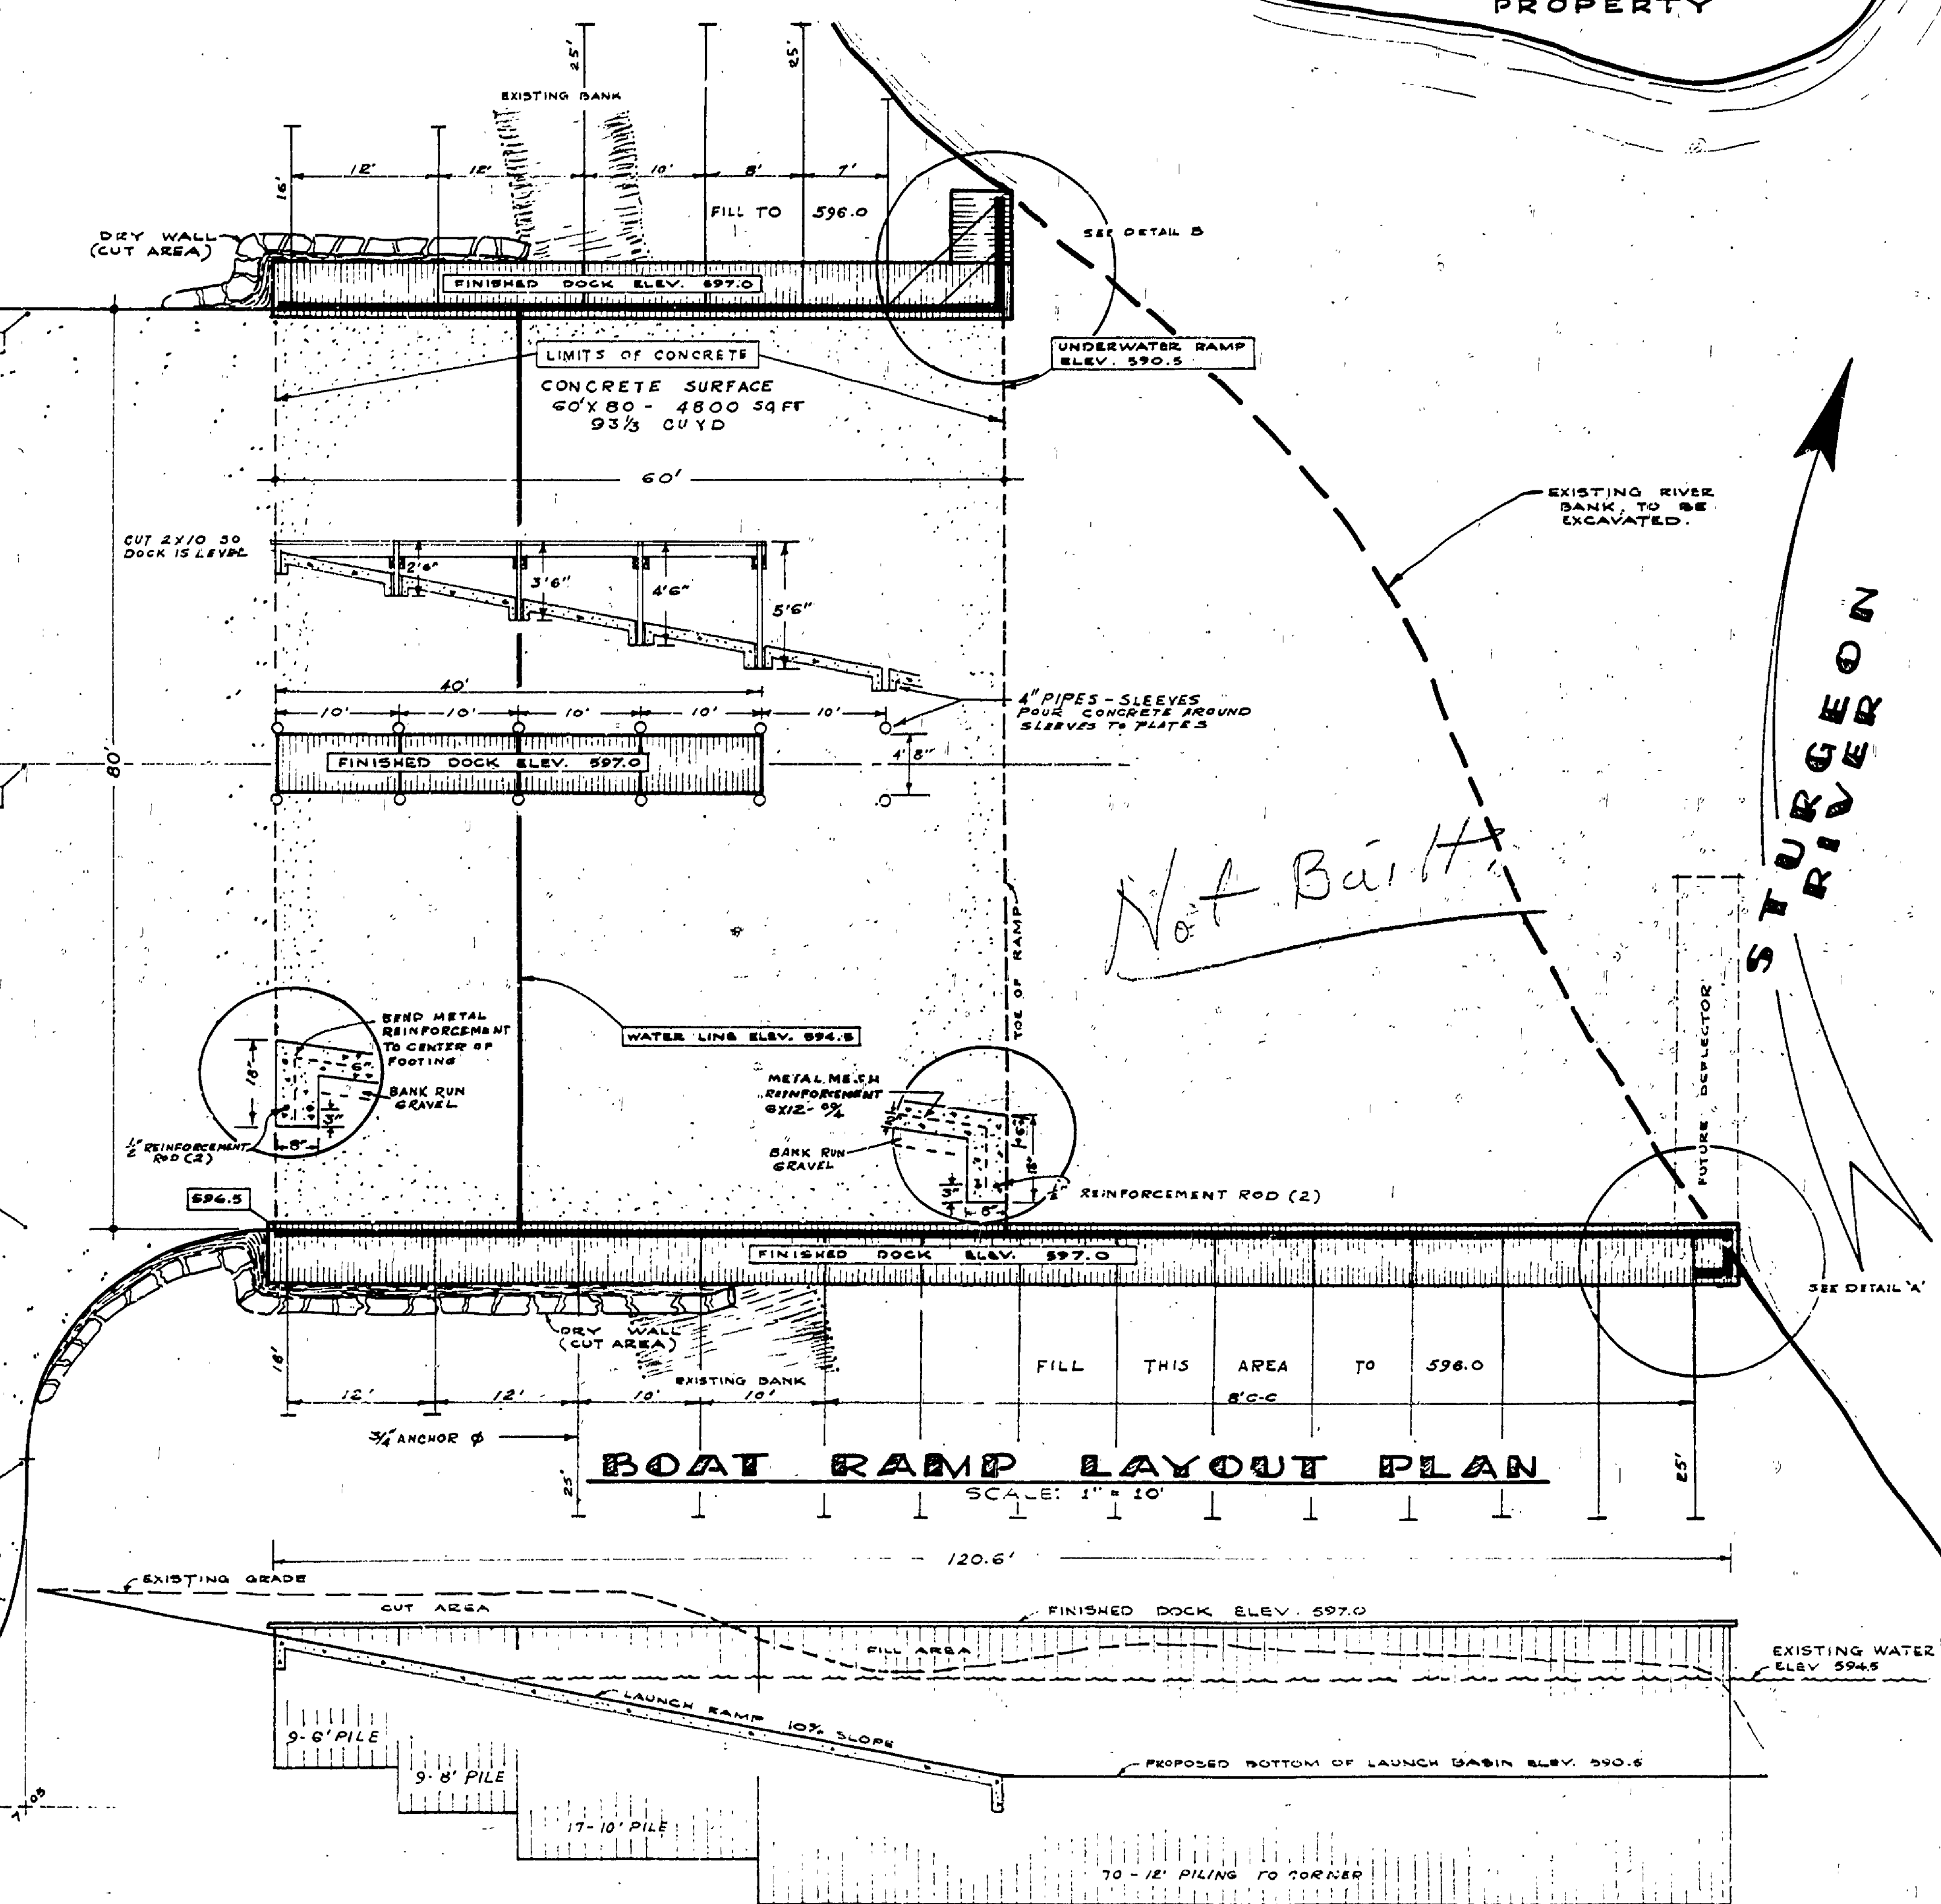

EAST DOCK DIAGRAM
 VERT. SCALE: 1" = 5', HORIZ. SCALE: 1" = 10'