


BURT LAKE

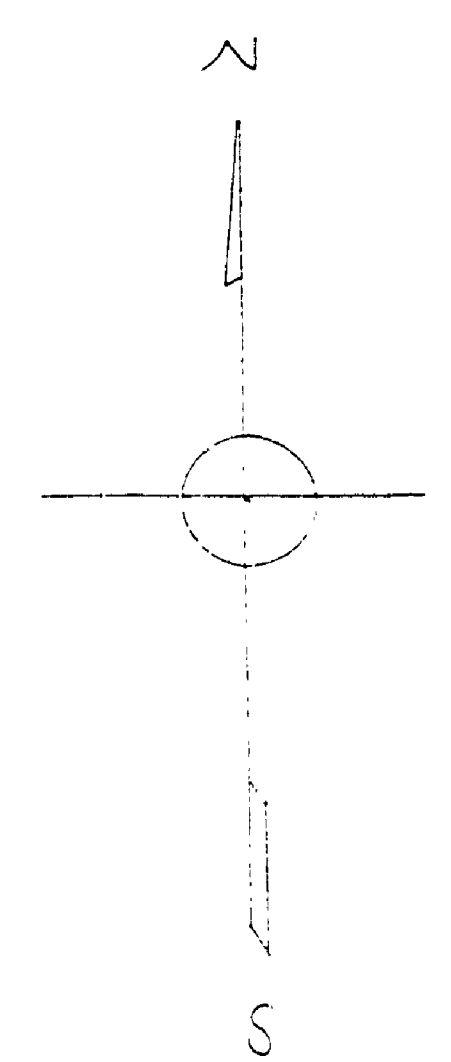

SHELTER - 200 AMP SWITCH
175 AMP FUSES

METER
TRANSFORMER BY MICHIGAN PUBLIC SERVICE CO.
PRIMARY CONNECTION
SECONDARY CONNECTION

PARKING AREA

DIGNITY

AREA

COUNTY ROAD

MICHIGAN PUBLIC SERVICE CO.

NOTE -
Dashed lines represent 1955 construction

LEGEND

- ===== TRAILER OUTLET LINE
- SERVICE LINE
- OUTLET, CONNECTED TO X SIDE OF 110-220 V. LINE
- 2/0 #4, 1-#6 6. COVERED W.P. 11/4 WIRES AND 1 1/2" BARE WIRE
- △ TRANSFORMER
- ⊙ METER

REVISION - 2/15/50
EAST HALF OF CAMP GRUNDUS

- KEY
- ===== Trailer Outlet Service Line
 - " " " " (CONSTRUCTED IN 1955)
 - Trailer Outlet Service Box
 - Pole
 - Anchor Guy

NOTE -
Use Heavy Service Secondary Racks
3 Wires - 6" spacing on 2/0-70 x 1-#2 WP Circuit.
On all other circuits use 2 wire - 6" spacing at end poles and 3 wire - 6" spacing at intermediate poles.

E-101

MICHIGAN DEPARTMENT OF CONSERVATION UNITED STATES		
DEPARTMENT OF THE INTERIOR NATIONAL PARK SERVICE COOPERATING		
DESIGNED BY R.R.B.	BURT LAKE STATE PARK	PLAN NO. 101
DRAWN BY R.R.B.	ELECTRICAL DISTRIBUTION	SCALE 1" = 100'
CHECKED BY	PLOT PLAN	DATE MAY 10, 1949
APPROVED BY	CHIEF, STATE PARKS DIVISION	DATE
ENGINEER BY	INSPECTOR	DATE