
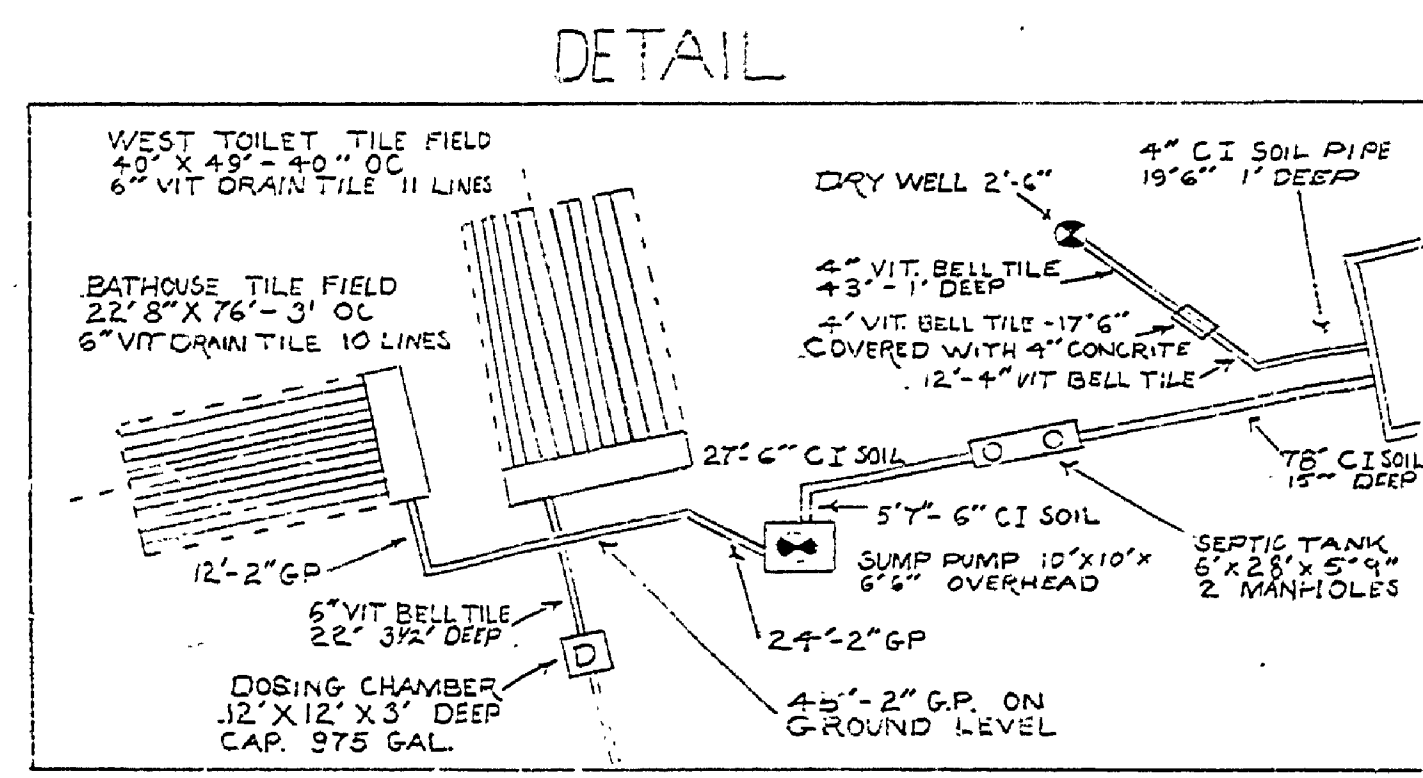


NO. DATE BY	REVISIONS	DATE BY
1	4	
2	5	
3	6	
APPROVED BY	DATE	DATE
ARCHITECTURAL		
ENGINEERING		
LANDSCAPE		
REVIEWED BY SECTIONS	DATE	DATE
ARCHITECTURAL		
ENGINEERING		
LANDSCAPE		
ASSISTANT CHIEF IN CHARGE	DATE	DATE
OF DESIGN		
DATE		

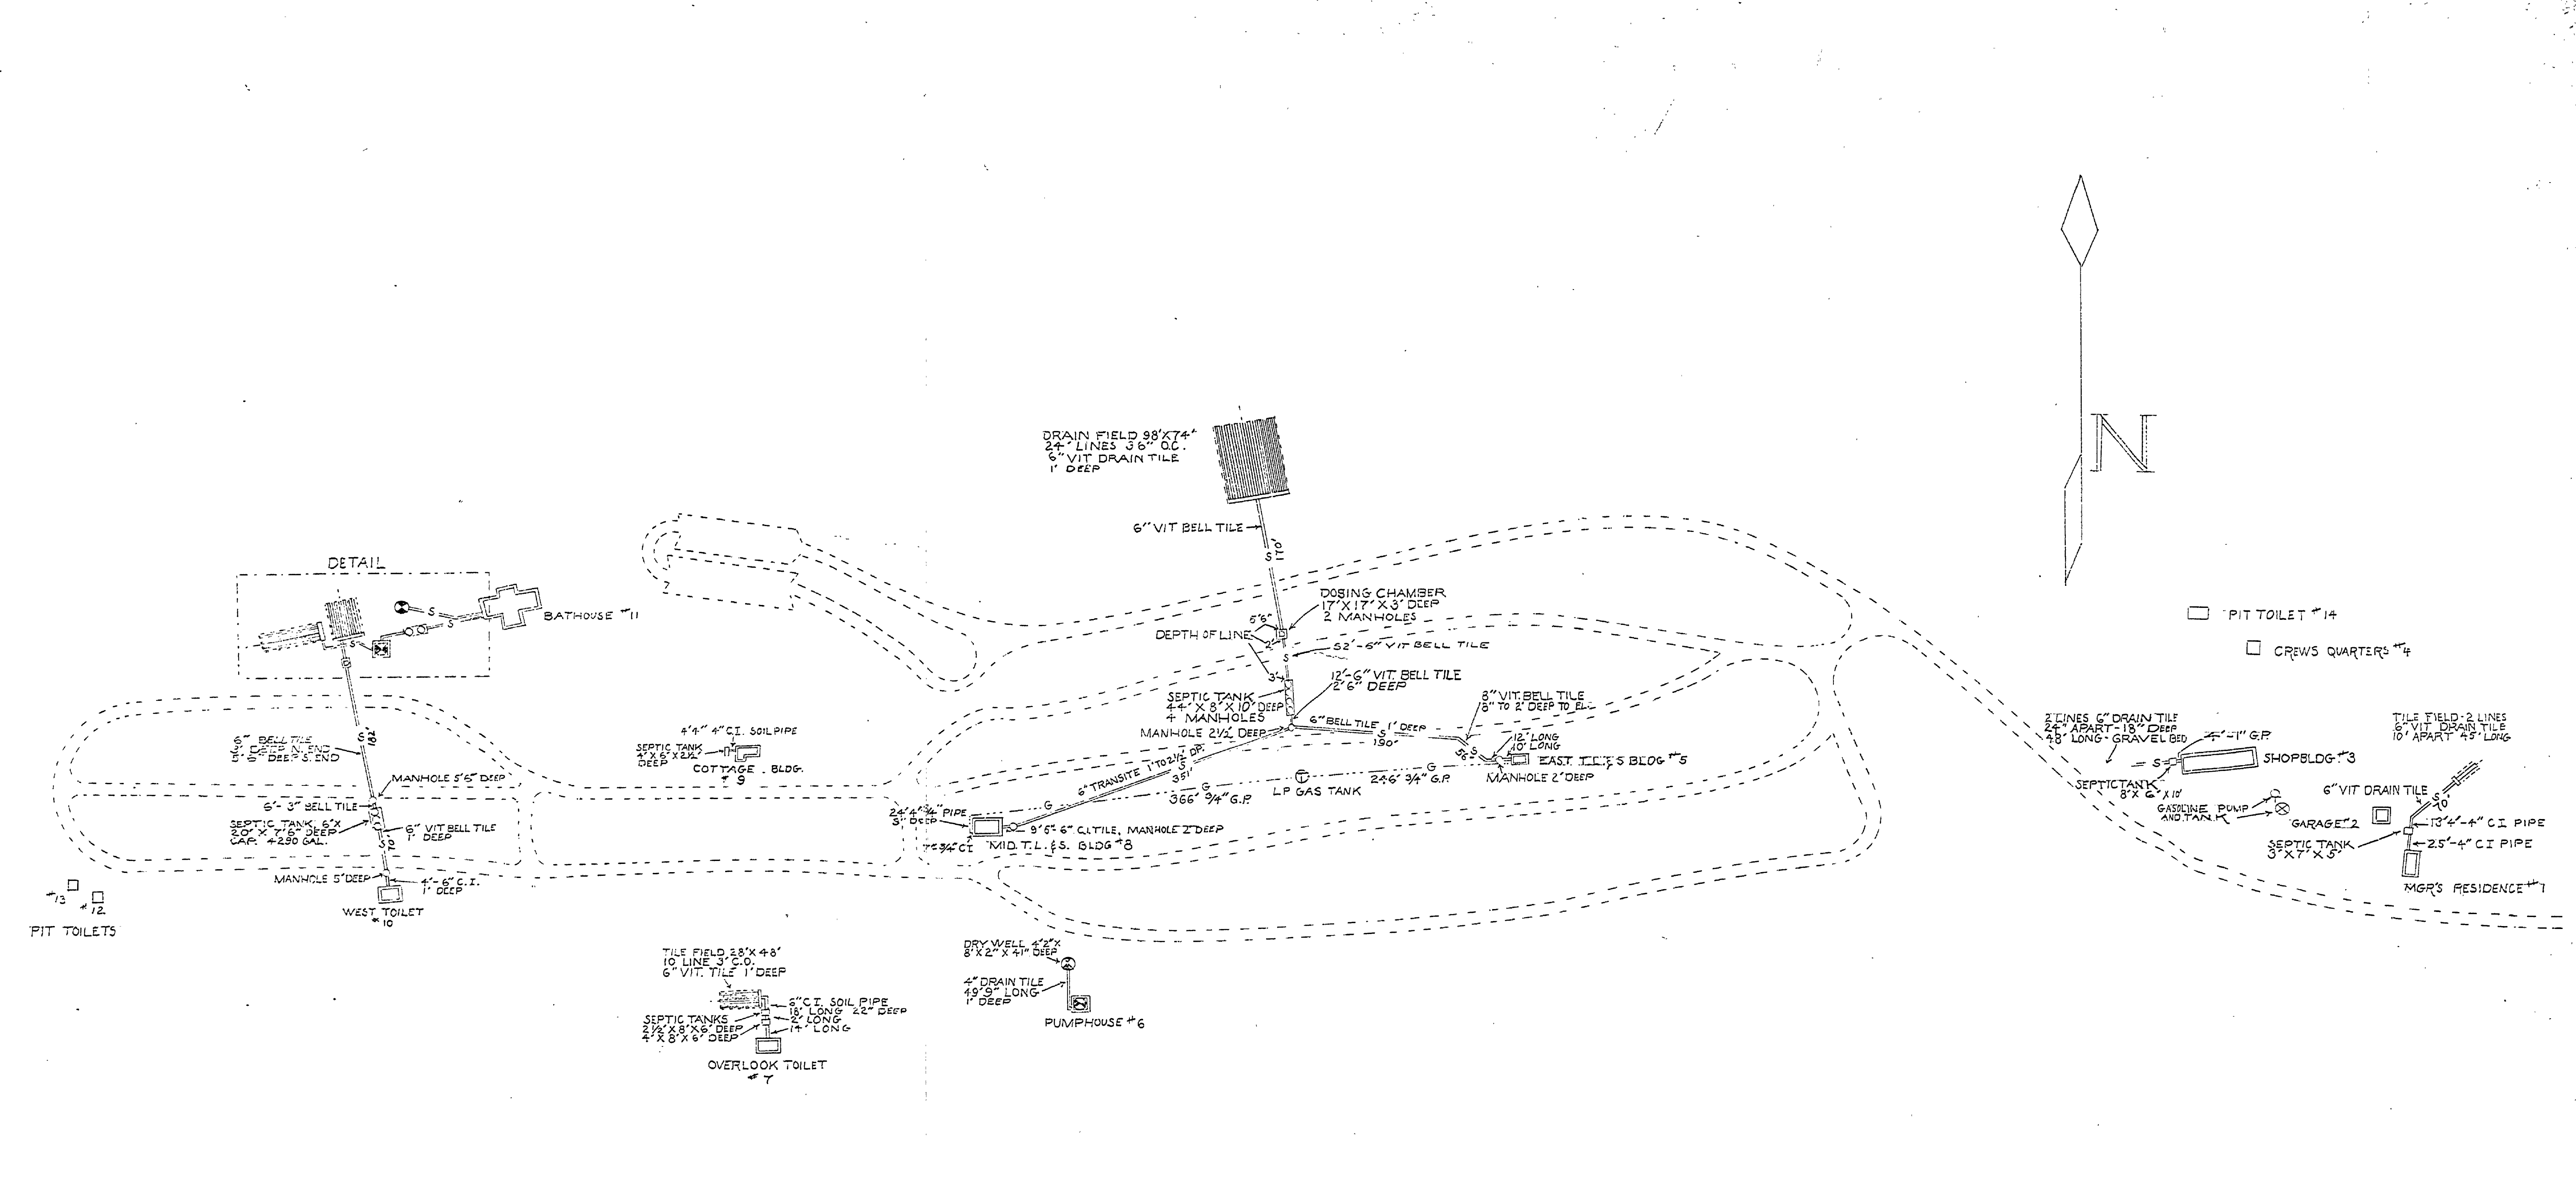

SYMBOL LEGEND

- PUMP
- WELL
- STORAGE TANK
- L P GAS TANK
- GASOLINE PUMP
- MANHOLE
- DOSING CHAMBER
- SEWER PIPE
- GAS LINE
- GALVANIZED PIPE
- VIT.
- C I

BUILDING LEGEND

- 1 MRG'S RESIDENCE 24'x36'
- 2 GARAGE 16'x20'
- 3 SHOP 26'x95'
- 4 CREW QUARTER 12'6"x16'
- 5 EAST T.L. & S. 26'x45'
- 6 PUMP HOUSE 8x8'
- 7 OVERLOOK TOILET 16'10"x24'6"
- 8 MID. T.L. & S. 24'x43'
- 9 COTTAGE 26'x36'
- 10 WEST TOILET 20'7"x26'
- 11 BATHHOUSE 32'x66'
- 12 PIT TOILET 6'x10'
- 13 " " 6'x10'
- 14 " " 5'x5'

LP GAS TANK - 500 GAL. - LEASED FROM PET GAS CO.
 GASOLINE TANK - 500 GAL. STATE OWNED

PUMP MOTOR #1 JACU221 - TYPE - 1/2 HP - SPEC - A - 1 HP - 1750 RPM - WYG 105
 GE - TRI-CLAD CAPASITOR MOTOR - MODEL 12F5813 - TYPE K C
 ECONOMY PUMPING MACHINERY CO. #84100
 BALDOR - TYPE X.2B - SPEC - 955 - 1/2 HP - 1725 RPM #D4390

BURT LAKE STATE PARK

SCALE 1" = 100'

MICHIGAN DEPARTMENT OF CONSERVATION PARKS AND RECREATION DIVISION

BURT LAKE UTILITY MAP SEWER & GAS DISTRIBUTION

SHEET NO. 1 OF 3

PLAN NO. U-1