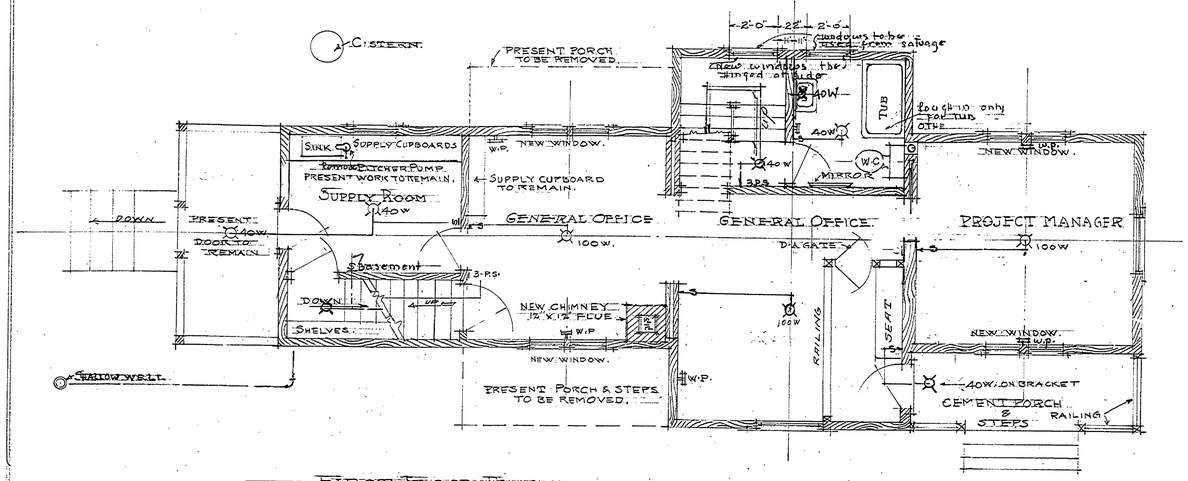

FIRST FLOOR PLAN

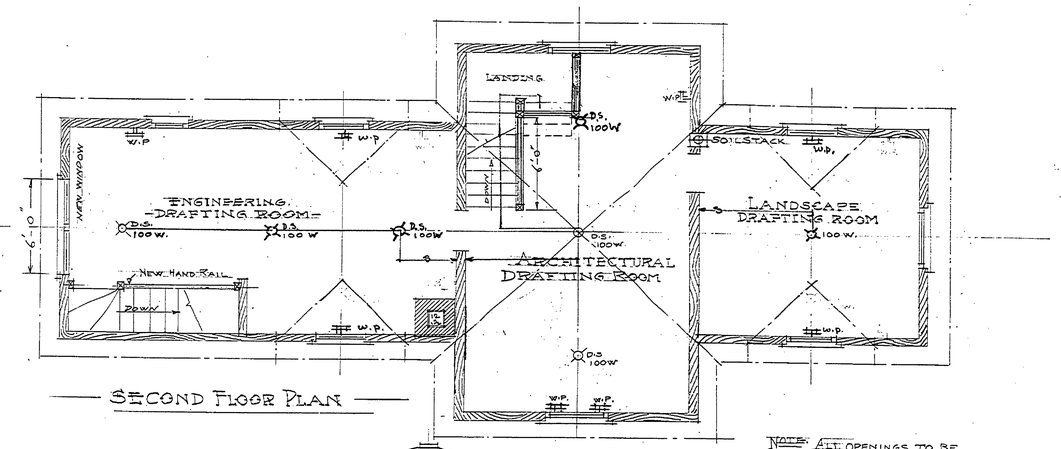

SECOND FLOOR PLAN

NOTE: ALL OPENINGS TO BE EQUIPPED WITH STORM SASH OR DOORS.

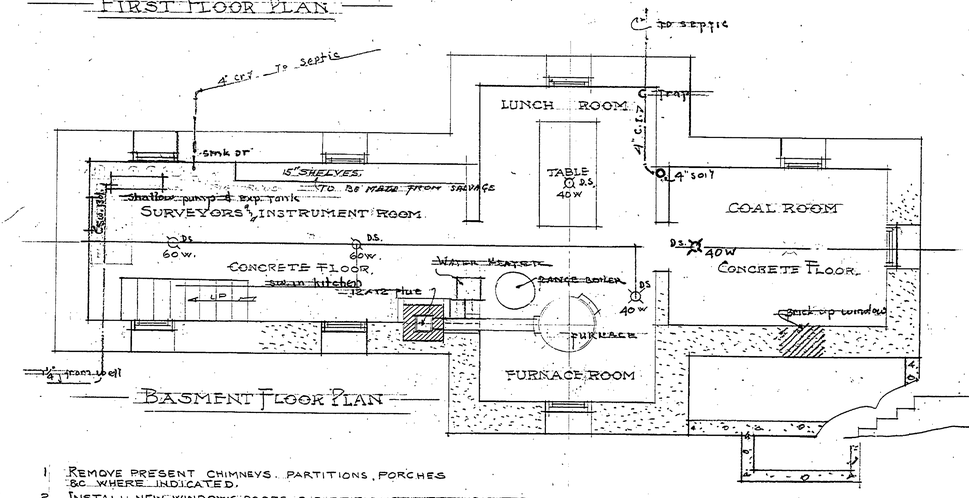

BASEMENT FLOOR PLAN

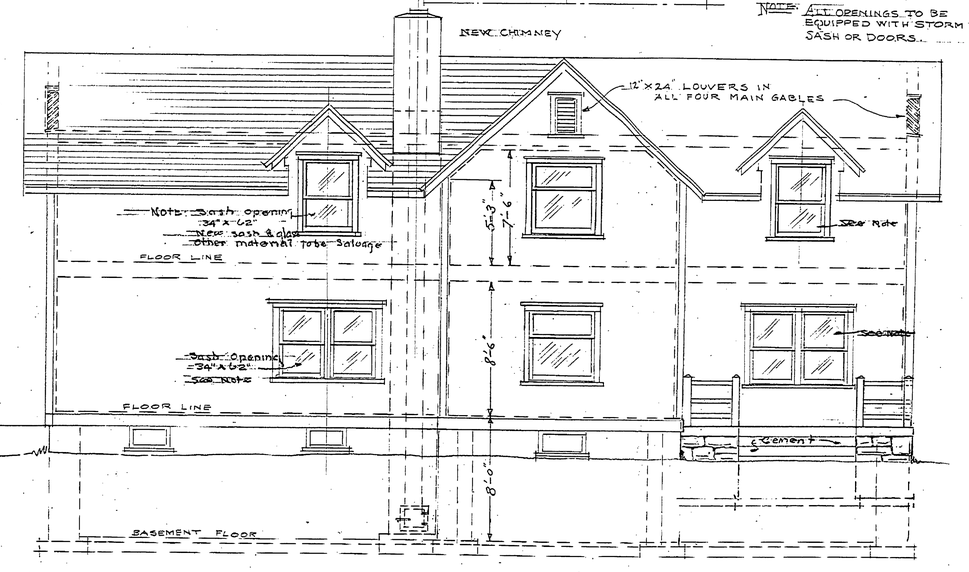

EAST ELEVATION

1 REMOVE PRESENT CHIMNEYS, PARTITIONS, PORCHES &C WHERE INDICATED.
2 INSTALL NEW WINDOWS, DOORS & PARTITIONS WHERE INDICATED.
3 INSTALL NEW CHIMNEY WITH 12"X12" FLUE WHERE INDICATED.
4 INSTALL NEW FURNACE COMPLETE WITH HEATING DUCTS REGISTERS RECIRCULATING DUCT & GRILL, ASBESTOS DUCT COVERING WITH GRATES, DAMPERS, CONNECTION TO FLUE ETC. COMPLETE.
5 INSTALL COMPLETE WIRING SYSTEM & LAMPS AS INDICATED.
6 INSTALL STORM SASH ON ALL OPENINGS, SASH & DOORS
7 REPAIR ALL PLASTERING, PAINTING, DECORATING WHERE NECESSARY. TO COMPLETE JOB IN WORKMAN LIKE MANNER.

PLAN of BUILDING (RE-BUILT)

JOB 5 APR DEC. 30-37
REVISED 4/29/37 BATH & WATER PUMP HEATING

UNITED STATES
DEPARTMENT OF THE INTERIOR
NATIONAL PARK SERVICE
CO-OPERATING WITH
MICHIGAN CONSERVATION DEPARTMENT

Drawn By E.W.G.	YANKEE SPRINGS	Plan No. 9016-A
Designed By E.P.H.	PROJECT OFFICE	Scale 1/4"=1'-0"
Checked By E.P.H.	GRAPHIC SCALE 100 200 300 400 500	RDP-MI-6
		Date 4/29/37
Prepared By	State Park Authority or Sponsor	Date
Recommended	Superintendent	Date 5/5/37
Recommended	Regional Officer	Date
Approved By	Assistant Director	Date

INSURANCE No. 1.

#1

4-105 A

Job #5