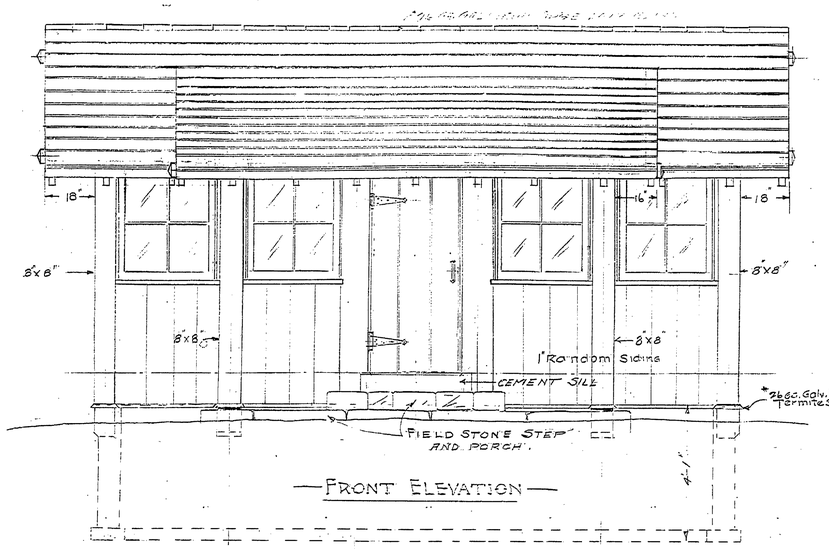

FRONT ELEVATION

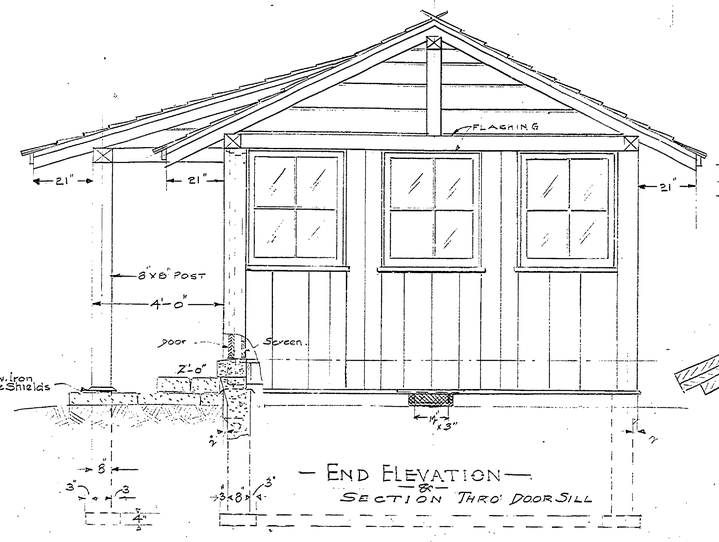

END ELEVATION
SECTION THRO' DOOR SILL

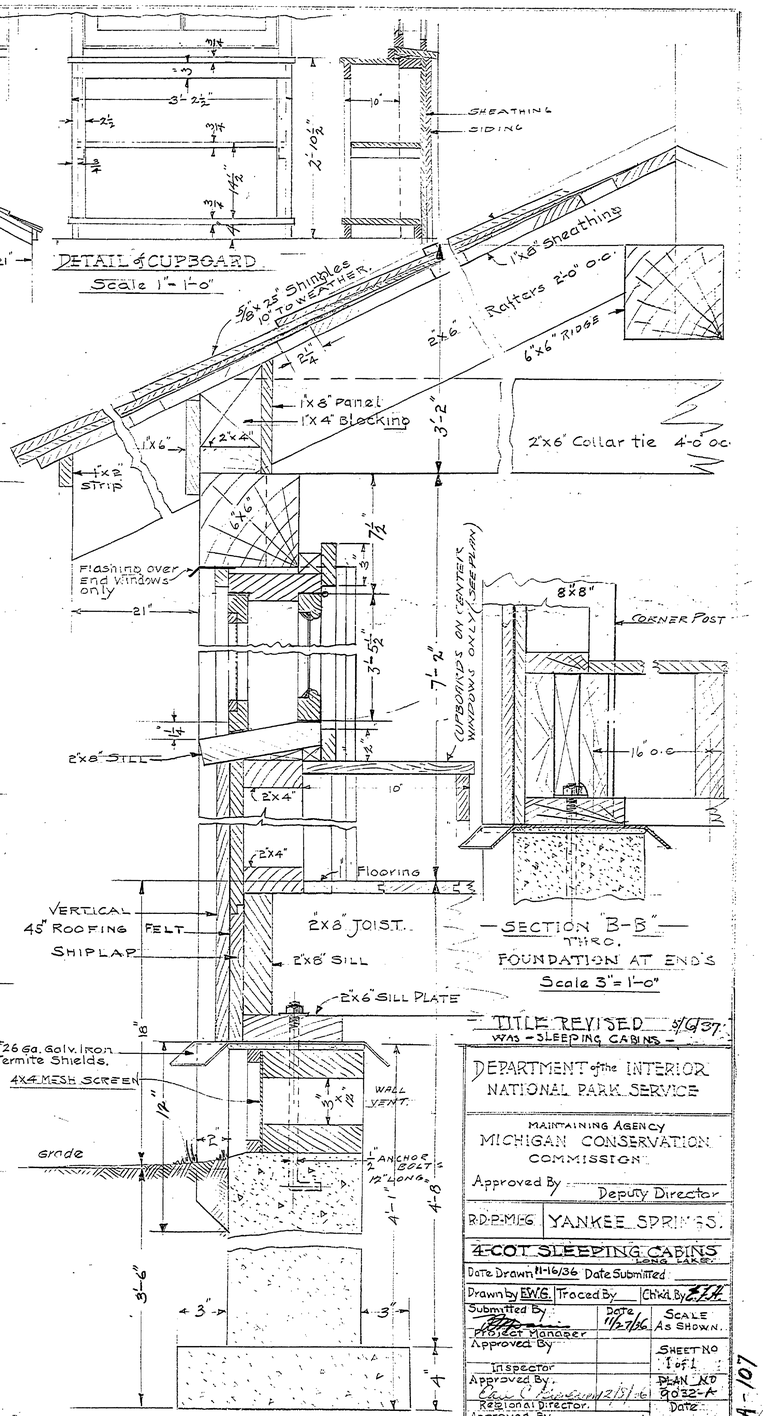

DETAIL of CUPBOARD
Scale 1" = 1'-0"

SECTION "B-B"
THRO.
FOUNDATION AT END'S
Scale 3" = 1'-0"

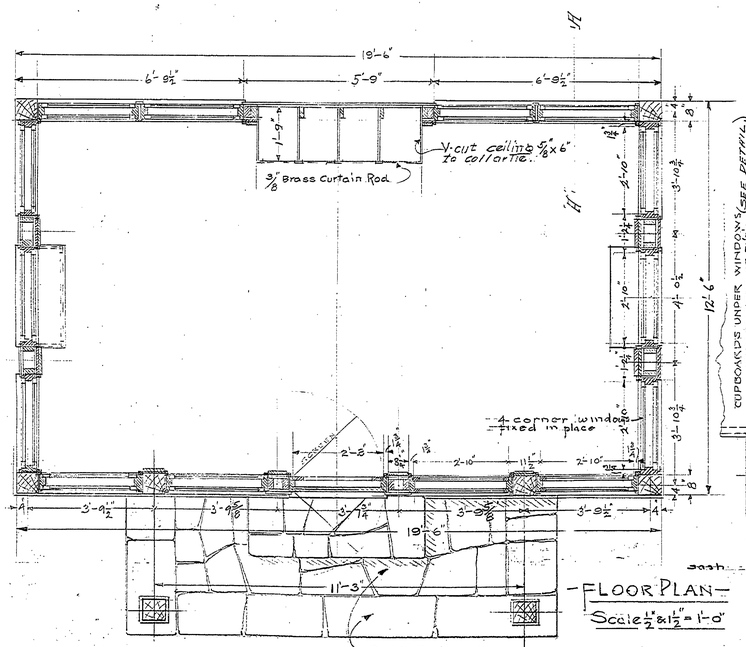

FLOOR PLAN
Scale ½" & 1½" = 1'-0"

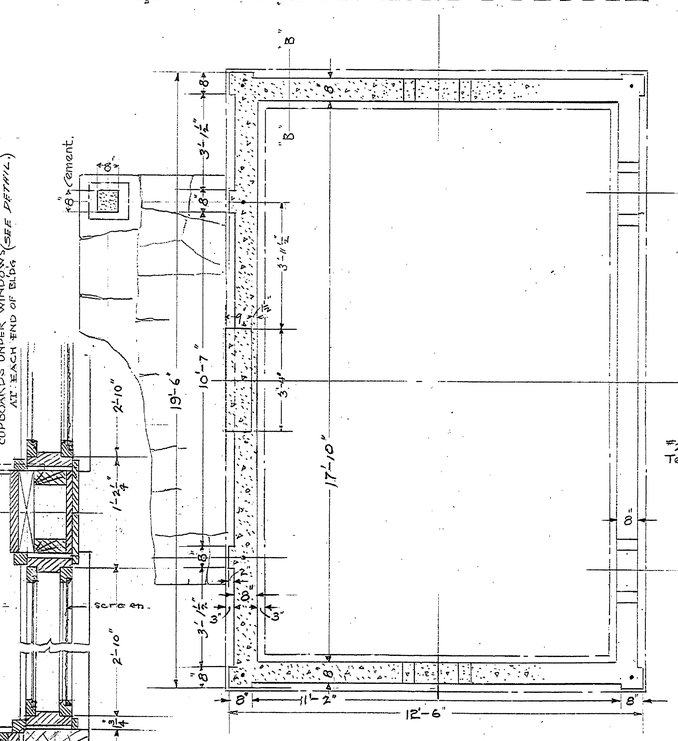

FOUNDATION PLAN

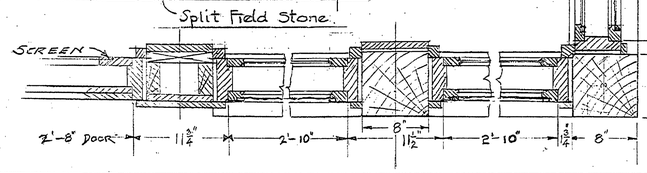

#25 to #48 WALL SECTION "A-A" Rev. 3/14/37

TITLE REVISED 5/6/37
WAS - SLEEPING CABINS -

DEPARTMENT of the INTERIOR
NATIONAL PARK SERVICE

MAINTAINING AGENCY
MICHIGAN CONSERVATION COMMISSION

Approved By Deputy Director

R.D.P.M.F.G. YANKEE SPRINGS.

4-COT SLEEPING CABINS
LONG LAKE

Date Drawn 11-16/36	Date Submitted	
Drawn by E.W.G.	Traced By	Ch'k'd By
Submitted By	Date 11/27/36	Scale As Shown.
Project Manager Approved By		Sheet No 1 of 1
Inspector Approved By		Plan No 9032-A
Regional Director. Approved By		Date

A-107

INSURANCE No. 25 to No. 48 Job #2