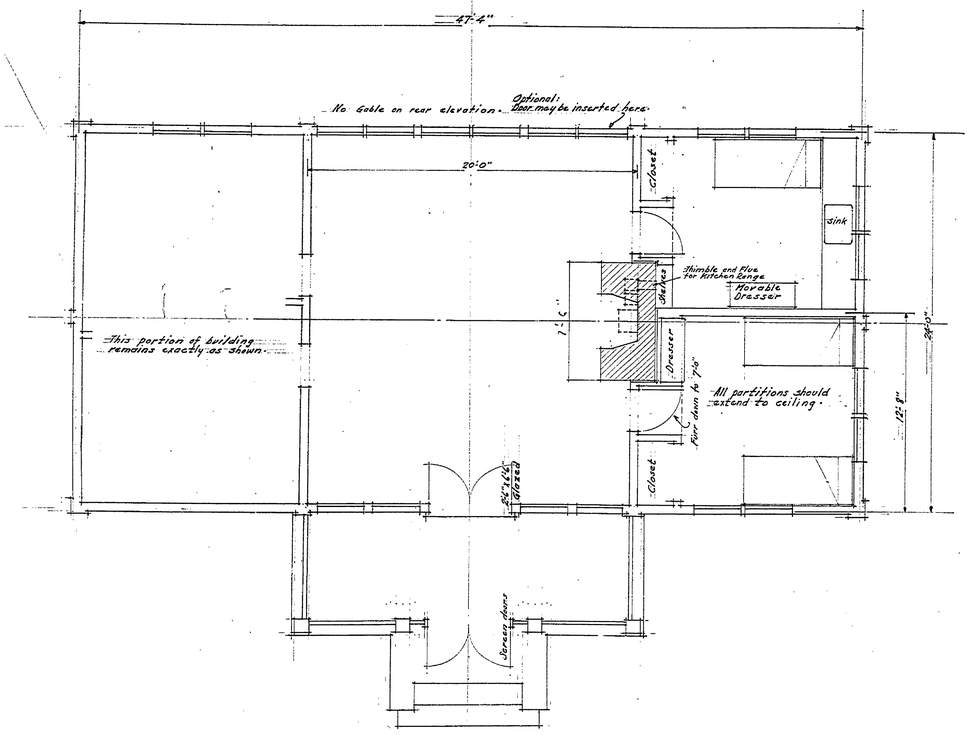

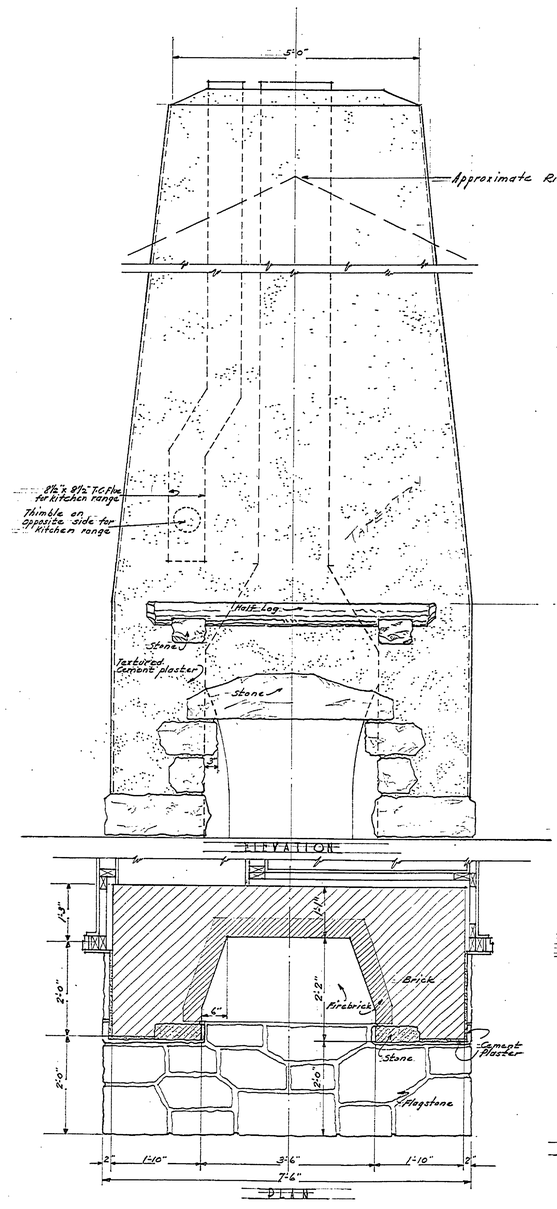

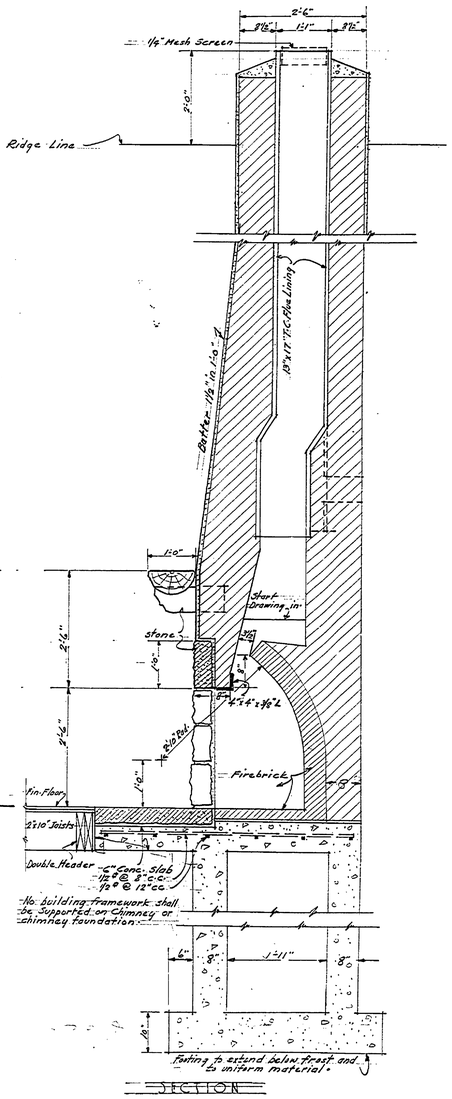

SUGGESTED ALTERATIONS TO
STATE QUARTERS
YANKEE SPRINGS
POND PARK
MICHIGAN-RDP-MI-6

REVISION TO PLAN No. 90-14 DATED 5/25/54

REGIONAL OFFICE REVISION - JULY 13, 1954
SCALE 3/4"=1'-0"

INSURANCE No. 57 # 57

Job # 74 A-115