



FRONT ELEVATION
Scale - 1/4" = 1' 0"

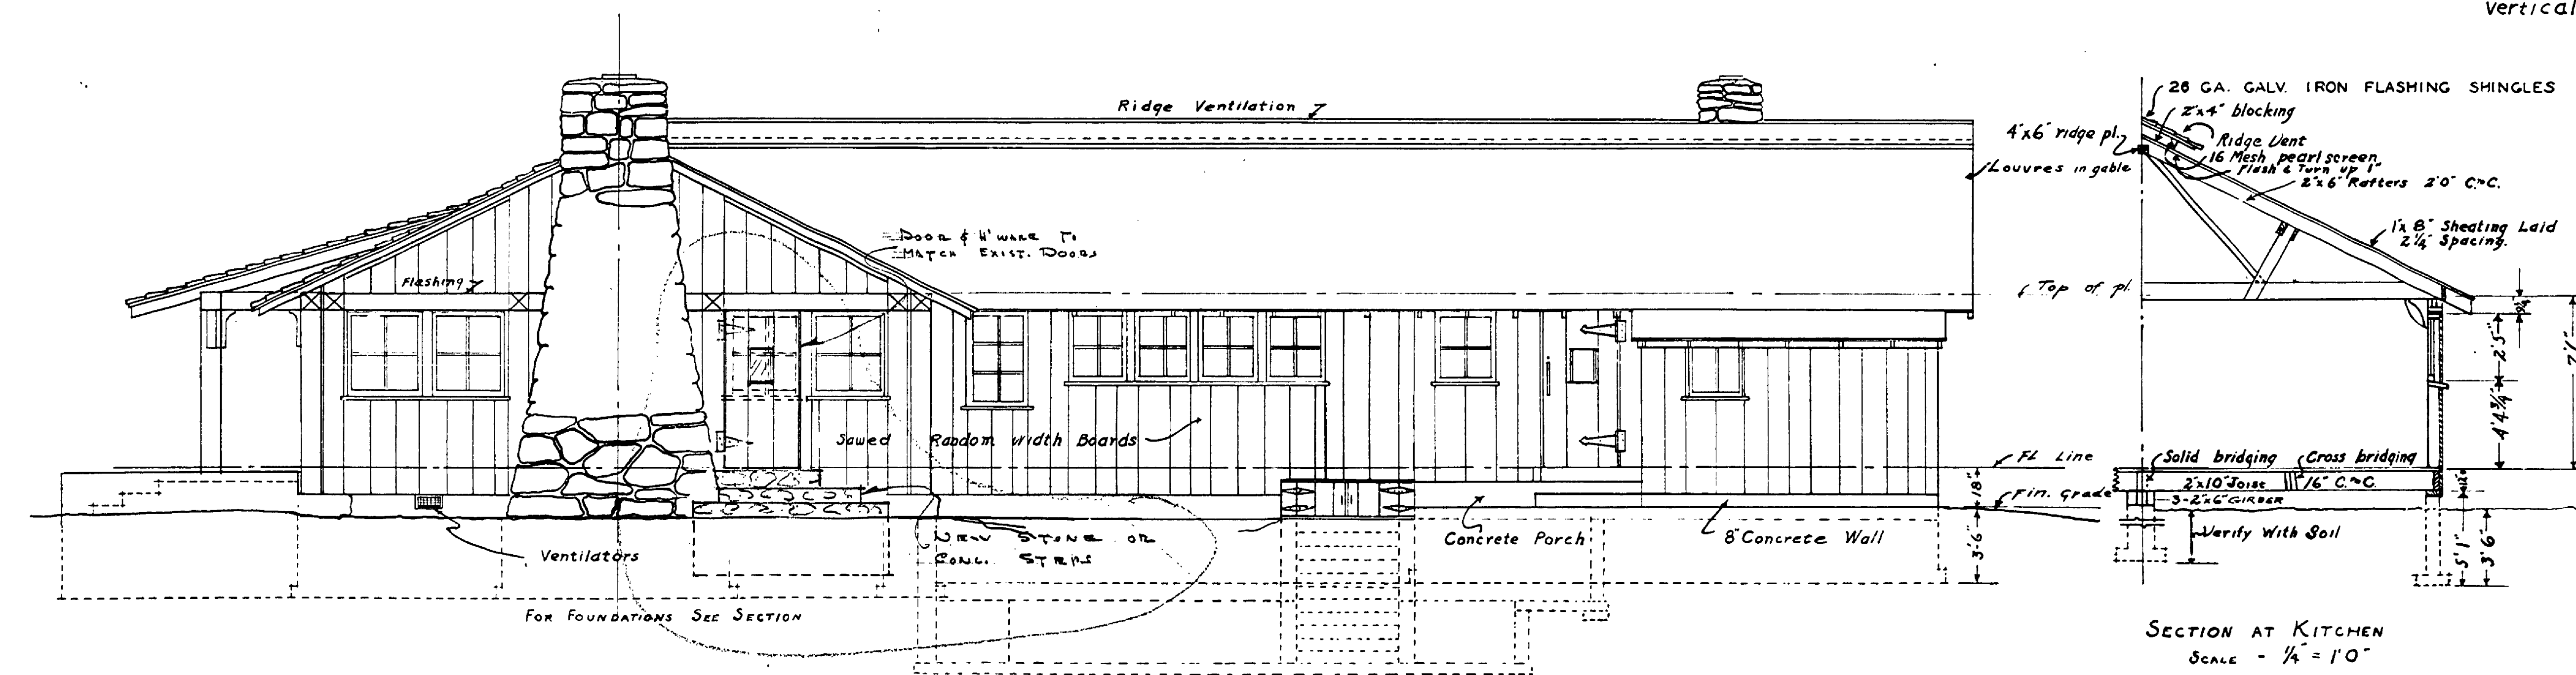

SIDE ELEVATION
Scale 1/4" = 1' 0"

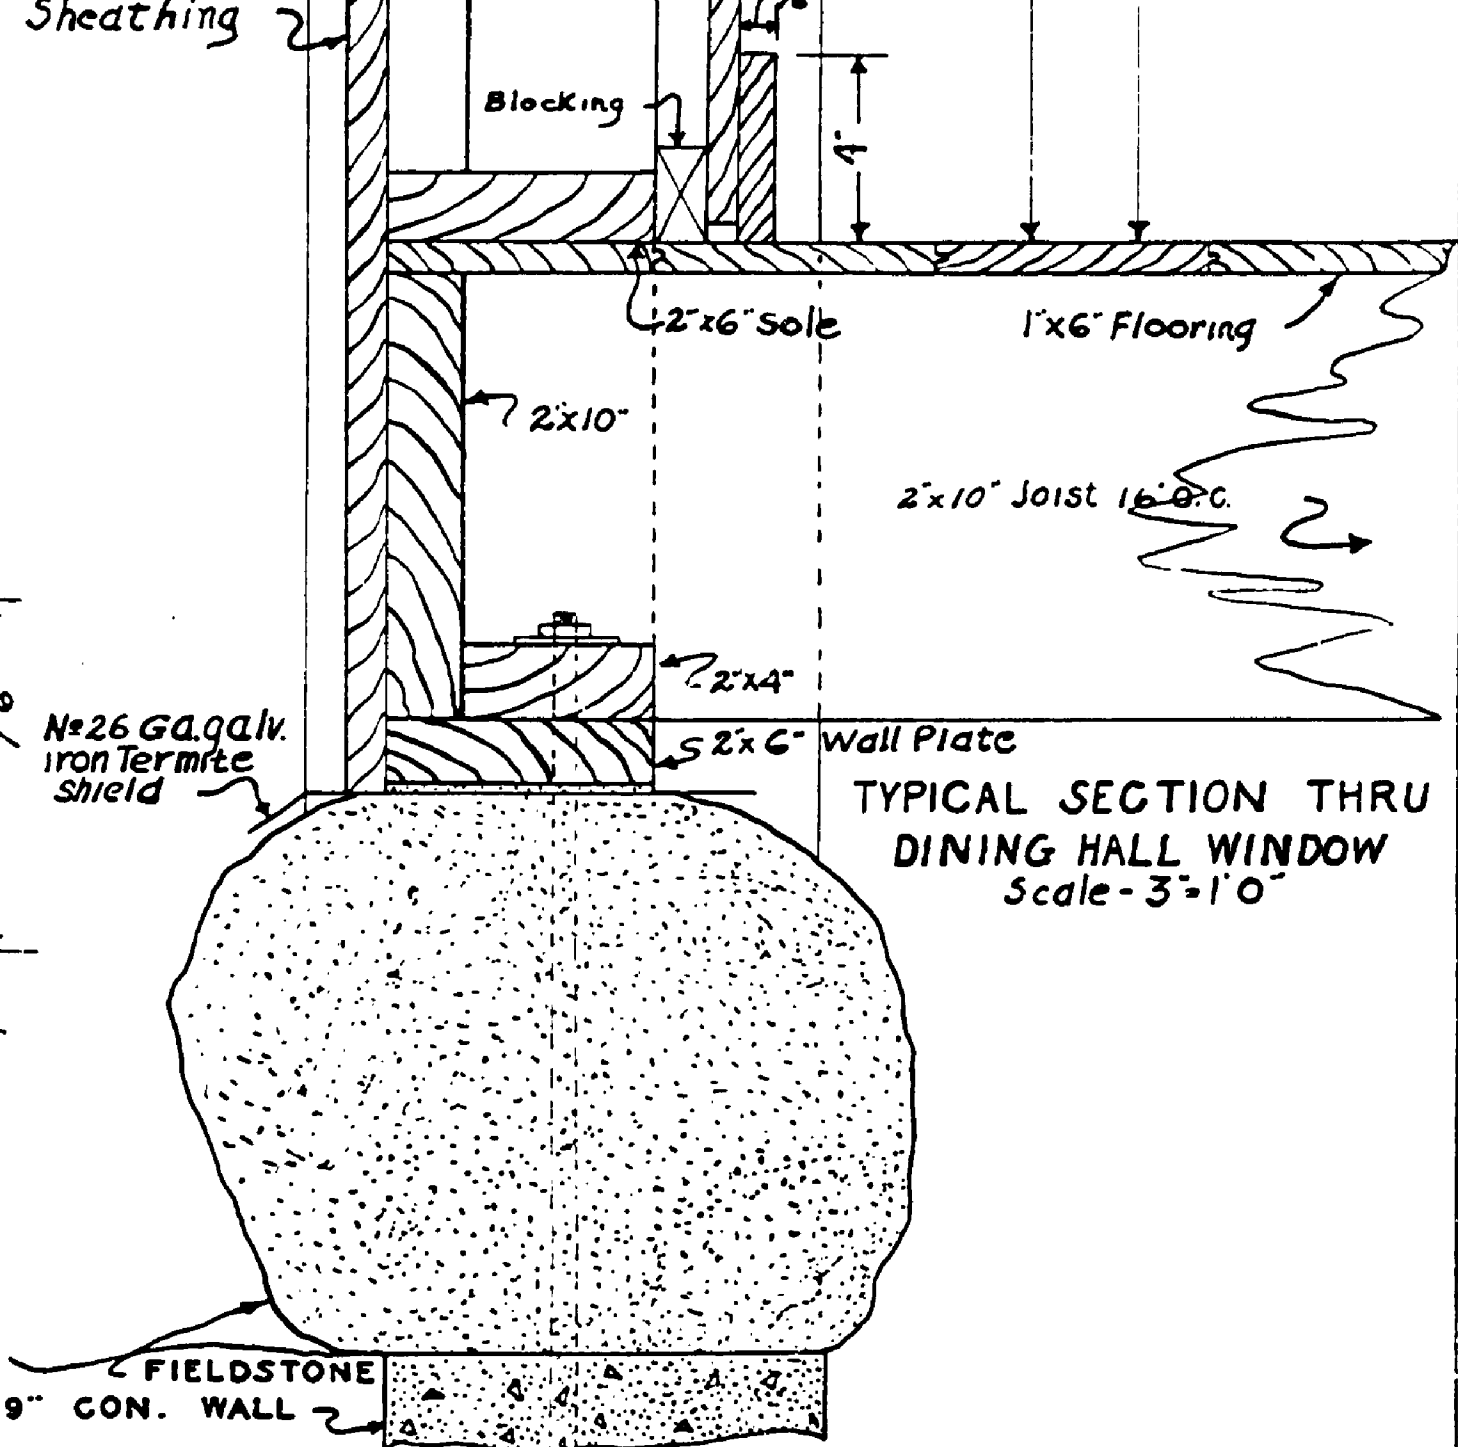

TYPICAL SECTION THRU DINING HALL WINDOW

MICH. DEPT. OF CONSERVATION IN COOPERATION WITH UNITED STATES DEPARTMENT OF THE INTERIOR NATIONAL PARK SERVICE			
DRAWN BY	YANKEE SPRINGS PROJECT	PLAN NO.	90-14
DESIGNED BY	DINING HALL & KITCHEN	SCALE	1/4" = 1'
CHECKED BY	JOB NO. 14	LD-MI-6	DATE 4-7-38
APPROVED BY	PARK AUTHORITY OR SPONSOR	DATE	
INSPECTOR		DATE	

ADDED DOOR IN SIDE
2-2-60
TRACED
DATE 2/2/62 BY A.L.C.

INSURANCE No. 75

A-126