YANKEE SPRINGS RECREATION AREA

BEACHHOUSE CONCESSION BUILDING

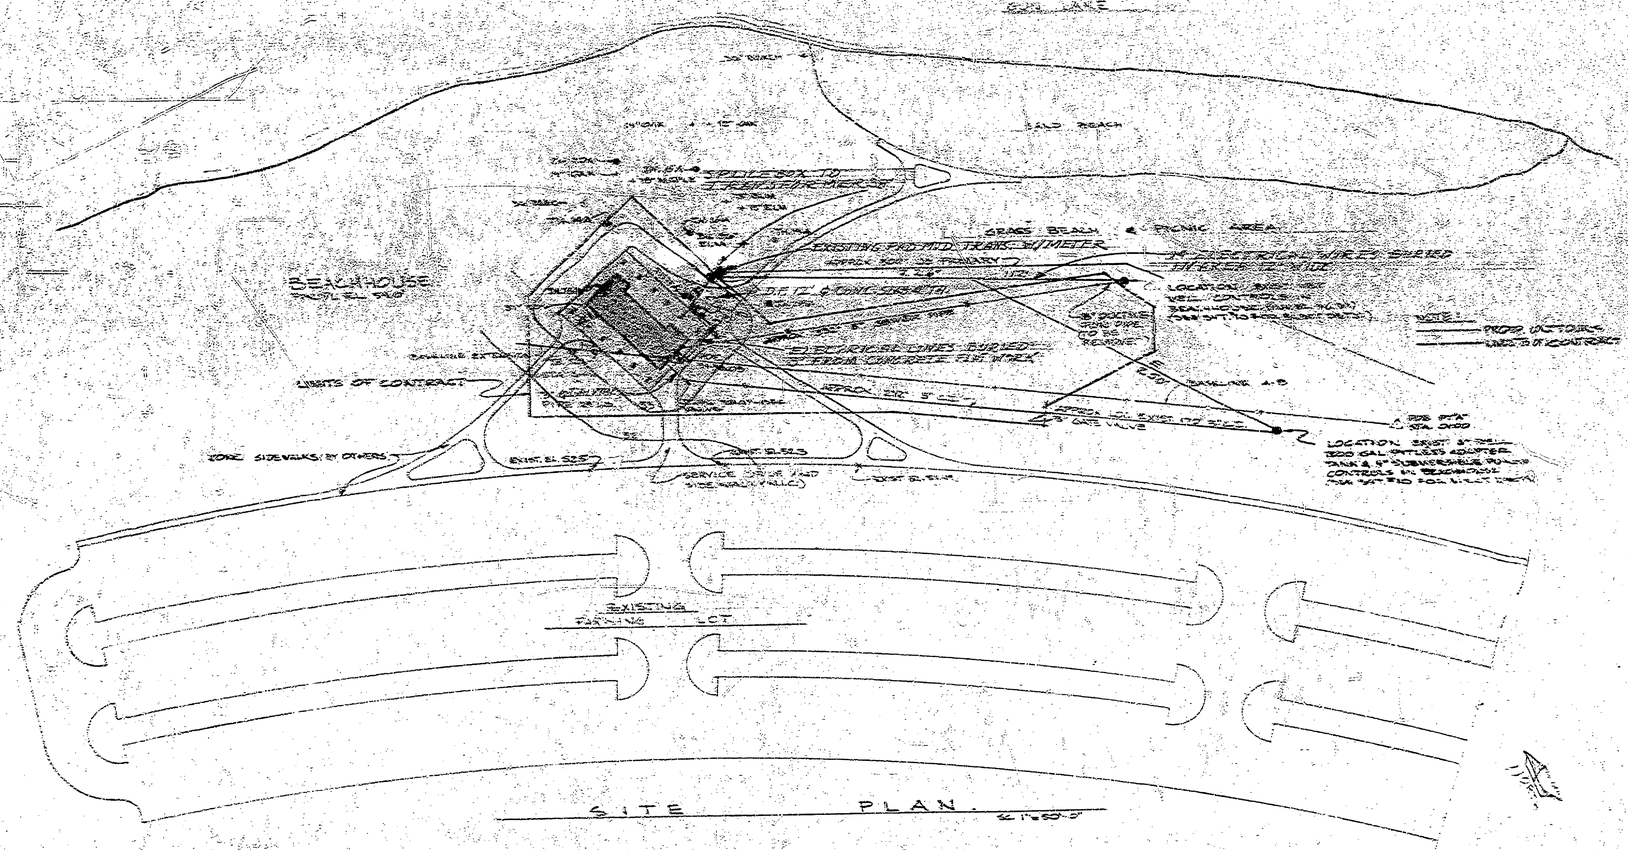

1	INFORMATION
2	SITE PLAN
3	FOUNDATION PLAN
4	FLOOR PLAN
5	ROOF FRAMING PLAN
6	SECTIONS & DETAILS
7	EXTERIOR ELEVATIONS
8	CONCESSION SCHEDULE & EQUIPMENT PLAN
9	WATER, SANITARY SYSTEM & PLUMBING FIXTURES DETAIL
10	MECHANICAL PLUMBING
11	ELECTRICAL

BUILDING COMMITTEE APPROVAL
BY: DATE: 8/25/66
RECOMMENDED FOR APPROVAL:
RECOMMENDED FOR APPROVAL:
DIRECTOR'S FINAL APPROVAL
BY:
APPROVED:

SUBMITTED BY		DRAWN BY		NO.	DATE	BY	REVISIONS	NO.	DATE	BY	REVISIONS
		CHECKED BY		1	12-7-66		ELECTRICAL AS BUILTS	3			
CHECKED BY	DATE		DATE	2				4			

MICHIGAN
DEPARTMENT OF NATURAL RESOURCES

TITLE SHEET & SITE PLAN
SHEET TITLE

YANKEE SPRINGS RECREATION AREA
AREA OR PARK
BEACHHOUSE & CONCESSION BUILDING
PROJECT

PROJECT NO.
SHEET 1 OF 11
PLAN SCALE 1"=5'