


NO.	DATE	BY	REVISIONS
1	3-28-52	H.E.B.	Final measurements shown
2			
3			
4			
5			
6			

APPROVED BY	DATE	REVIEWED BY SECTIONS
H.C. MacArthur	8-22-52	ARCHITECTURAL
ASSISTANT CHIEF IN CHARGE	8-22-52	ENGINEERING
OF DESIGN	8-22-52	LANDSCAPE

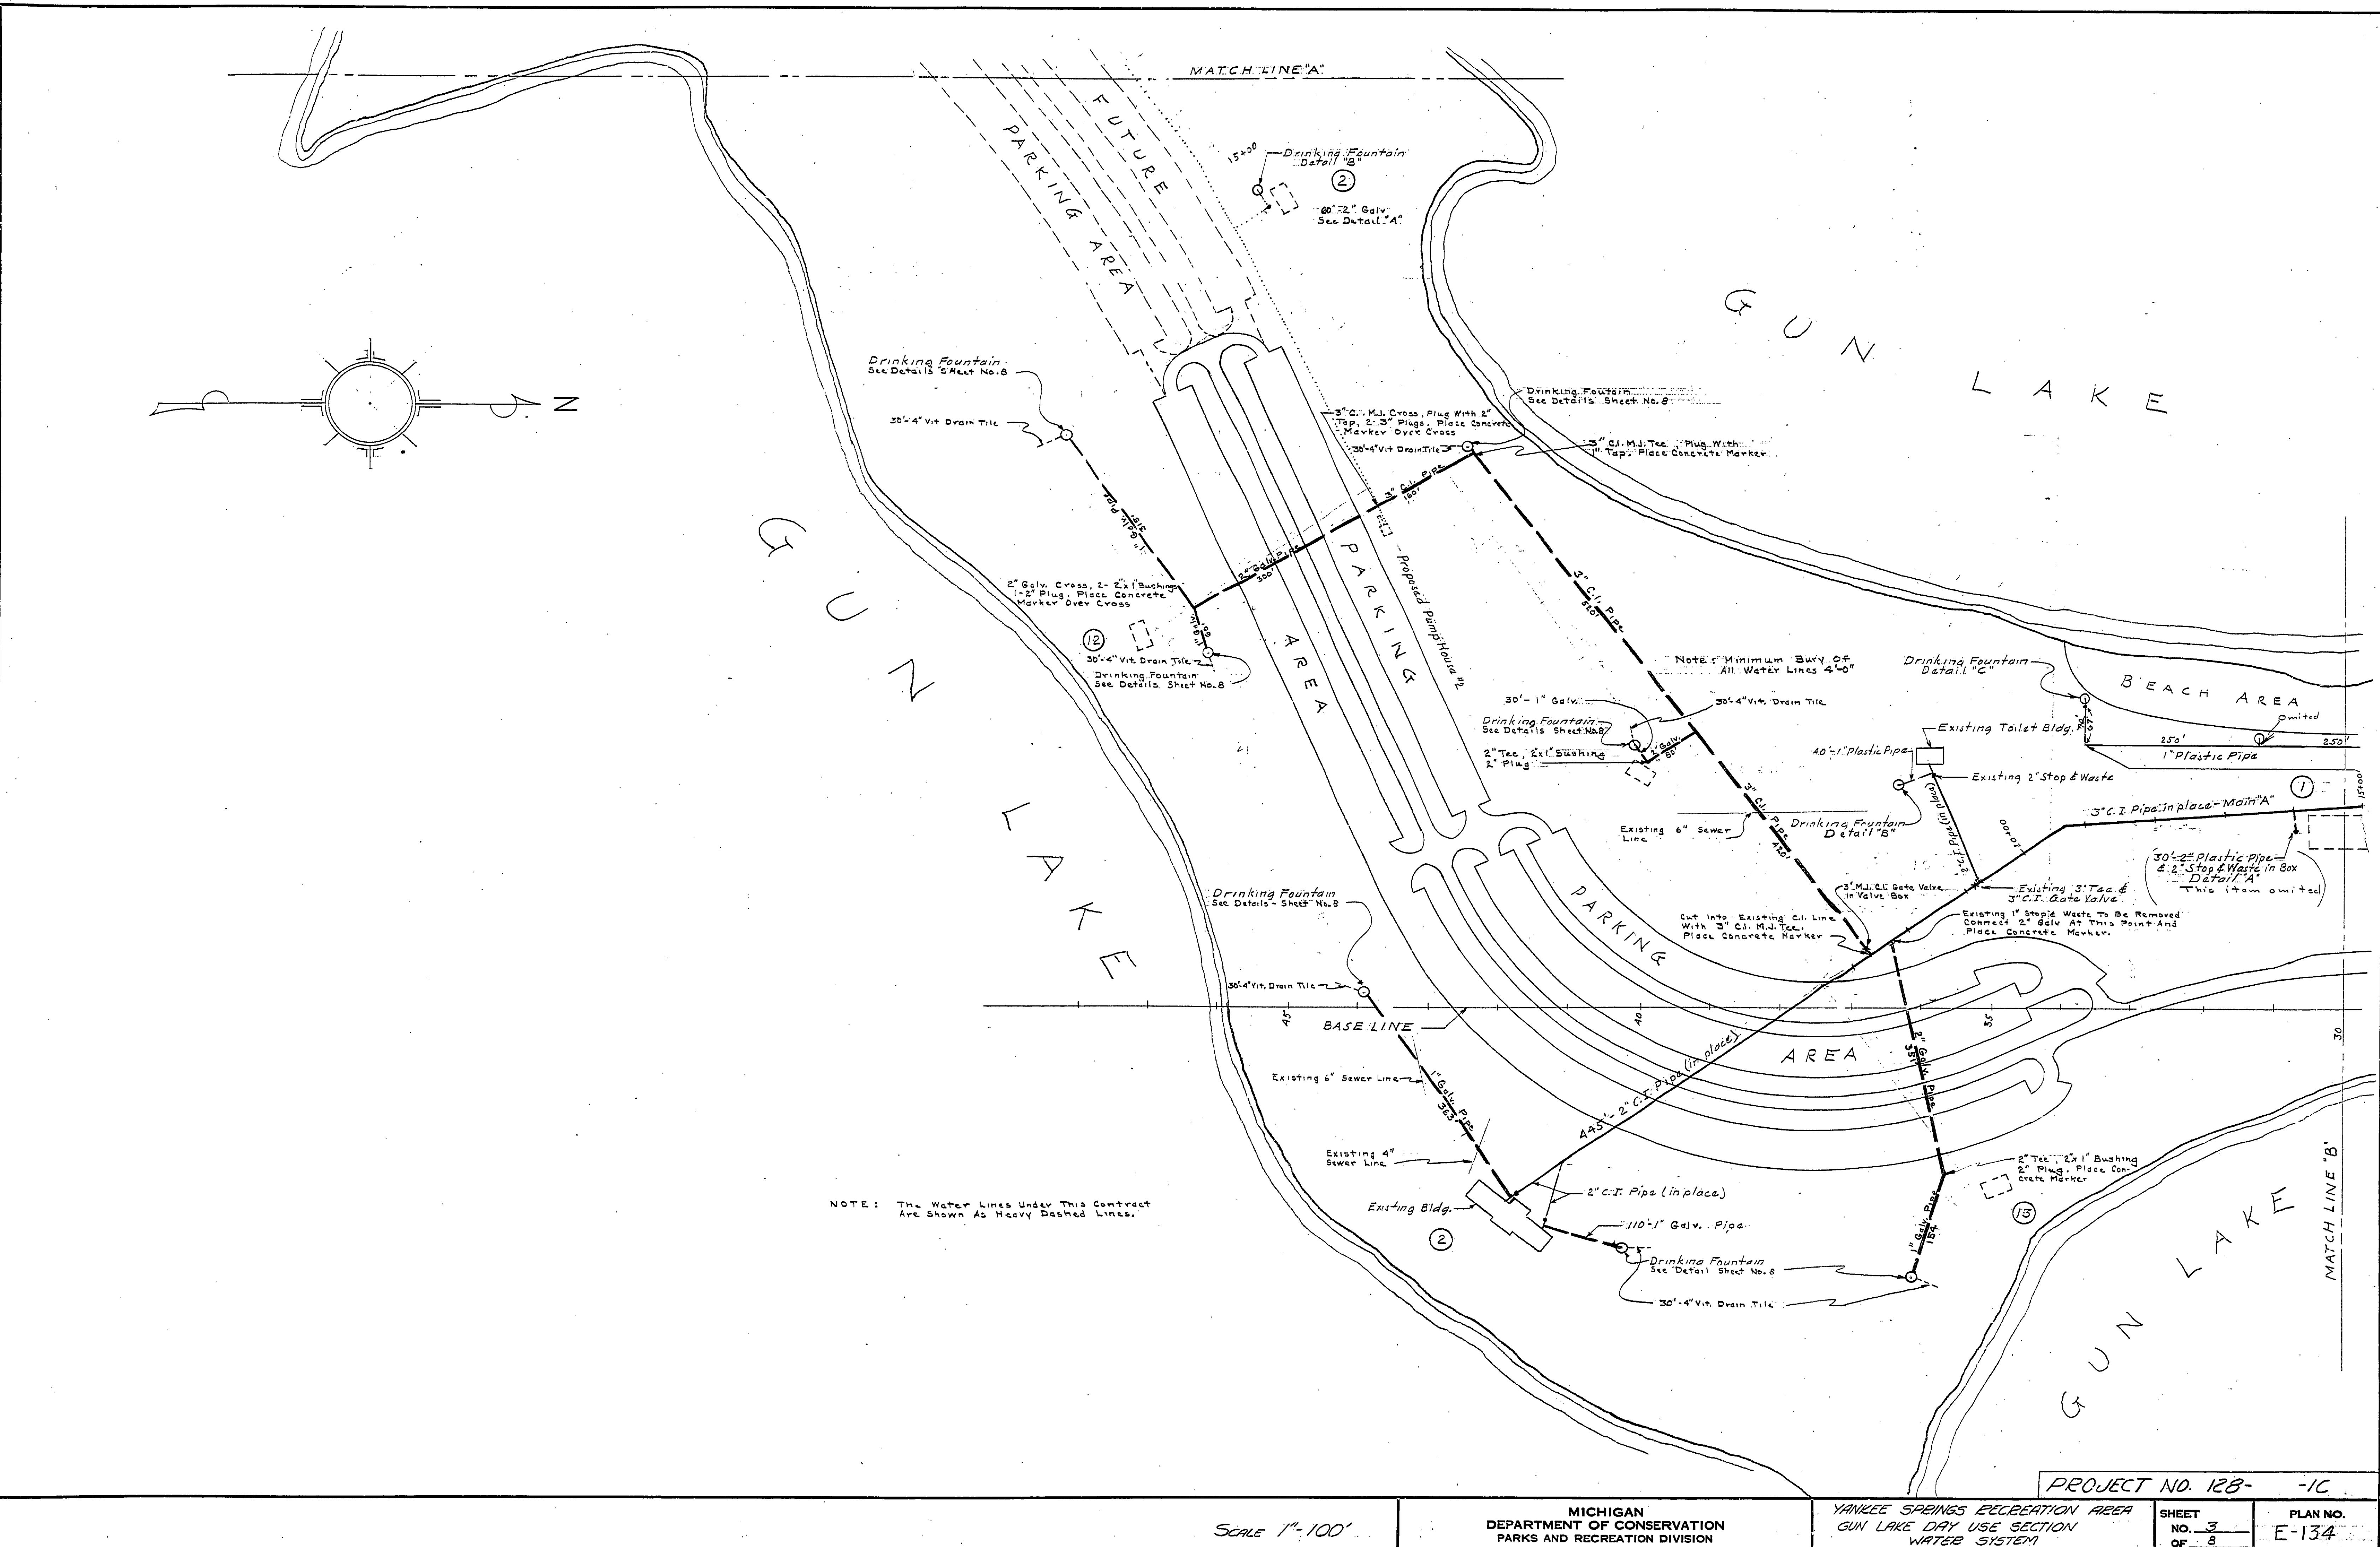

NOTE: The Water Lines Under This Contract Are Shown As Heavy Dashed Lines.

SCALE 1"=100'

MICHIGAN DEPARTMENT OF CONSERVATION PARKS AND RECREATION DIVISION

YANKEE SPRINGS RECREATION AREA GUN LAKE DRY USE SECTION WATER SYSTEM

PROJECT NO. 128-1C SHEET NO. 3 OF 8 PLAN NO. E-134