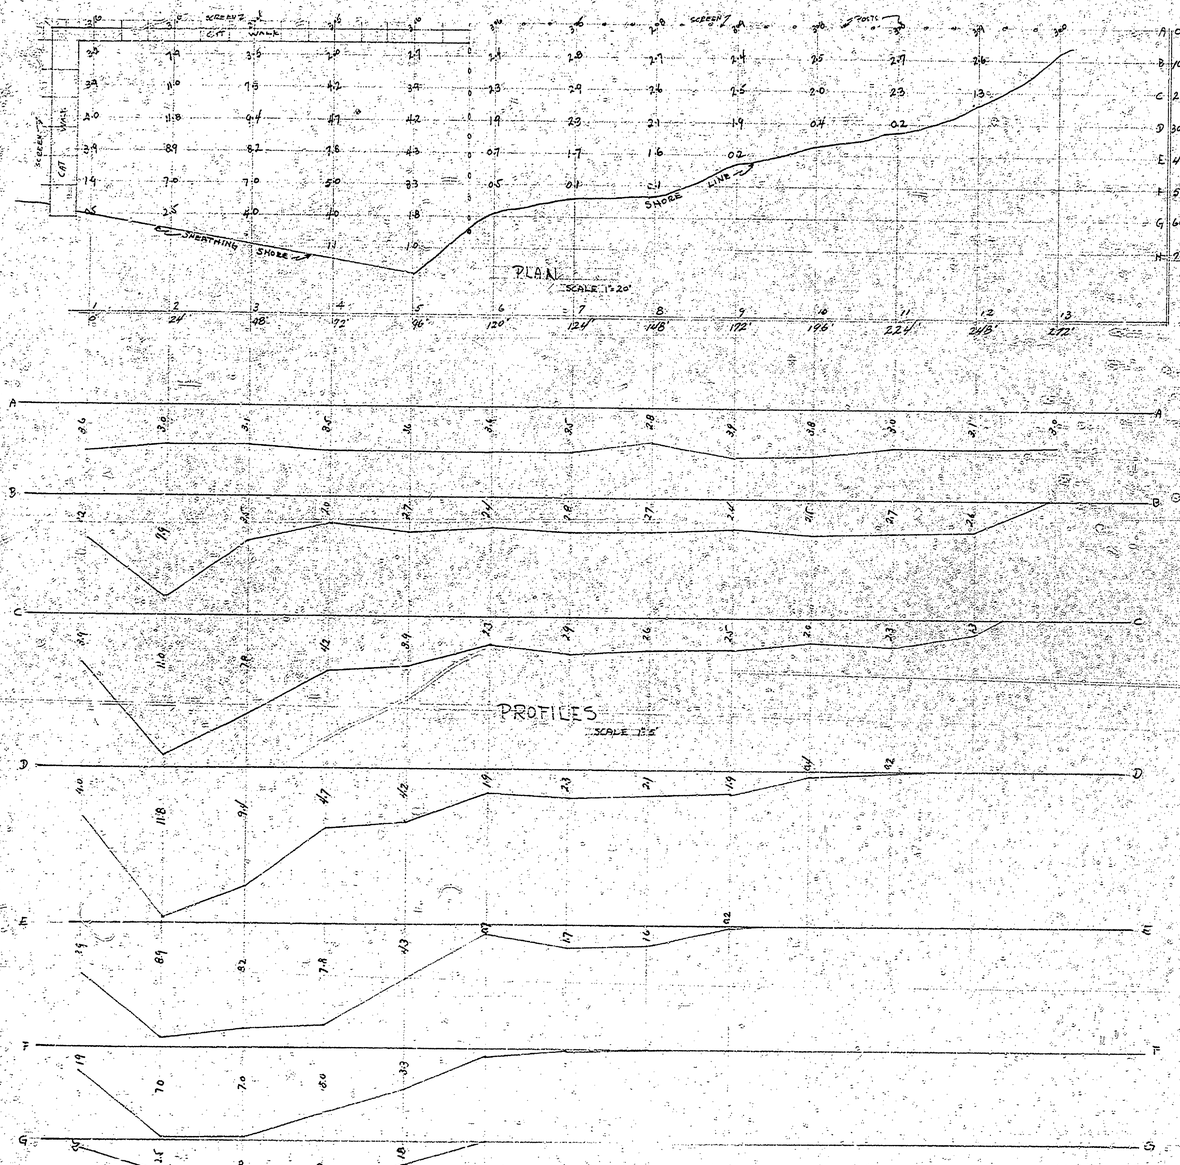

NOONDAY BEACH BOTTOM
PLAN & PROFILES

SCALE - PLAN 1"=20' PROFILE VERT. 1"=5'

L-121