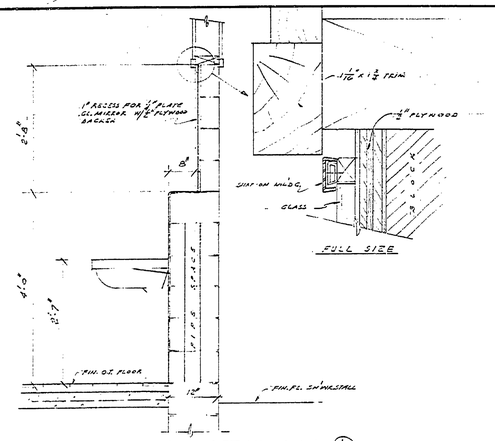

SHELF & MIRROR DETAIL - LAV. (1/2/7)

SCALE 3/4"=1'-0"

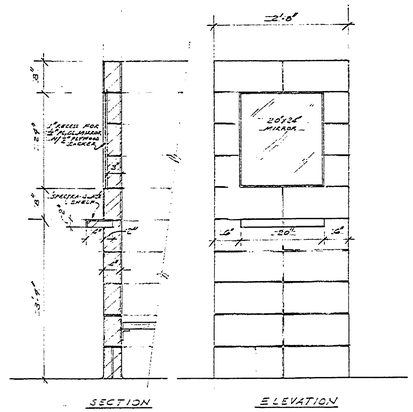

SHELF & MIRROR DETAIL - SHOWER (2/2/7)

SCALE 3/4"=1'-0"

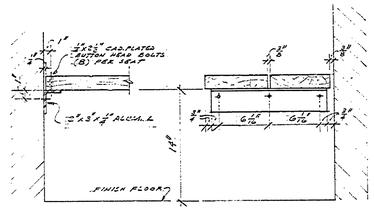

SHOWER SEAT DETAIL

SCALE 1/2"=1'-0"

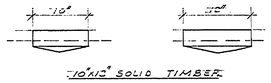

DUMMY LOOKOUT DETAIL

SCALE 1"=1'-0"

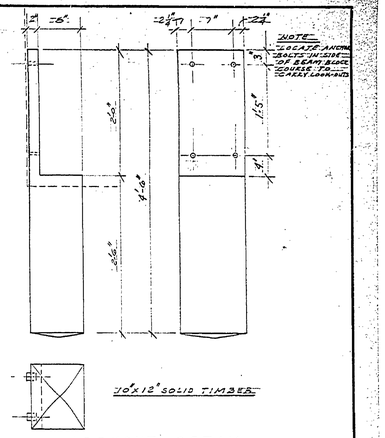

LOOKOUT DETAIL

SCALE 1"=1'-0"

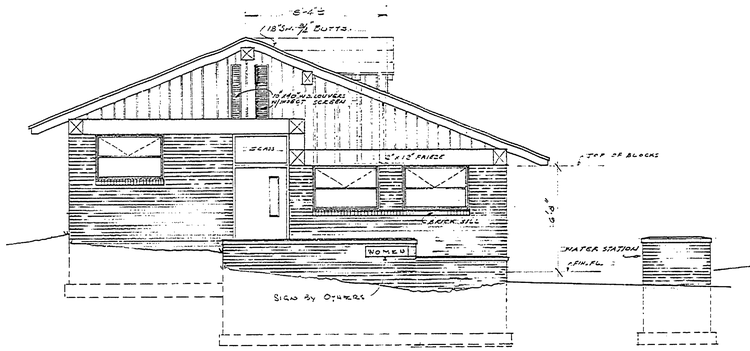

S.E. ELEVATION

SCALE 3/4"=1'-0"

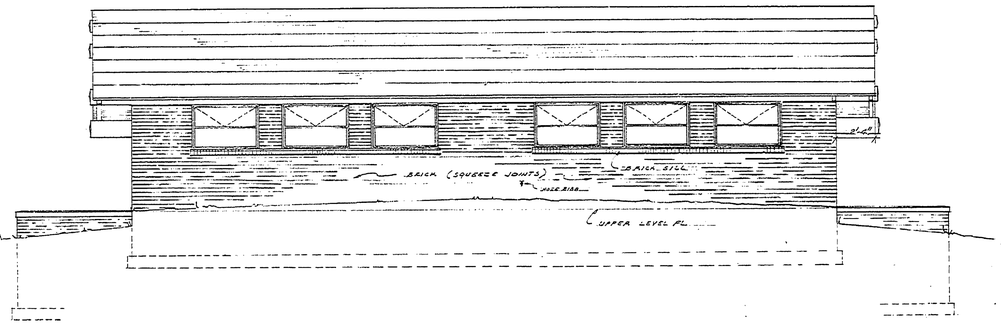

REAR - S.W. ELEVATION

SCALE 3/4"=1'-0"

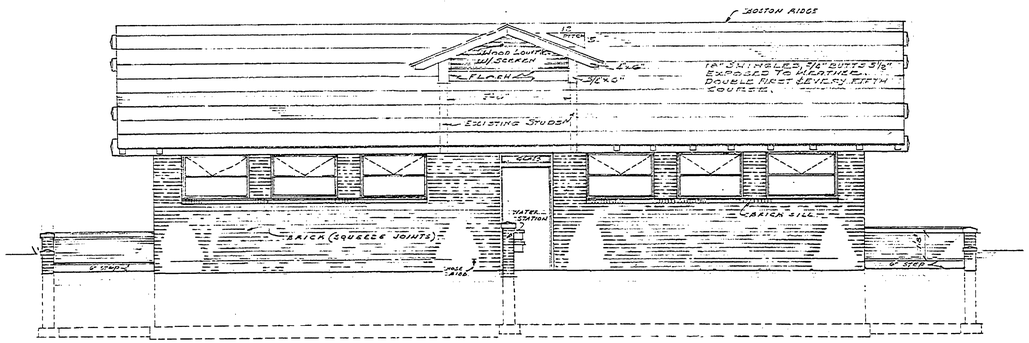

FRONT - N.E. ELEVATION

SCALE 3/4"=1'-0"

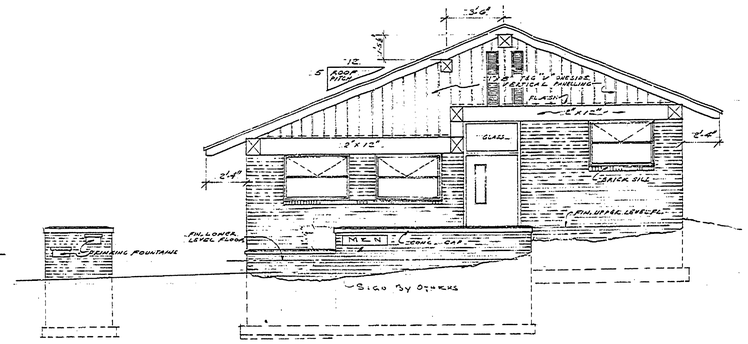

N.W. ELEVATION

SCALE 3/4"=1'-0"

DESIGNED BY J.D. GREENWOOD	5-61	ARCHITECTURAL	
DRAWN BY		ENGINEERING	
CHECKED BY	7-61	LANDSCAPE	

DATE	BY	REVISIONS
		4
		5
		6

DATE	NO.	DATE	BY	REVISIONS
7/31/61	1	10-31-61	WRC	REVISED BEAMS AS CONST.
	2	7-15-62		DOMESTIC WATER
	3			

APPROVED

	DATE
Architectural Consultant	10-27-61
Engineering Consultant	10-27-61
Landscape Consultant	7-27-61

Chief, Div. of Engineering

Director, Dept. of Conservation

Commercial Blueprint Service, Lansing

MICHIGAN
DEPARTMENT OF CONSERVATION
PARKS AND RECREATION DIVISION

LUDINGTON STATE PARK
TOILET & SHOWER BUILDING
NORTH BEECHWOOD CAMPING AREA

SHEET NO. 4 OF 5

PLAN NO. A-107

MASTER PLAN 86