

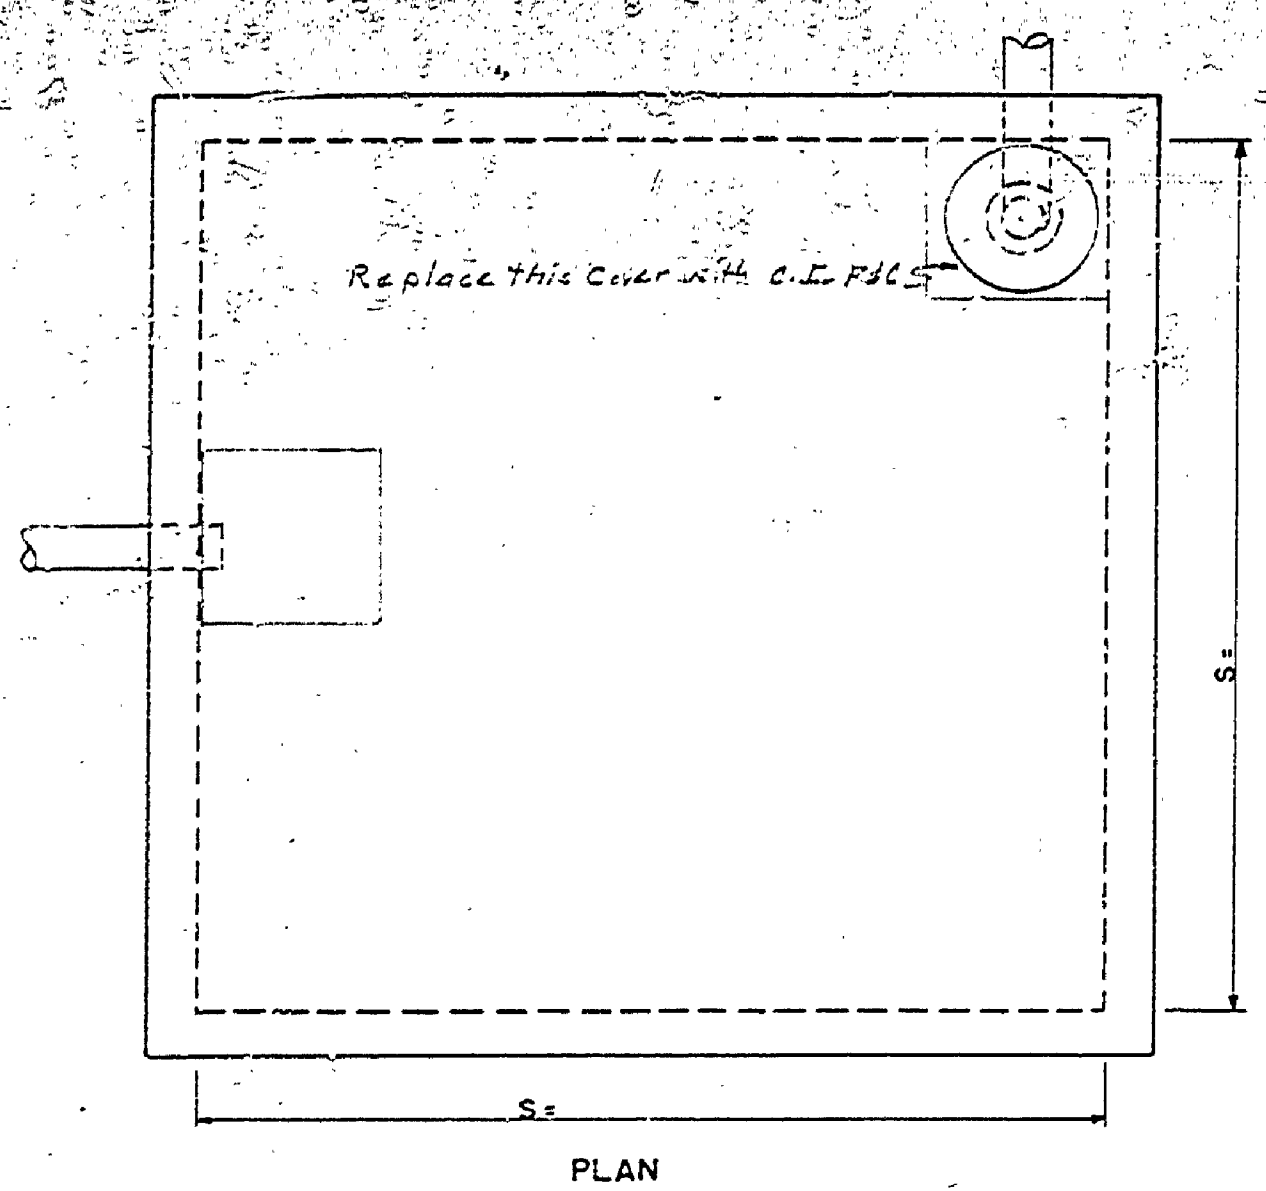



DATE	BY	REVISIONS
12-29-55	E.P.P.	1
		2
		3
		4
		5
		6

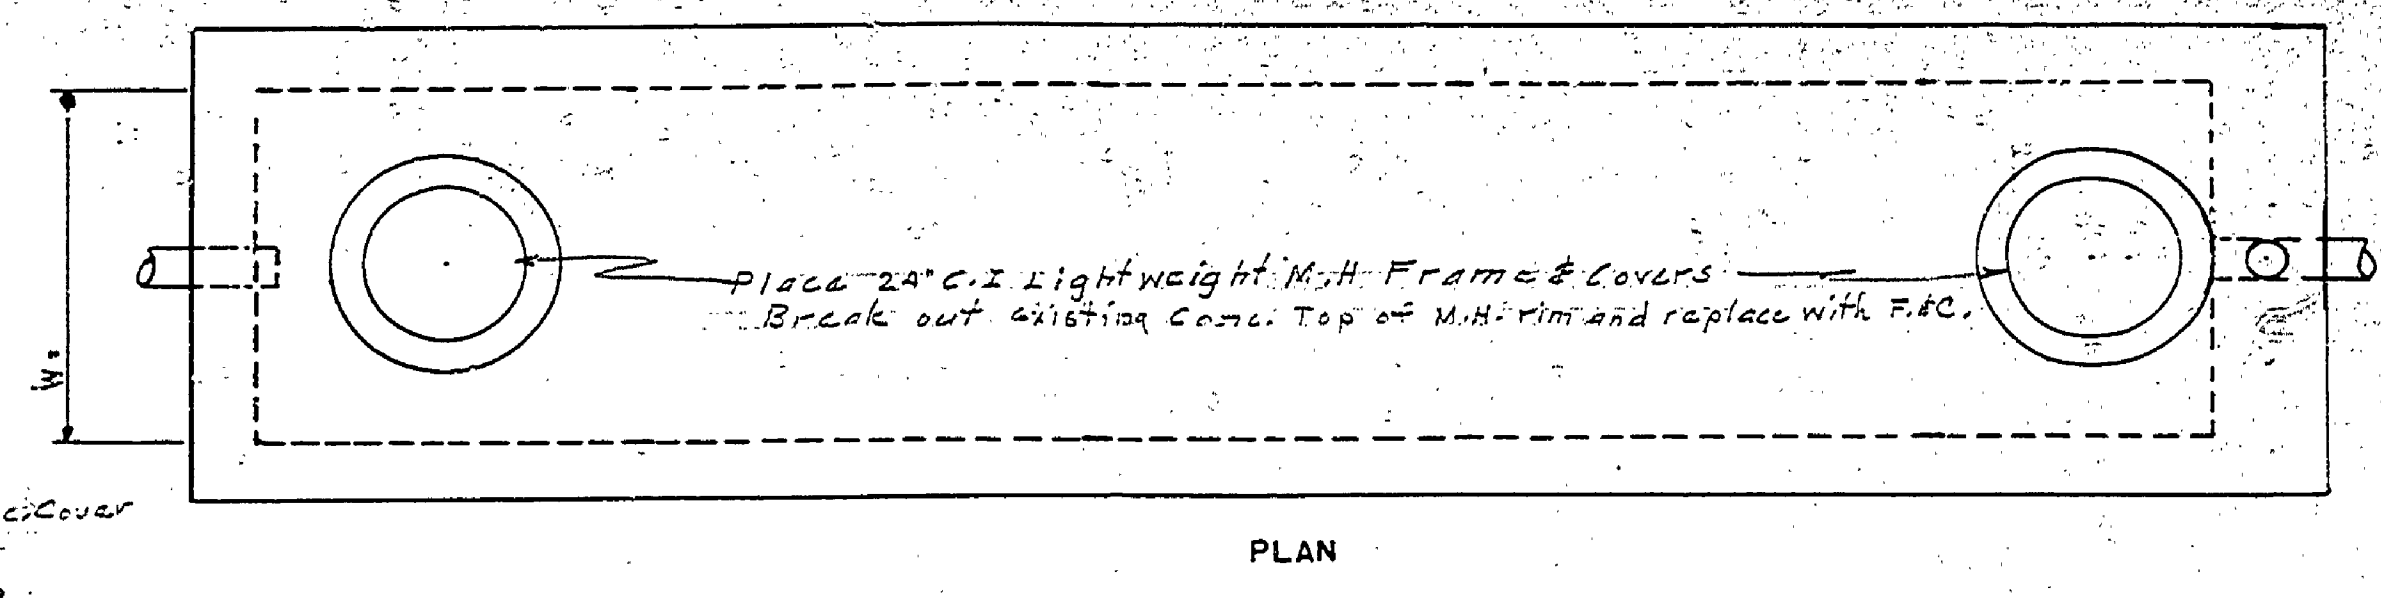

NOTES FOR DOSING CHAMBER
 SEE PLAN NO. SE-119 FOR STEEL REINFORCING DETAILS AND DETAIL DIMENSIONS OF DOSING CHAMBER BEAM.
 USE 4" SIPHON WITH 17" DRAWDOWN.
 USE S₁ H₁ K₁ h₁

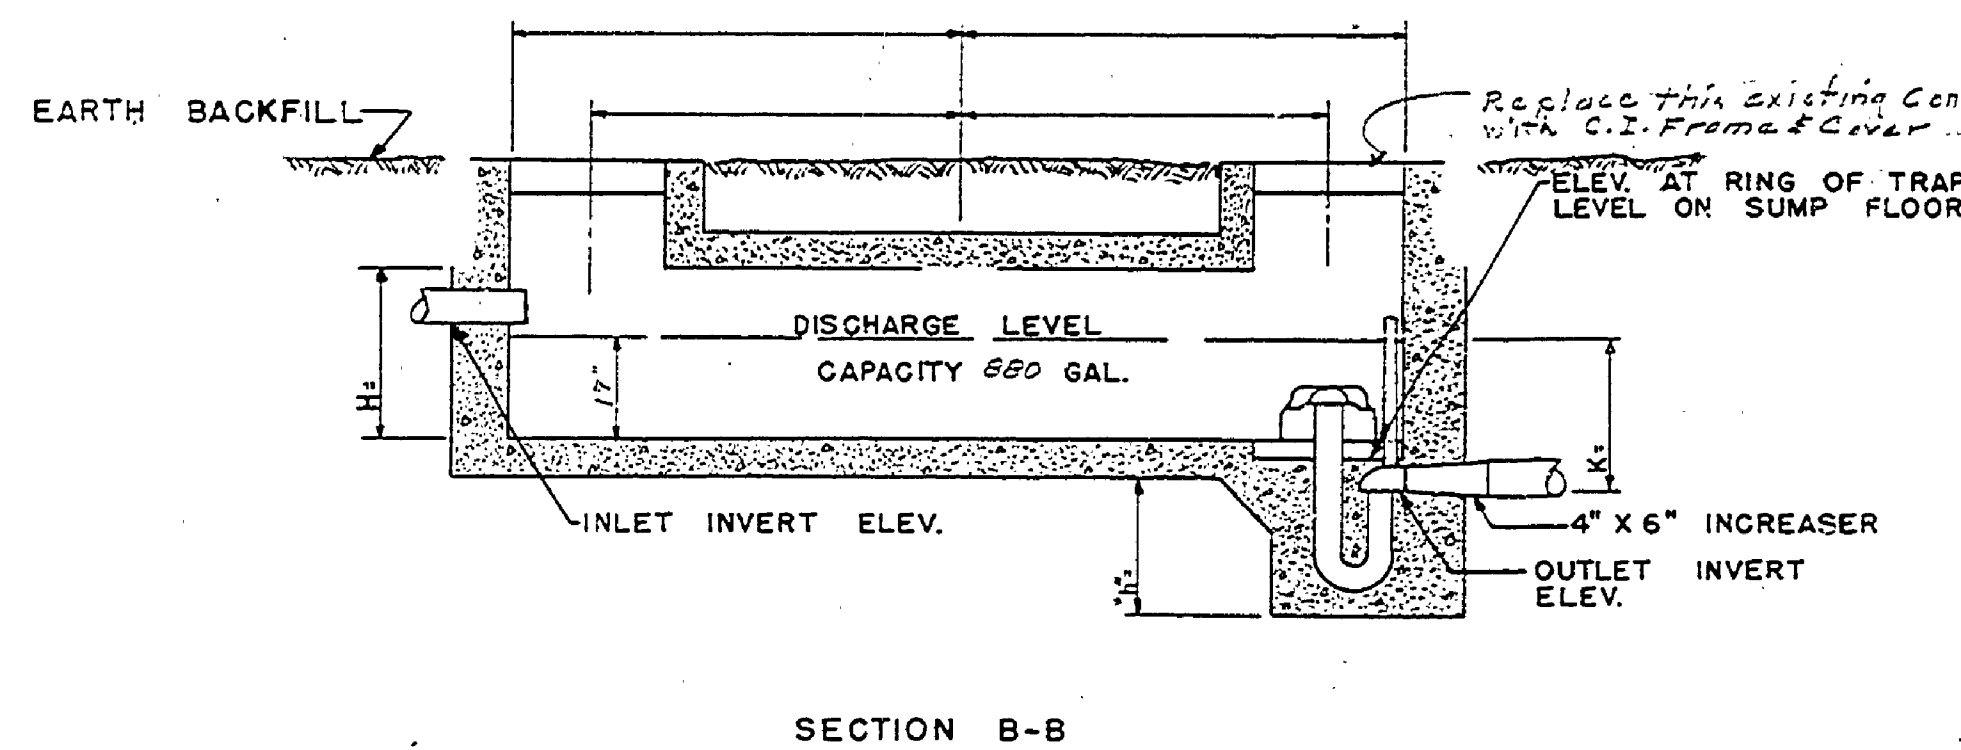


NOTES FOR SEPTIC TANK
 SEE PLAN NO. SE-121 FOR STEEL REINFORCING DETAILS AND DETAIL DIMENSIONS.
 USE L₁ W₁ h₁


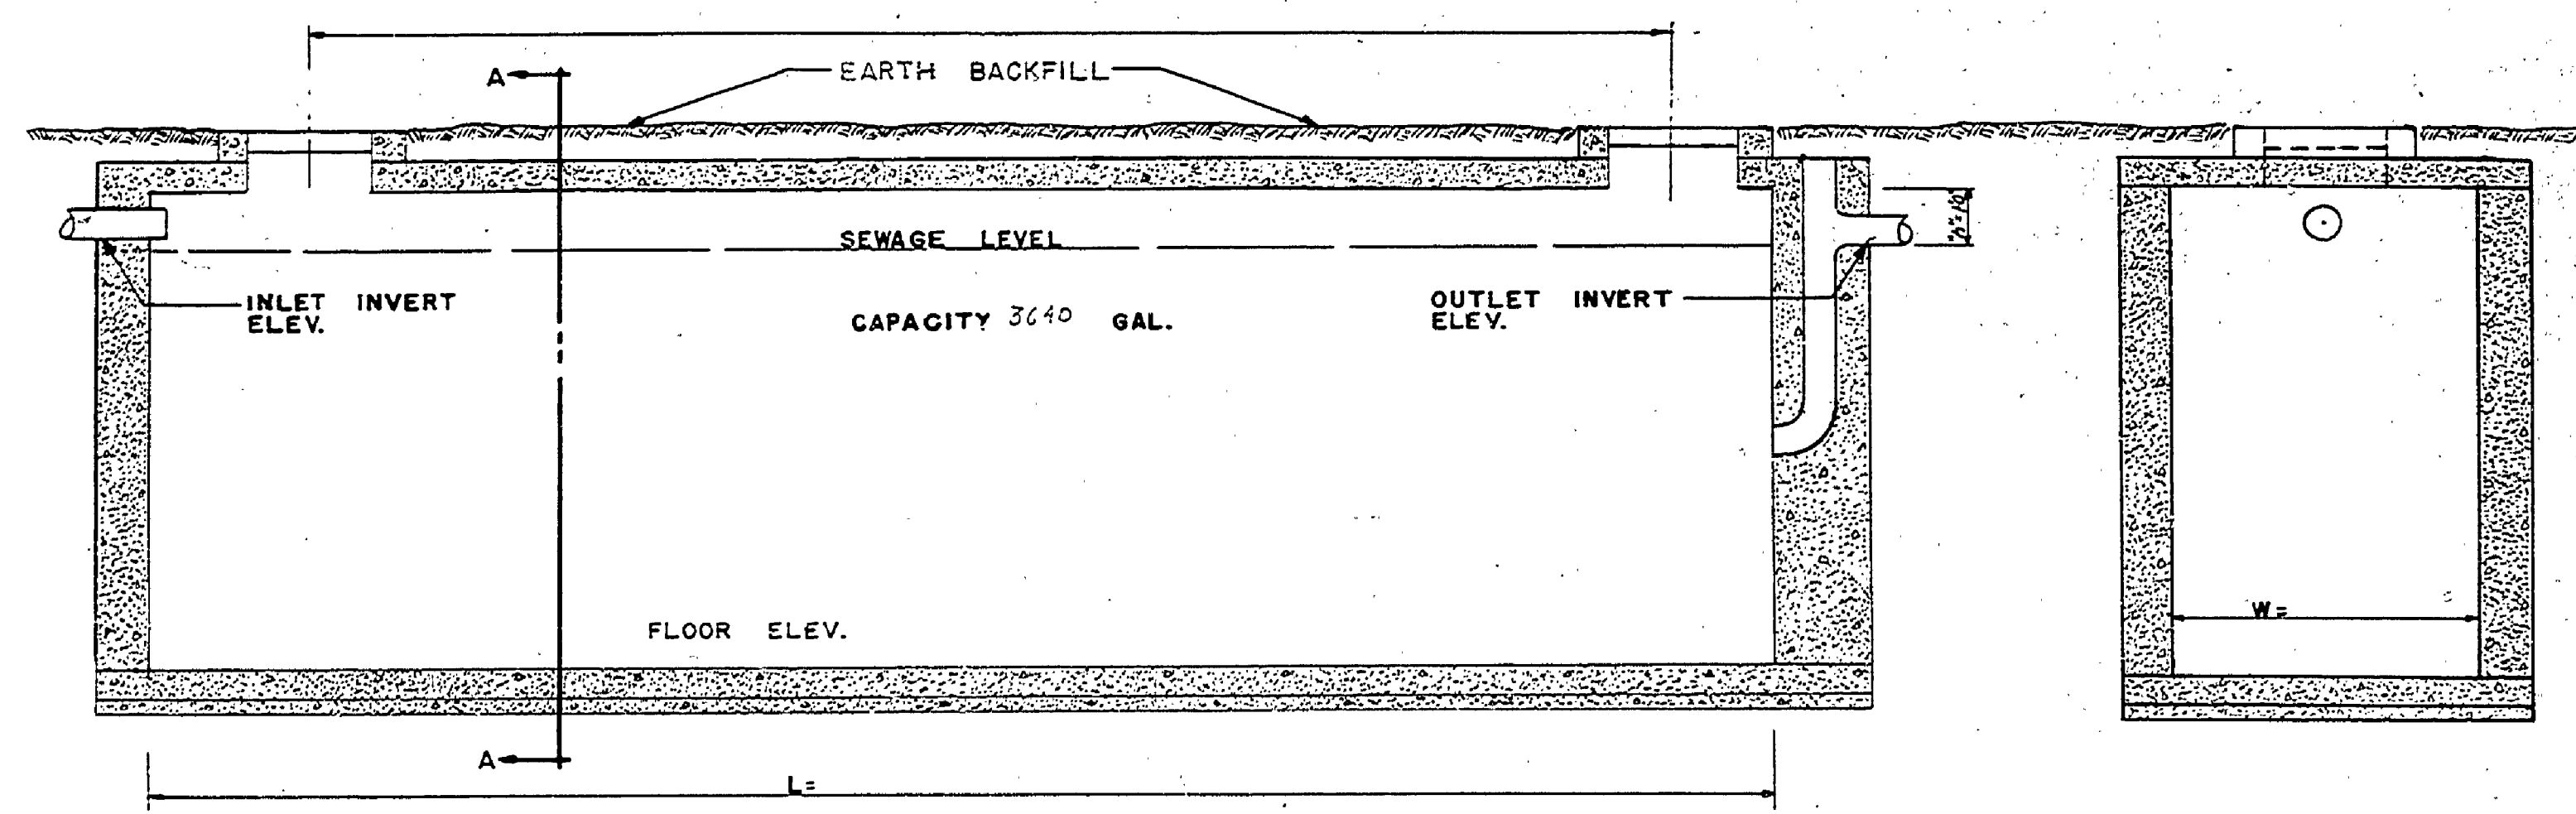


DOSING CHAMBER
 NOT TO SCALE


LONGITUDINAL SECTION
 SEPTIC TANK
 NOT TO SCALE

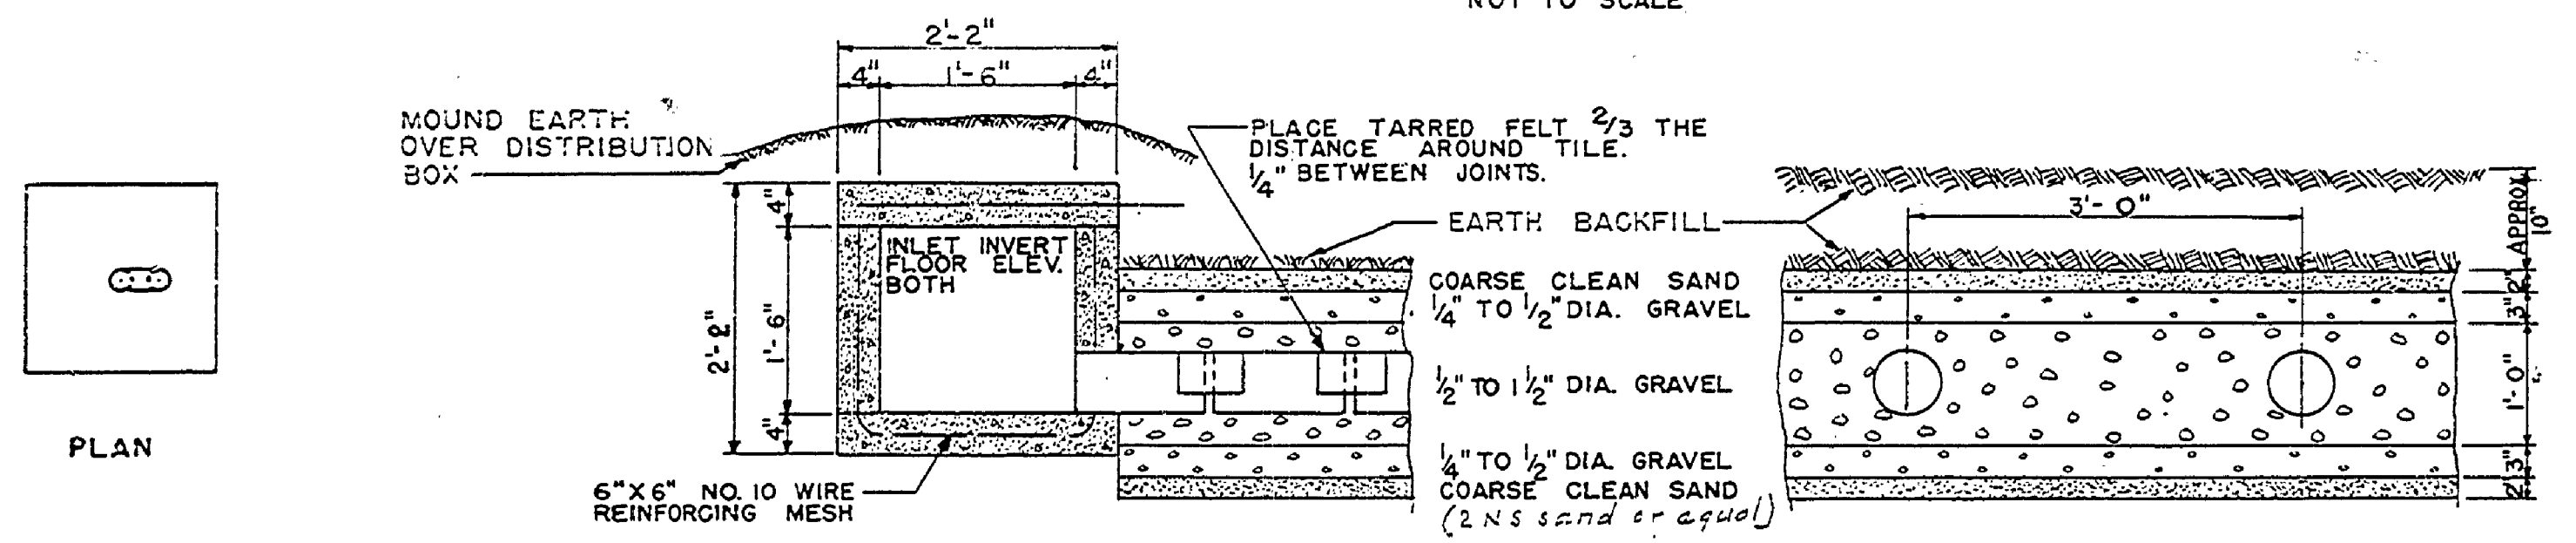


ELEVATION OF DISPOSAL FIELD
 NOT TO SCALE

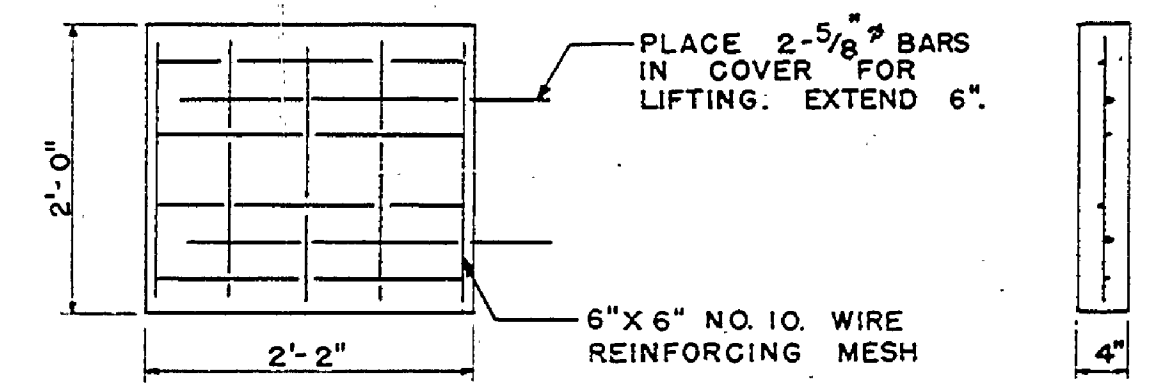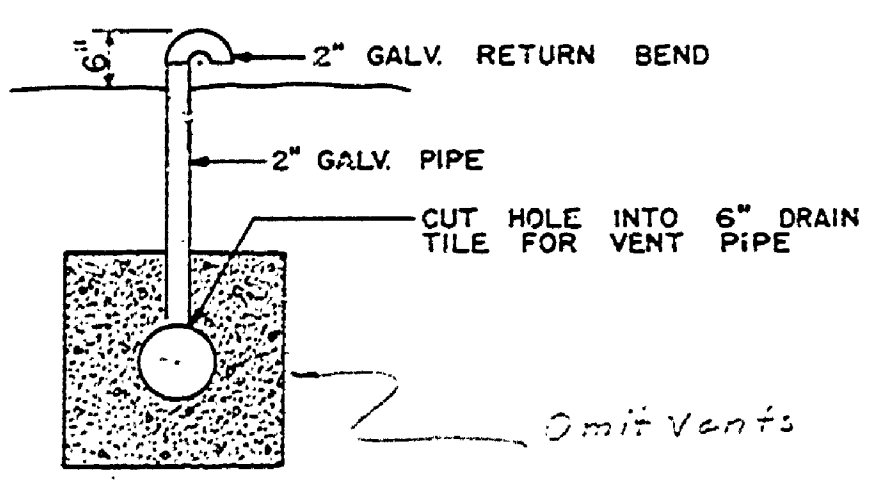

DISTRIBUTION BOX COVER
 NOT TO SCALE

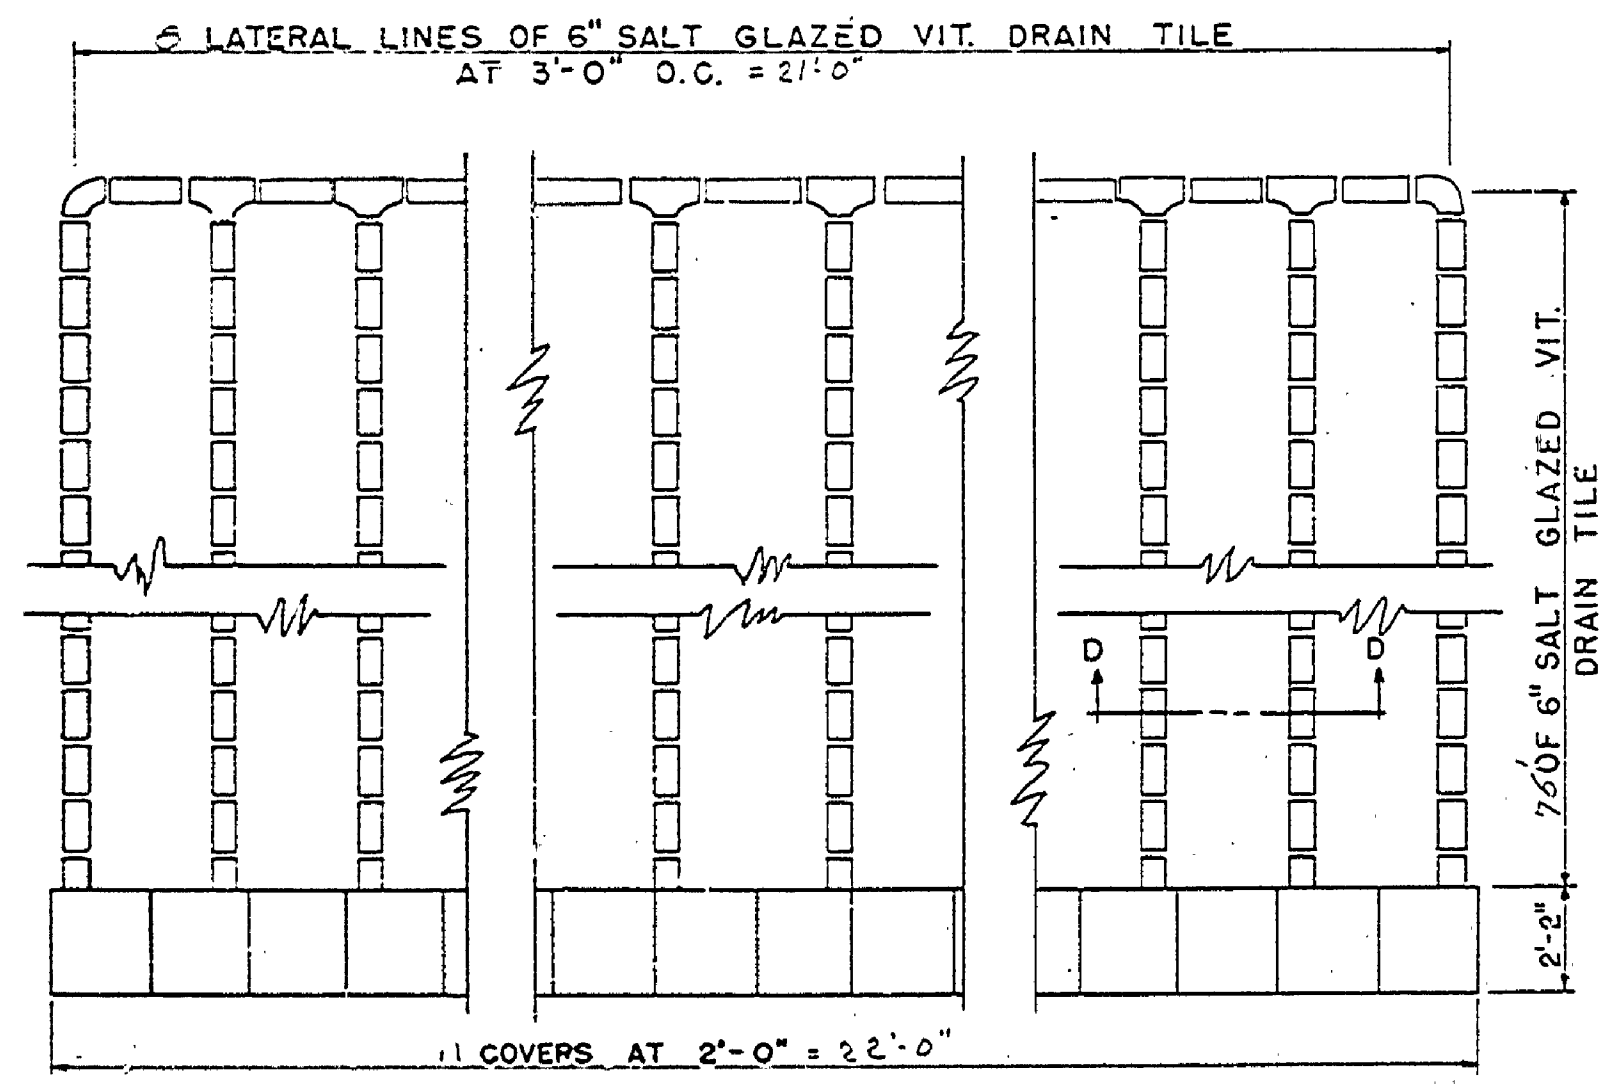

PLAN
 DISPOSAL FIELD
 NOT TO SCALE

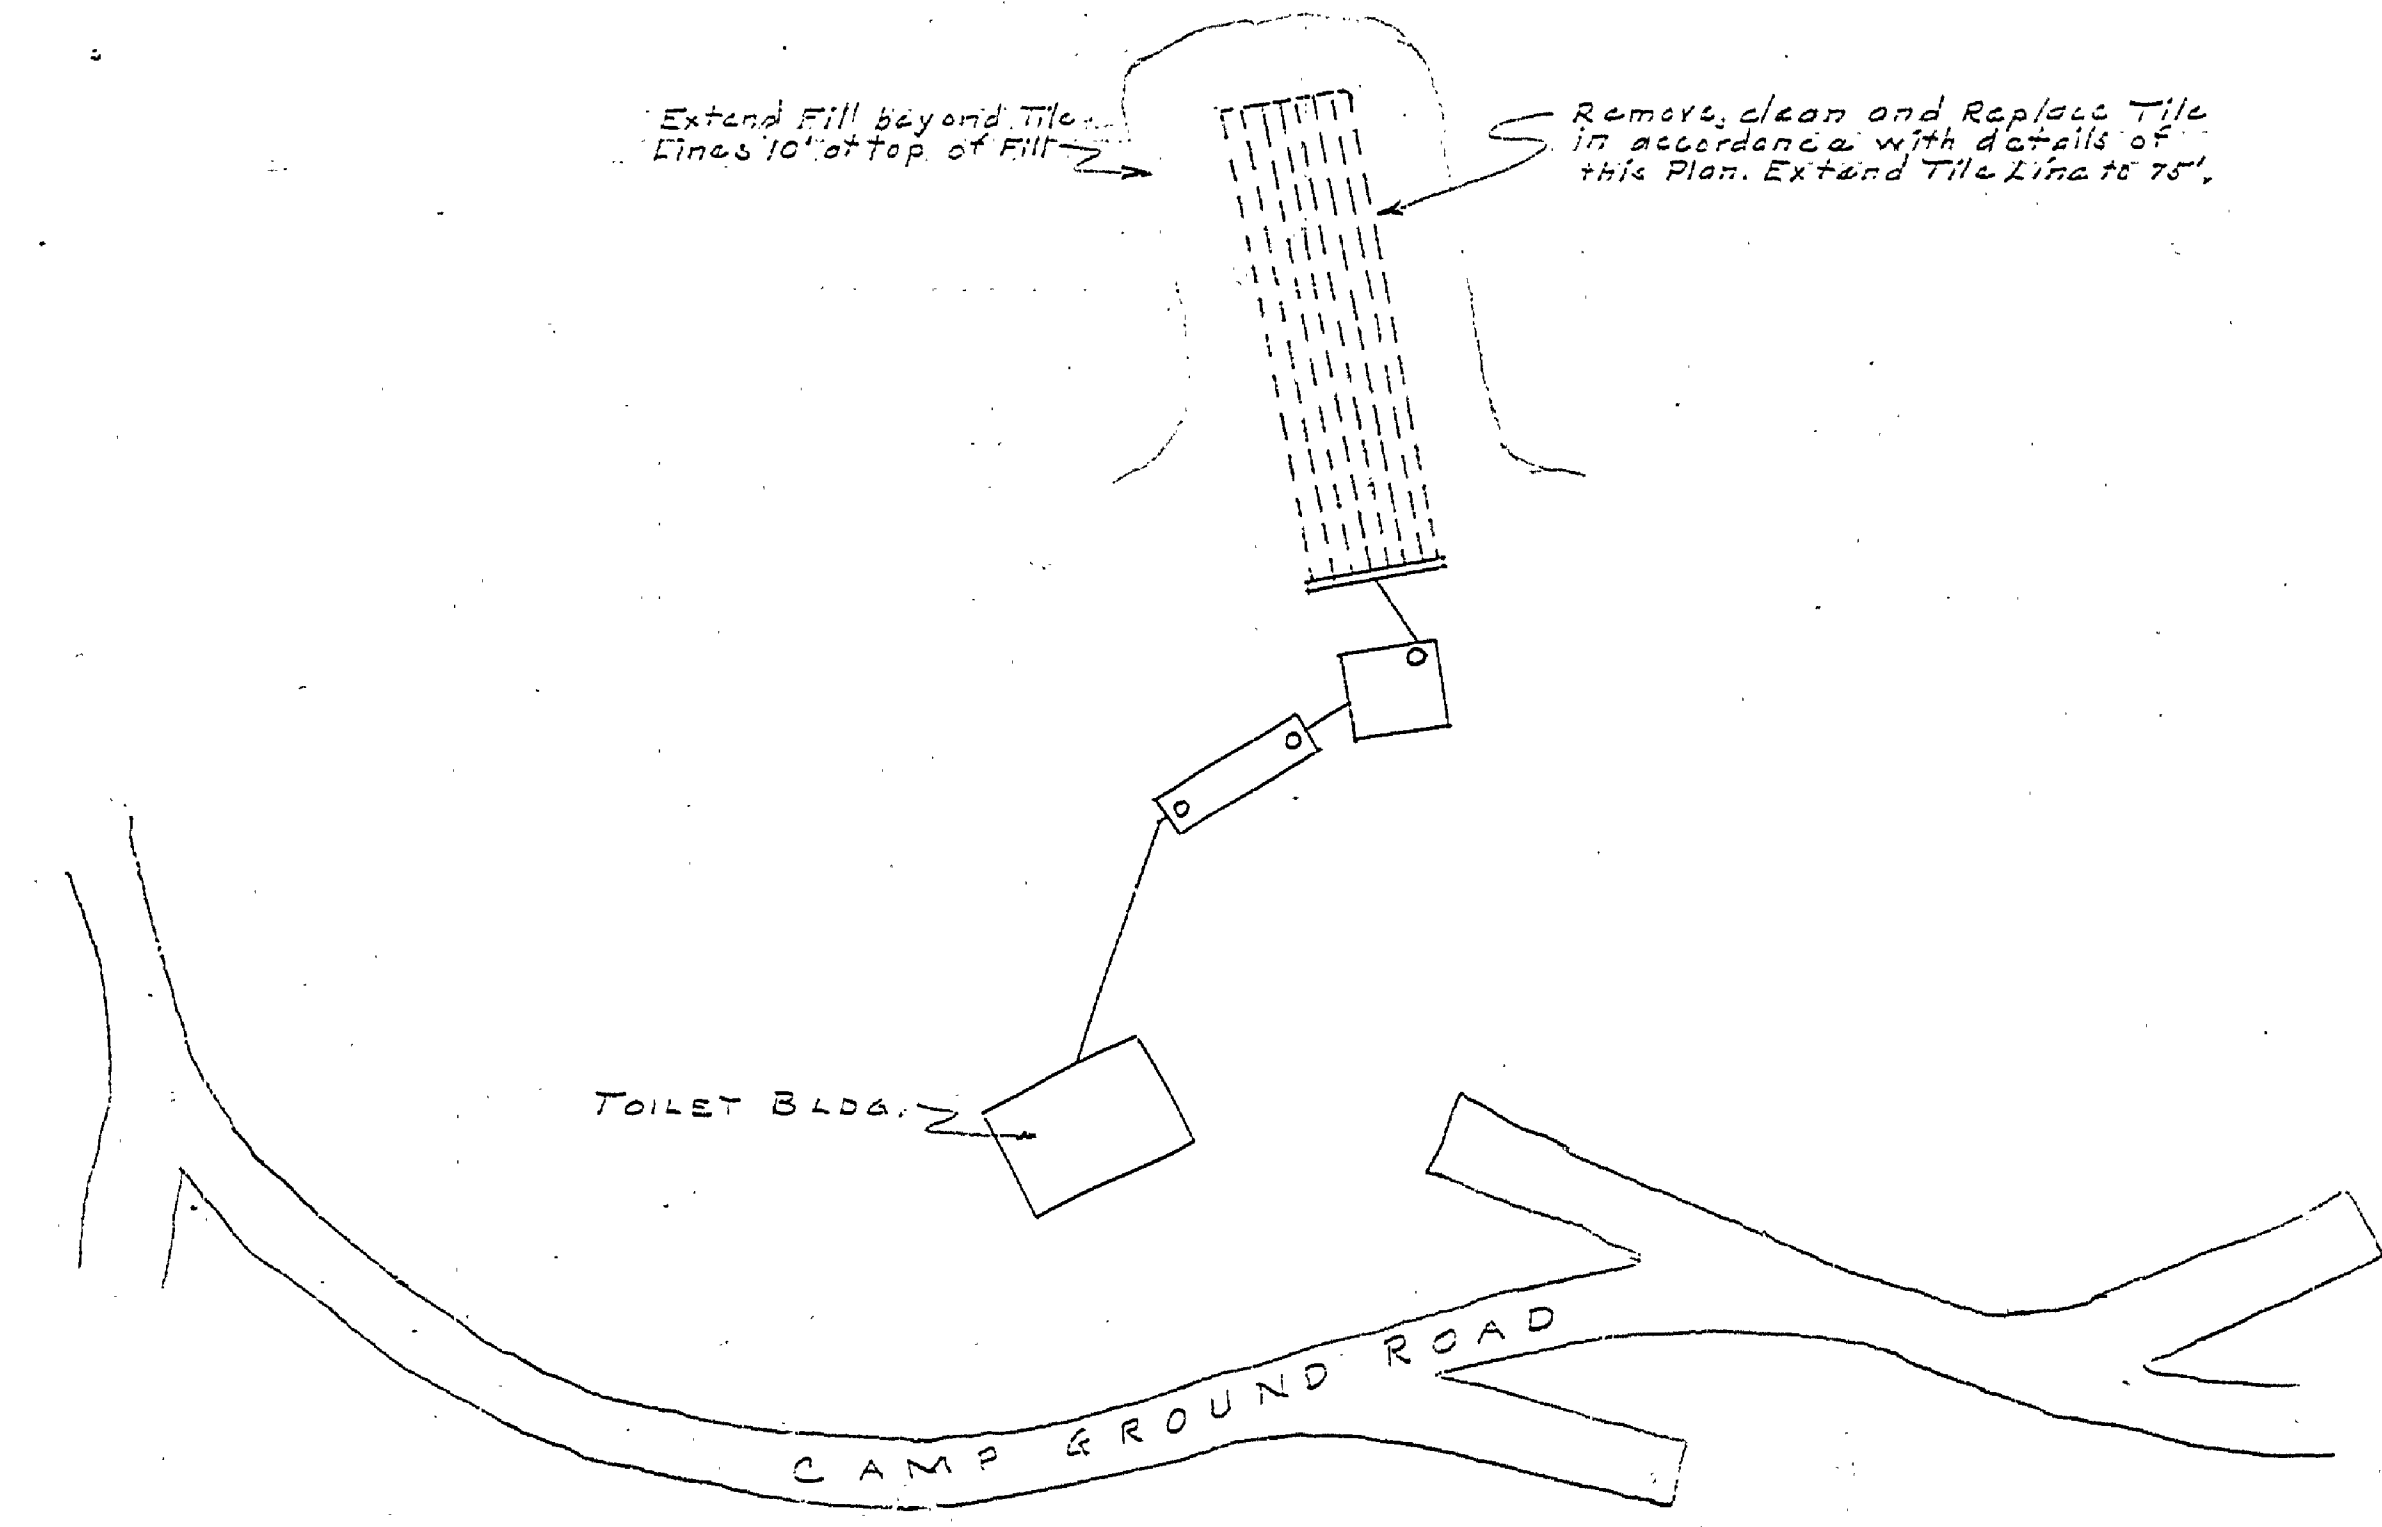

PLOT PLAN
 SCALE 1\"/>

DATE	BY	REVIEWED BY SECTIONS
		ARCHITECTURAL
		ENGINEERING
		LANDSCAPE

MICHIGAN
 DEPARTMENT OF CONSERVATION
 PARKS AND RECREATION DIVISION

LUDINGTON STATE PARK
 BEECHWOOD CAMP GRD. TOILET DISPOSAL
 SCALE AS SHOWN

SHEET NO. 2
 OF 2
 PLAN NO. E-94

STANDARD DISPOSAL SYSTEM