


LEGEND:-  
 ——— Original layout.  
 - - - - - Revised " as staked.

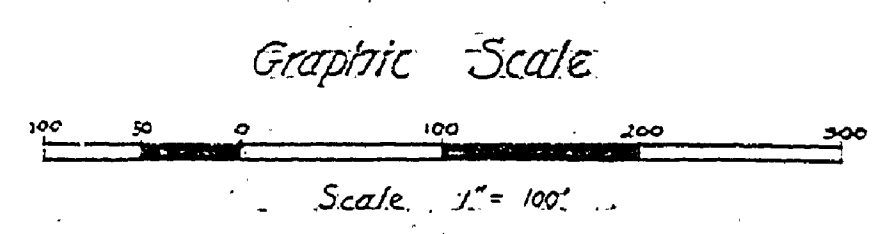

ITEM	DESCRIPTION OF ARTICLES	QUANTITY	UNIT
1	150 G.P.M. 50" pressure pump with 220 volt single phase motor.	1	
2	4000 Gal. welded steel storage tank 6x20'	1	
3	6" Diam. x 150' deep wrought iron pipe cased well (Estimated)		
4	2" Pipe	1500	feet
	1 1/2" Pipe	770	feet
	1" Pipe	750	feet
	3/4" Pipe	1350	feet
	Self-closing hydrants.	7	
5	Valves and fittings for connecting up pump and buildings		

U.S. DEPARTMENT OF INTERIOR		STATE OF MICHIGAN	
NATIONAL PARK SERVICE		LUDINGTON STATE PARK SP-2	
STATE PARK EMERGENCY		D-31-b	
CONSERVATION WORK		AUGUST 1934 SCALE 1" = 100'	
Checked By	Procurement Officer	Date	Allocation Available \$
Recommended for Construction	District Office Eng.	Submitted By	Sheet No. of
Approved for Construction	District Officer	Approved	File No. SP-2-6