
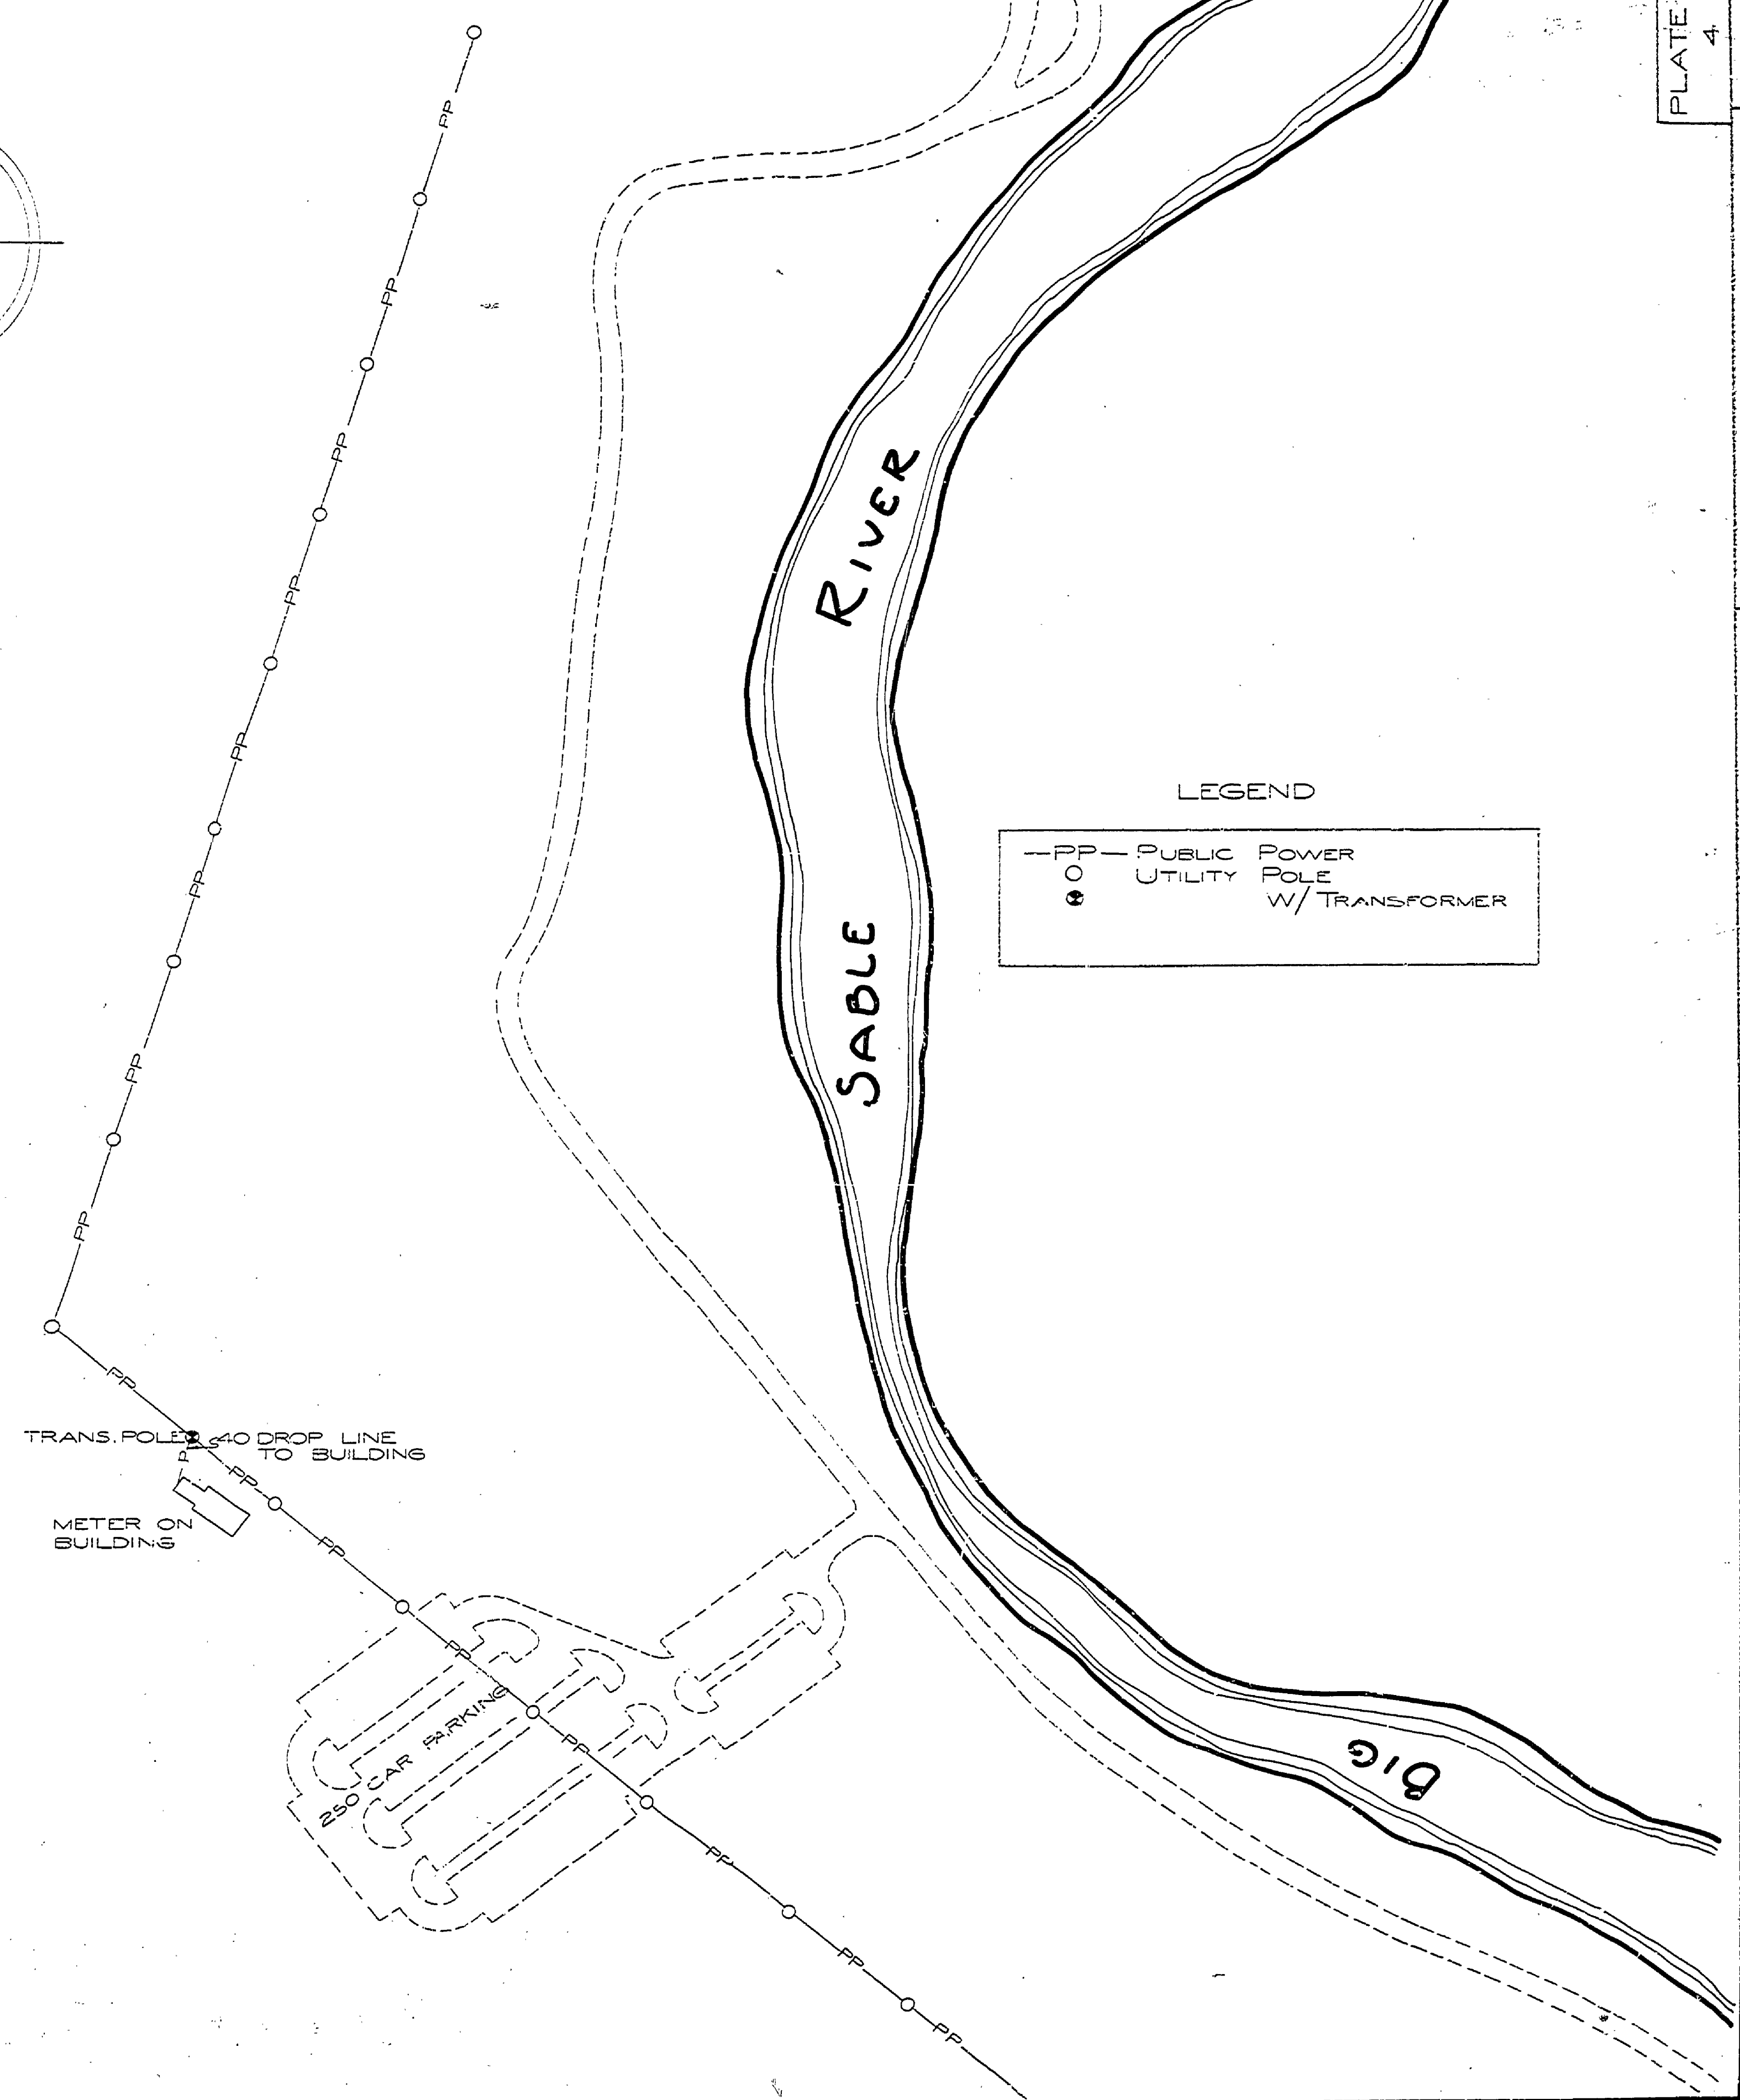


DESIGNED BY	DATE	REVIEWED	DATE	APPROVED	DATE	NO.	DATE	BY	REVISIONS	DATE	BY
CHECKED BY		LANDSCAPE				3			6		
DRAWN BY		ENGINEERING				2			5		
		ARCHITECTURAL				1			4		

LUDINGTON STATE PARK

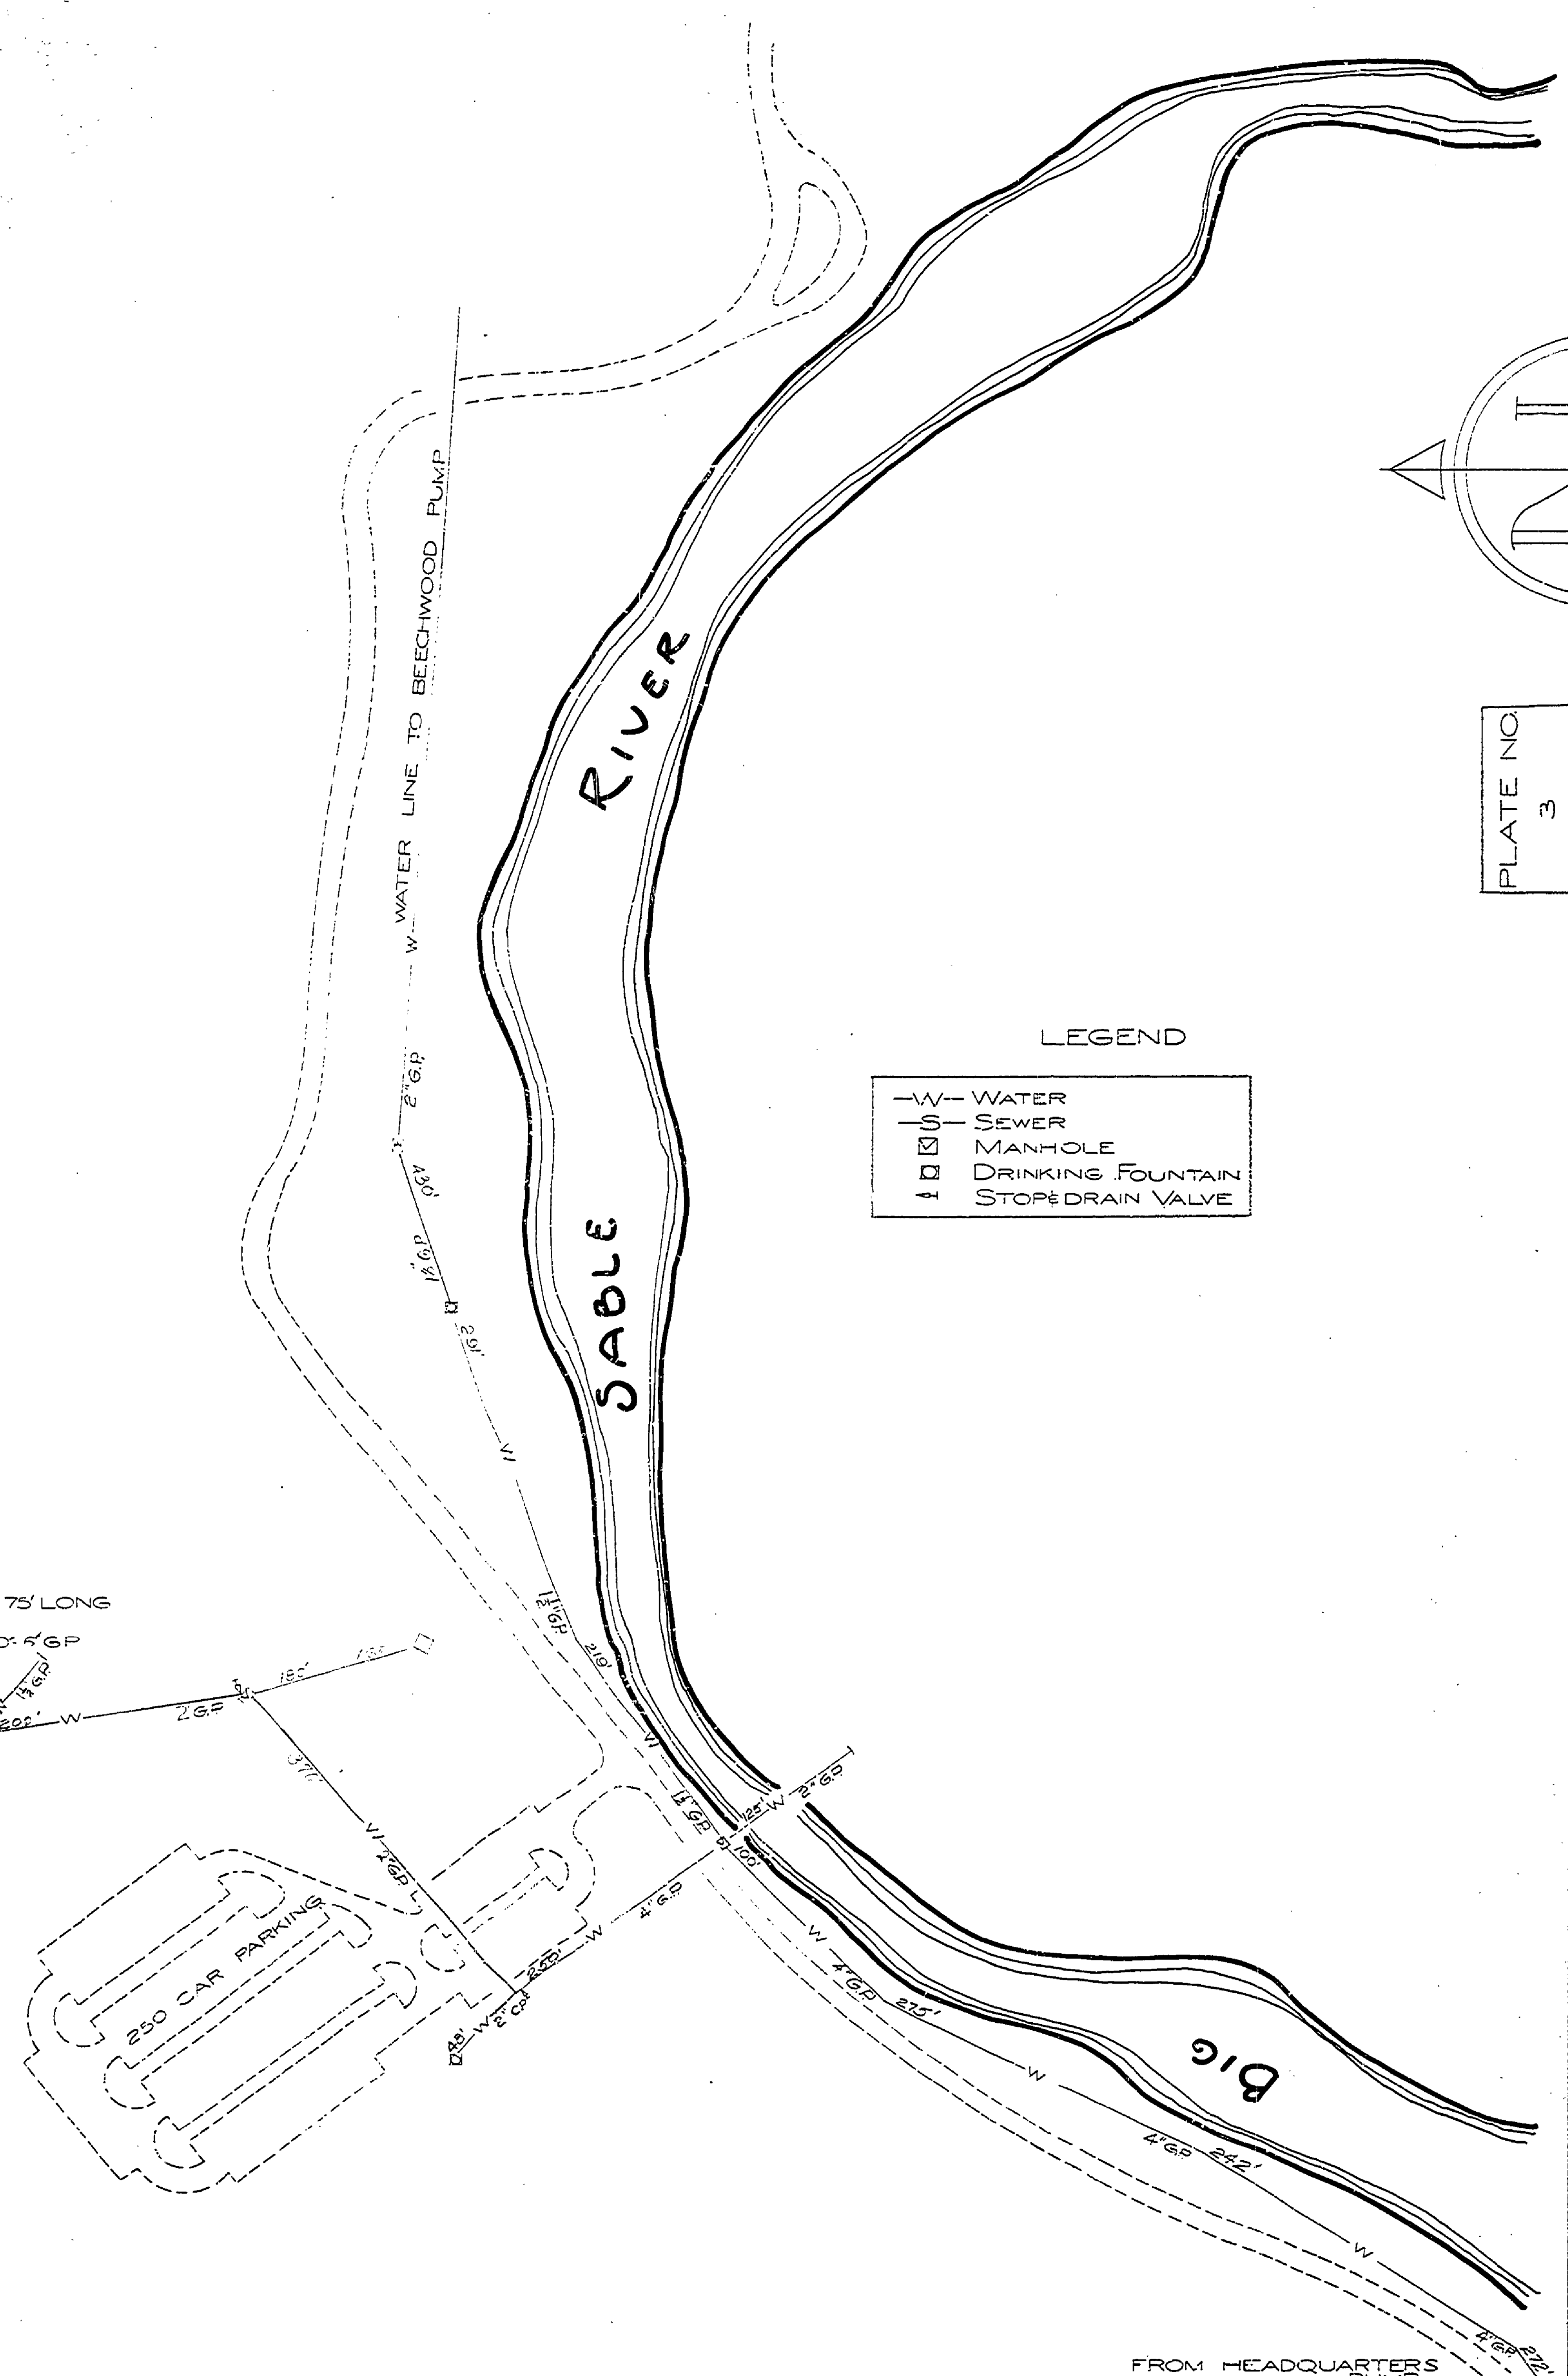

MICHIGAN DEPARTMENT OF CONSERVATION
PARKS AND RECREATION DIVISION

PLAYGROUND AND PICNIC AREA
ELECTRICAL WATER AND SEWAGE DIST.
NO SCALE

SHEET NO. 4 OF 4
PLAN NO. U-1

MICHIGAN DEPARTMENT OF CONSERVATION LUDINGTON STATE PARK PICNIC AREA ELECTRICAL DISTRIBUTION NO SCALE