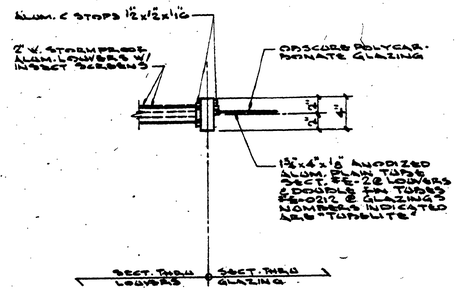

• SECTION • 1 A-4 1½" : ONE FOOT

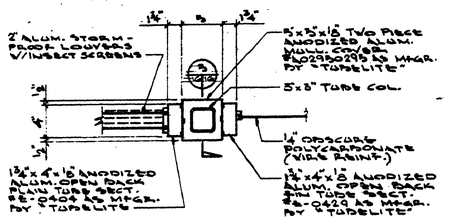

• SECTION • 3 A-4 1½" : ONE FOOT

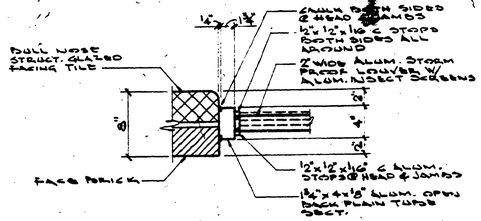

• SECTION • 2 A-4 1½" : ONE FOOT

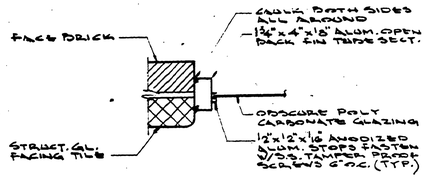

• SECTION • 4 A-4 1½" : ONE FOOT

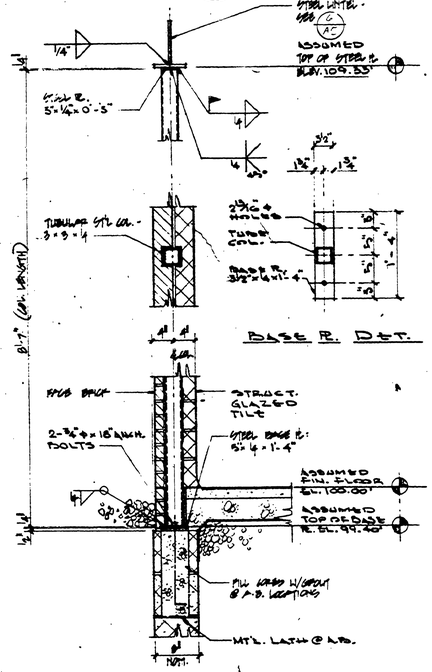

BASE R. DET.

• SECTION • 5 A-4 1" : ONE FOOT

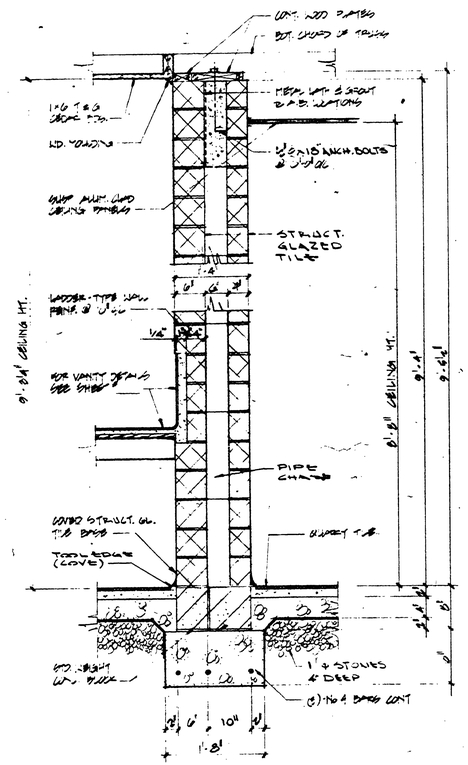

• SECTION • 6 A-4 1" : ONE FOOT

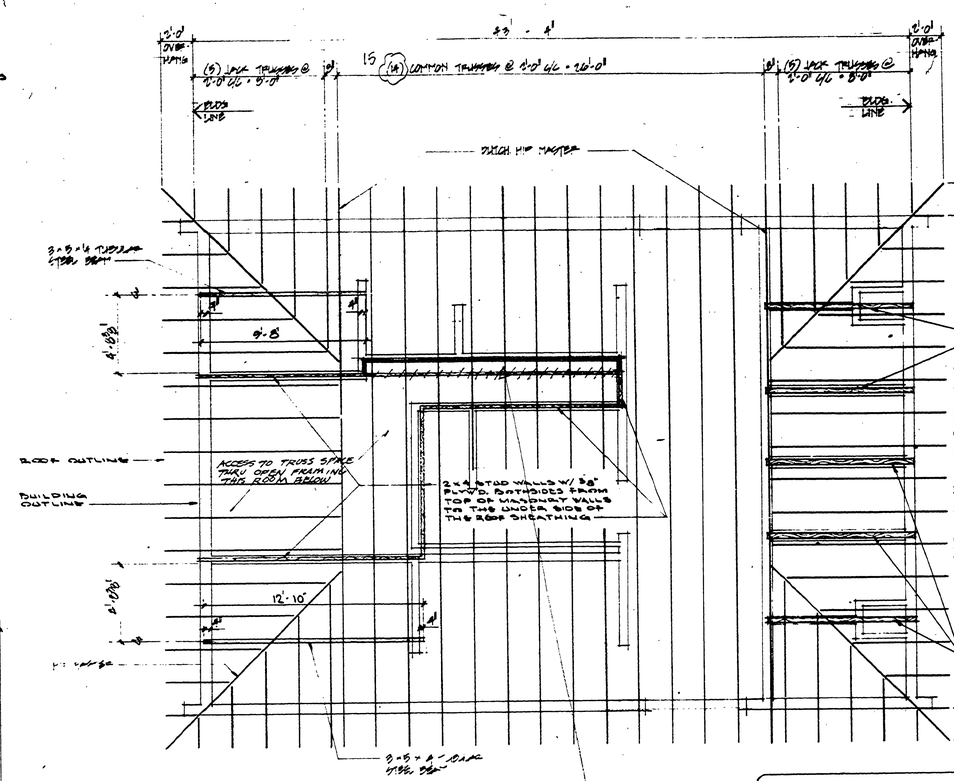

• ROOF FRAMING PLAN • 1/4" : ONE FOOT

STUD WALL MOVED TO SIT ON BLOCK WALL

TRUSS DESIGN LOADING

LIVE LOAD ... 40 PSF
DEAD LOAD ... 10 PSF
TOTAL LOAD ... 50 PSF

• 15% ALLOWABLE STRESS INCREASE IN LUMBER FOR LIVE LOAD ONLY.

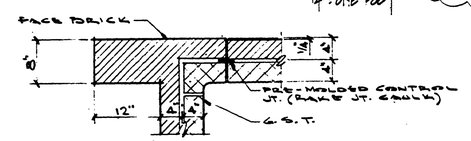

• SECTION • 8 A-4

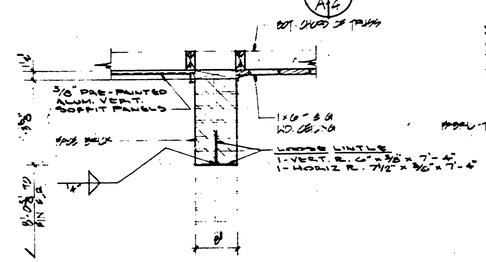

• SECTION • 7 A-4 1" : ONE FOOT

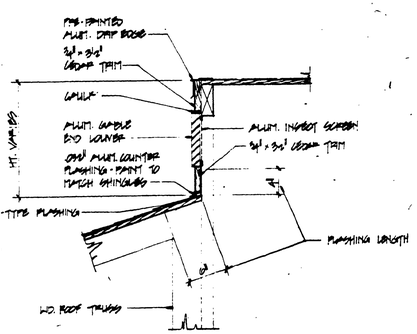

• SECTION • 9 A-4 1" : ONE FOOT

SURVEYED BY		DRAWN BY		NO.	DATE	BY	REVISIONS
DESIGNED BY		CHECKED BY		1.			
DATE		DATE		2.			

QUALITY OF LIFE RECREATIONAL BOND
ACCT. NO. 607-75-2450-400

MICHIGAN
DEPARTMENT OF NATURAL RESOURCES

STATE OF MICHIGAN
DEPARTMENT OF MANAGEMENT AND BUDGET
Office of Facilities

AREA OR PARK: ALGONAC STATE PARK
PROJECT: TOILET AND SHOWER BUILDING
SHEET: A-4
PROJECT NO. 9002
DATE: 3/[illegible]/70
PLAN NO. L-114