N-1634 CAPITAL CITY BP 1000H 50U 6-75 69039M

LOCATION

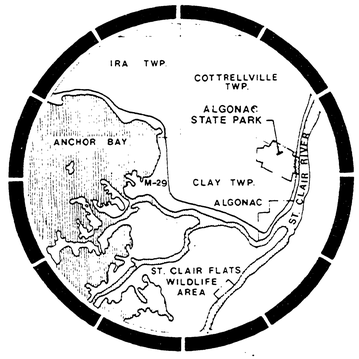

VICINITY

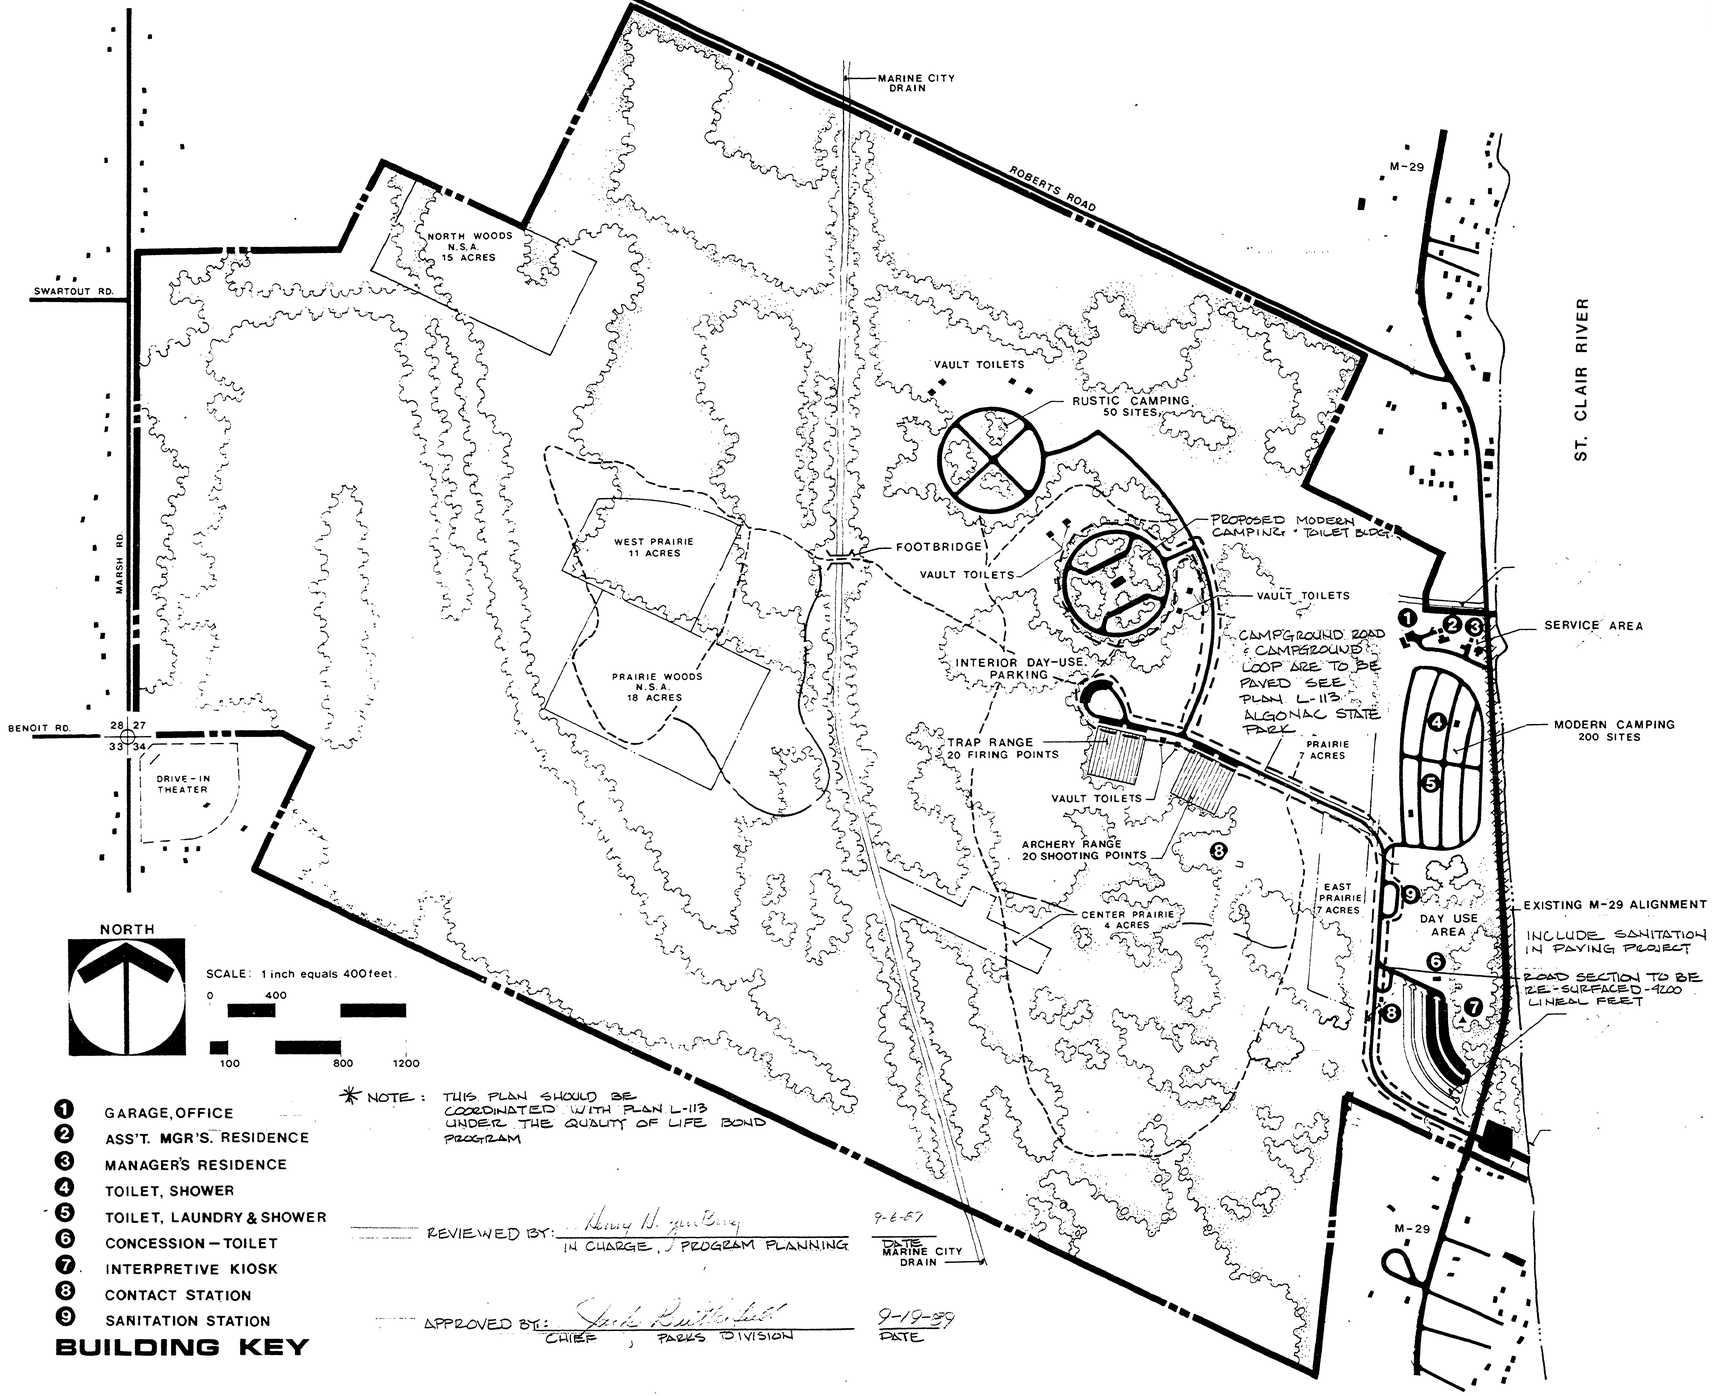

NORTH

SCALE: 1 inch equals 400 feet.

0 400 100 800 1200

- PROPOSED TRAIL
- 3 BUILDING KEY NUMBER
- BUILDING
- PARKING LOT
- PROPOSED BUILDING
- EXISTING TRAIL
- ROAD
- NATURAL AREA BOUNDARY
- VEGETATION
- PROPOSED ROAD
- PARK BOUNDARY

LEGEND

1. GARAGE, OFFICE
2. ASS'T. MGR'S. RESIDENCE
3. MANAGER'S RESIDENCE
4. TOILET, SHOWER
5. TOILET, LAUNDRY & SHOWER
6. CONCESSION – TOILET
7. INTERPRETIVE KIOSK
8. CONTACT STATION
9. SANITATION STATION

BUILDING KEY

✳ NOTE: THIS PLAN SHOULD BE COORDINATED WITH PLAN L-113 UNDER THE QUALITY OF LIFE BOND PROGRAM

REVIEWED BY: Henry W. [illegible] 9-6-87
IN CHARGE, PROGRAM PLANNING — DATE
MARINE CITY DRAIN

APPROVED BY: [illegible] 9-19-89
CHIEF, PARKS DIVISION — DATE

SURVEYED BY	DRAWN BY	NO.	DATE	BY	REVISIONS	NO.	DATE	BY	REVISIONS	MICHIGAN DEPARTMENT OF NATURAL RESOURCES	BITUMINOUS ROAD SURFACING	ALGONAC STATE PARK	PROJECT NO.
DESIGNED BY	CHECKED BY	1.	1974		Boundary Revised	3.						QUALITY OF LIFE BOND 1ST YEAR	SHEET 1 OF 1 PLAN NO L-114
DATE	DATE	2.	4-87		UPDATE BOAT LAUNCH	4.							