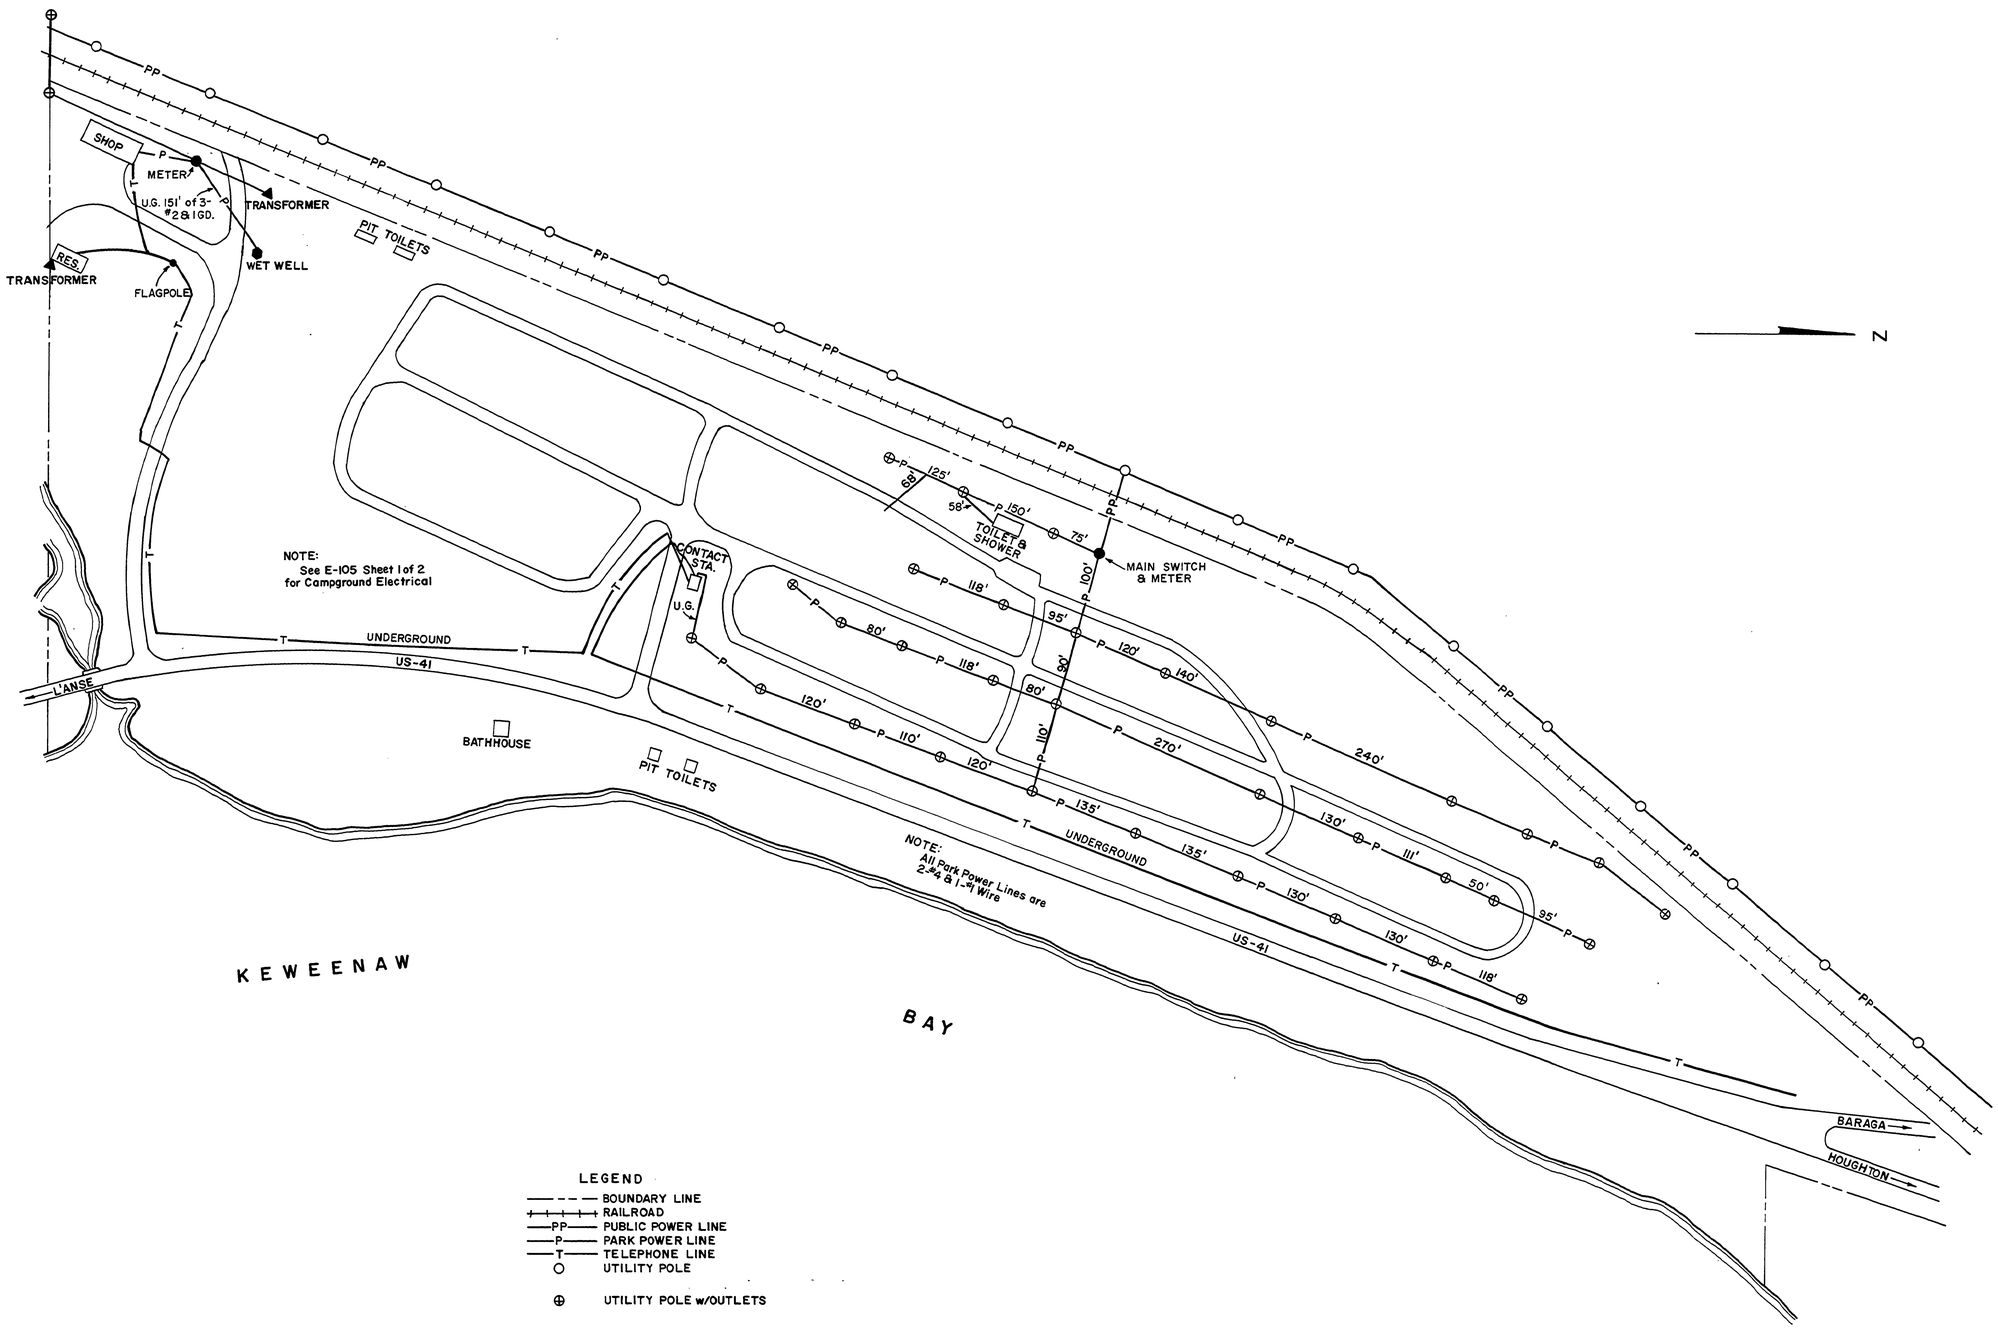

SURVEYED BY		DRAWN BY		NO.	DATE	BY	REVISIONS	NO.	DATE	BY	REVISIONS
DESIGNED BY		CHECKED BY		1.	4-71	D.B.	REDRAWN	3.			
	DATE		DATE	2.	3-82	D.B.	ADDED INFO	4.			

MICHIGAN
DEPARTMENT OF NATURAL RESOURCES

POWER, TELEPHONE
SHEET TITLE

AREA OR PARK: BARAGA STATE PARK
PROJECT

PROJECT NO.
SHEET 2 OF 3
PLAN NO. U-1