


CONSTRUCTION PLANS FOR FOOT BRIDGE IMPROVEMENTS BAY CITY STATE PARK

QUALITY OF LIFE RECREATION BOND PROGRAM
UPPER EAST MICHIGAN REGION

MICHIGAN DEPARTMENT OF NATURAL RESOURCES
PARKS DIVISION

ACCT. NO. 607-75-2450-400

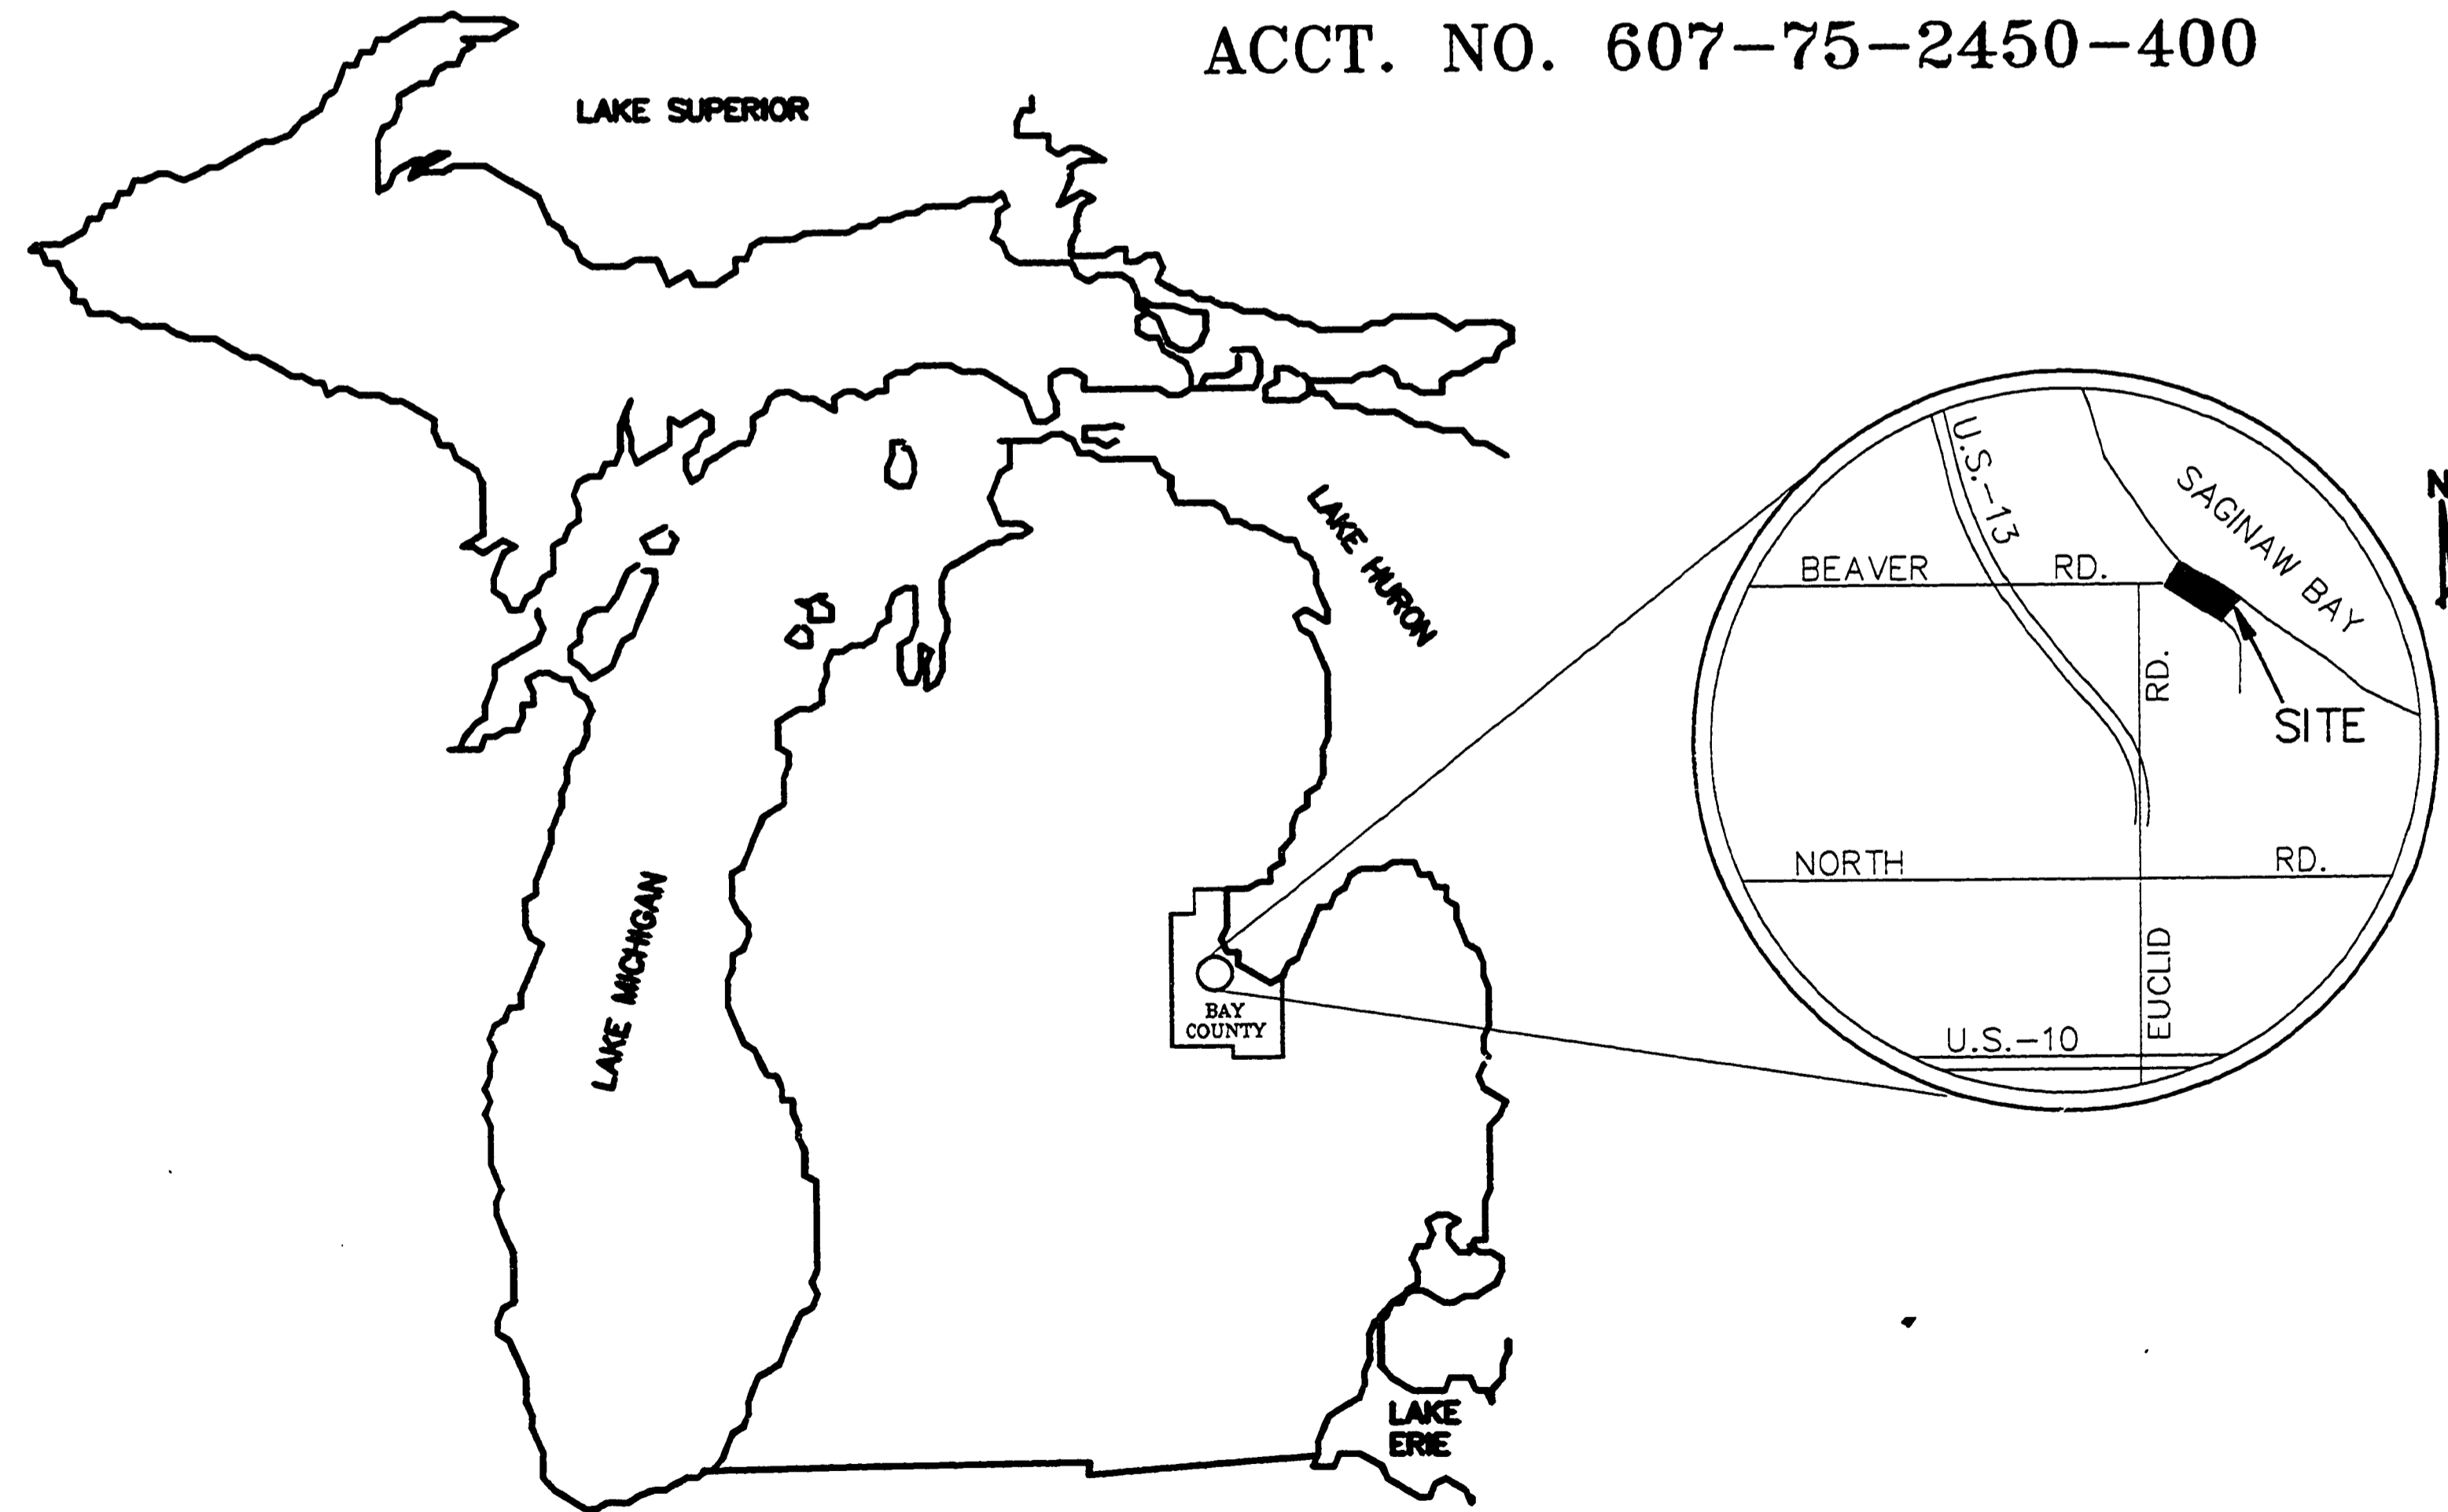

LIST OF DRAWINGS

1. TITLE SHEET
2. FOOT BRIDGE SITE PLAN
3. FOOT BRIDGE DETAILS



Heartland
Professional Construction Services Inc.
1800 Michigan National Tower • Lansing, Michigan 48933 • 517-482-6100

Capital Consultants, Inc.
ENGINEERS
820 N. WASHINGTON AVE. LANSING, MICHIGAN 48906 TELEPHONE 517-371-1200

STATE OF MICHIGAN
DEPARTMENT OF MANAGEMENT AND BUDGET
Office of Facilities

STATE OF MICHIGAN
DEPARTMENT OF NATURAL RESOURCES
APPROVED BY: *Henry VanBuren*
CHIEF, PARKS DIVISION
7-26-91
DATE

L-122
SHEET

1 of 3

BAY CITY STATE PARK - SITE AND UTILITY IMPROVEMENTS

* RECORD NOTATIONS *