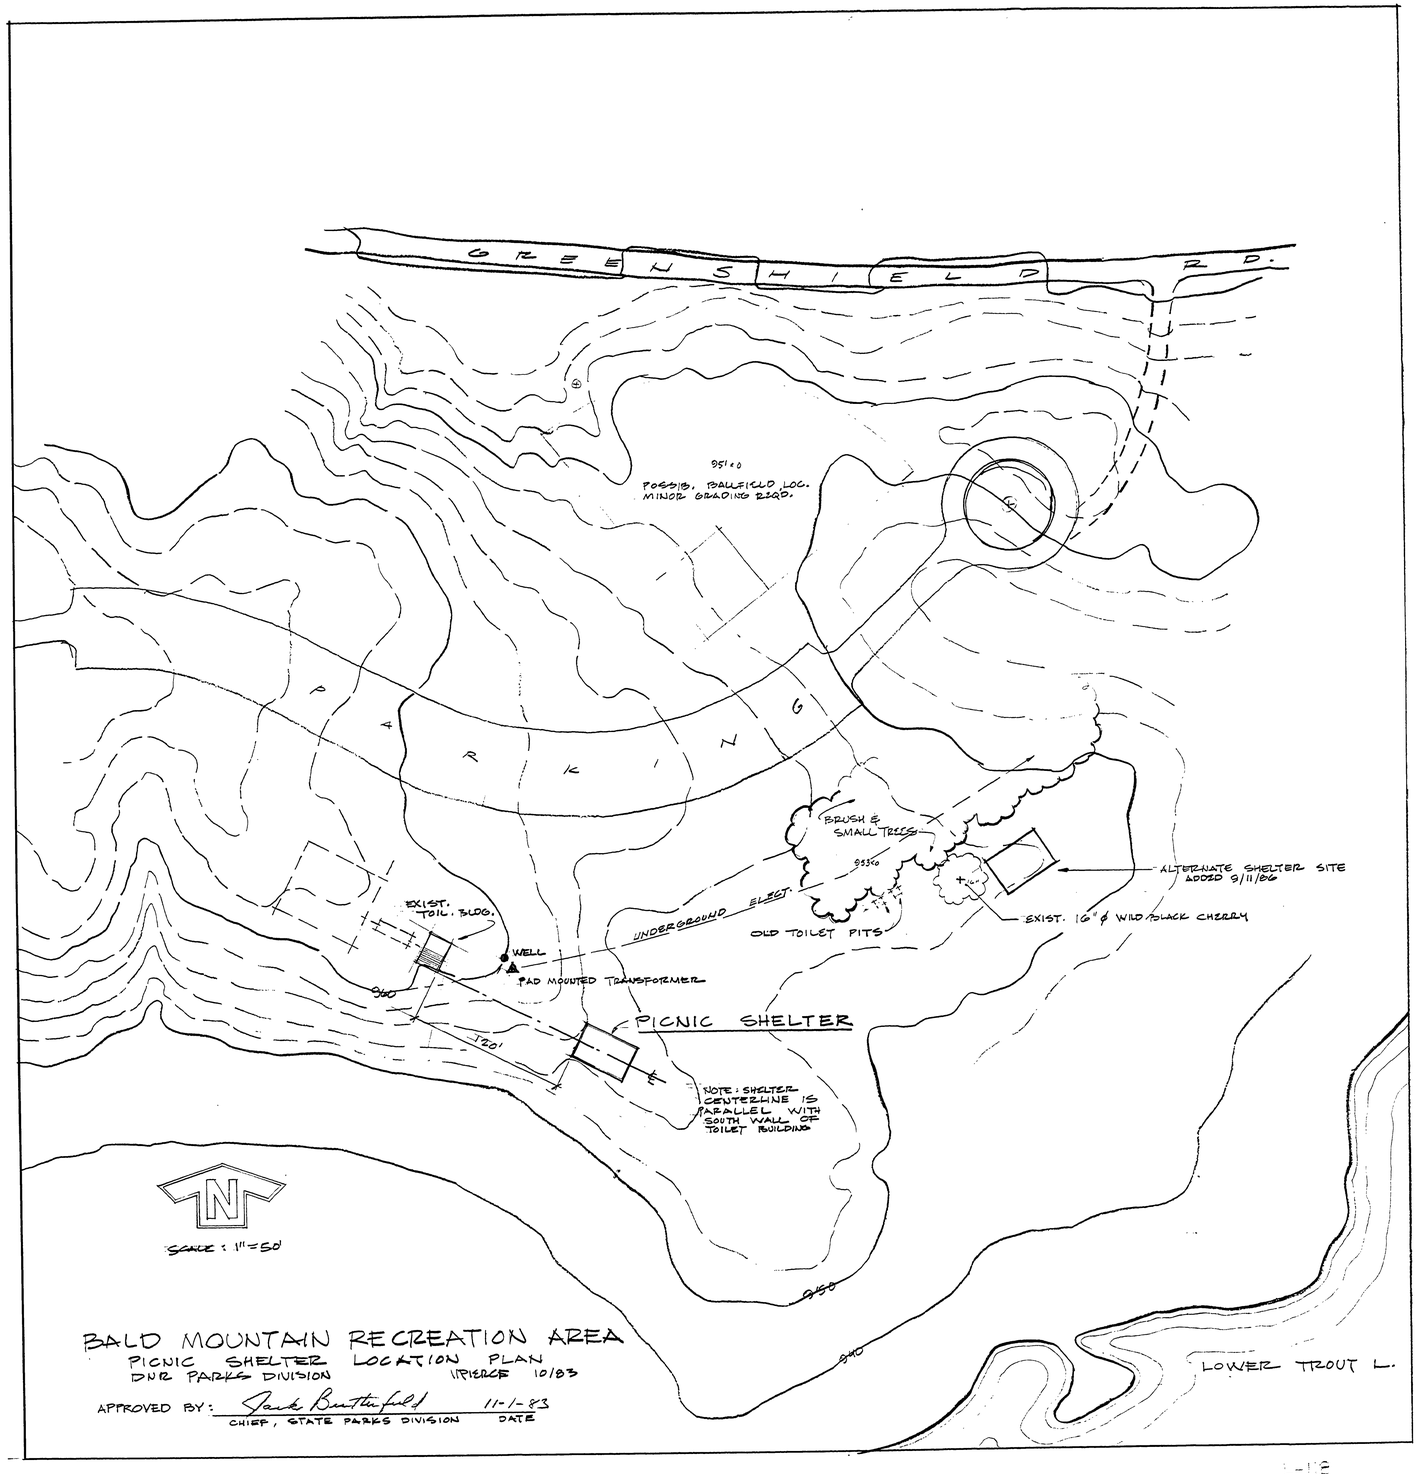

BALD MOUNTAIN RECREATION AREA
PICNIC SHELTER LOCATION PLAN
DNR PARKS DIVISION 1/PIERCE 10/83

APPROVED BY: Jack Butterfield 11-1-83
CHIEF, STATE PARKS DIVISION DATE