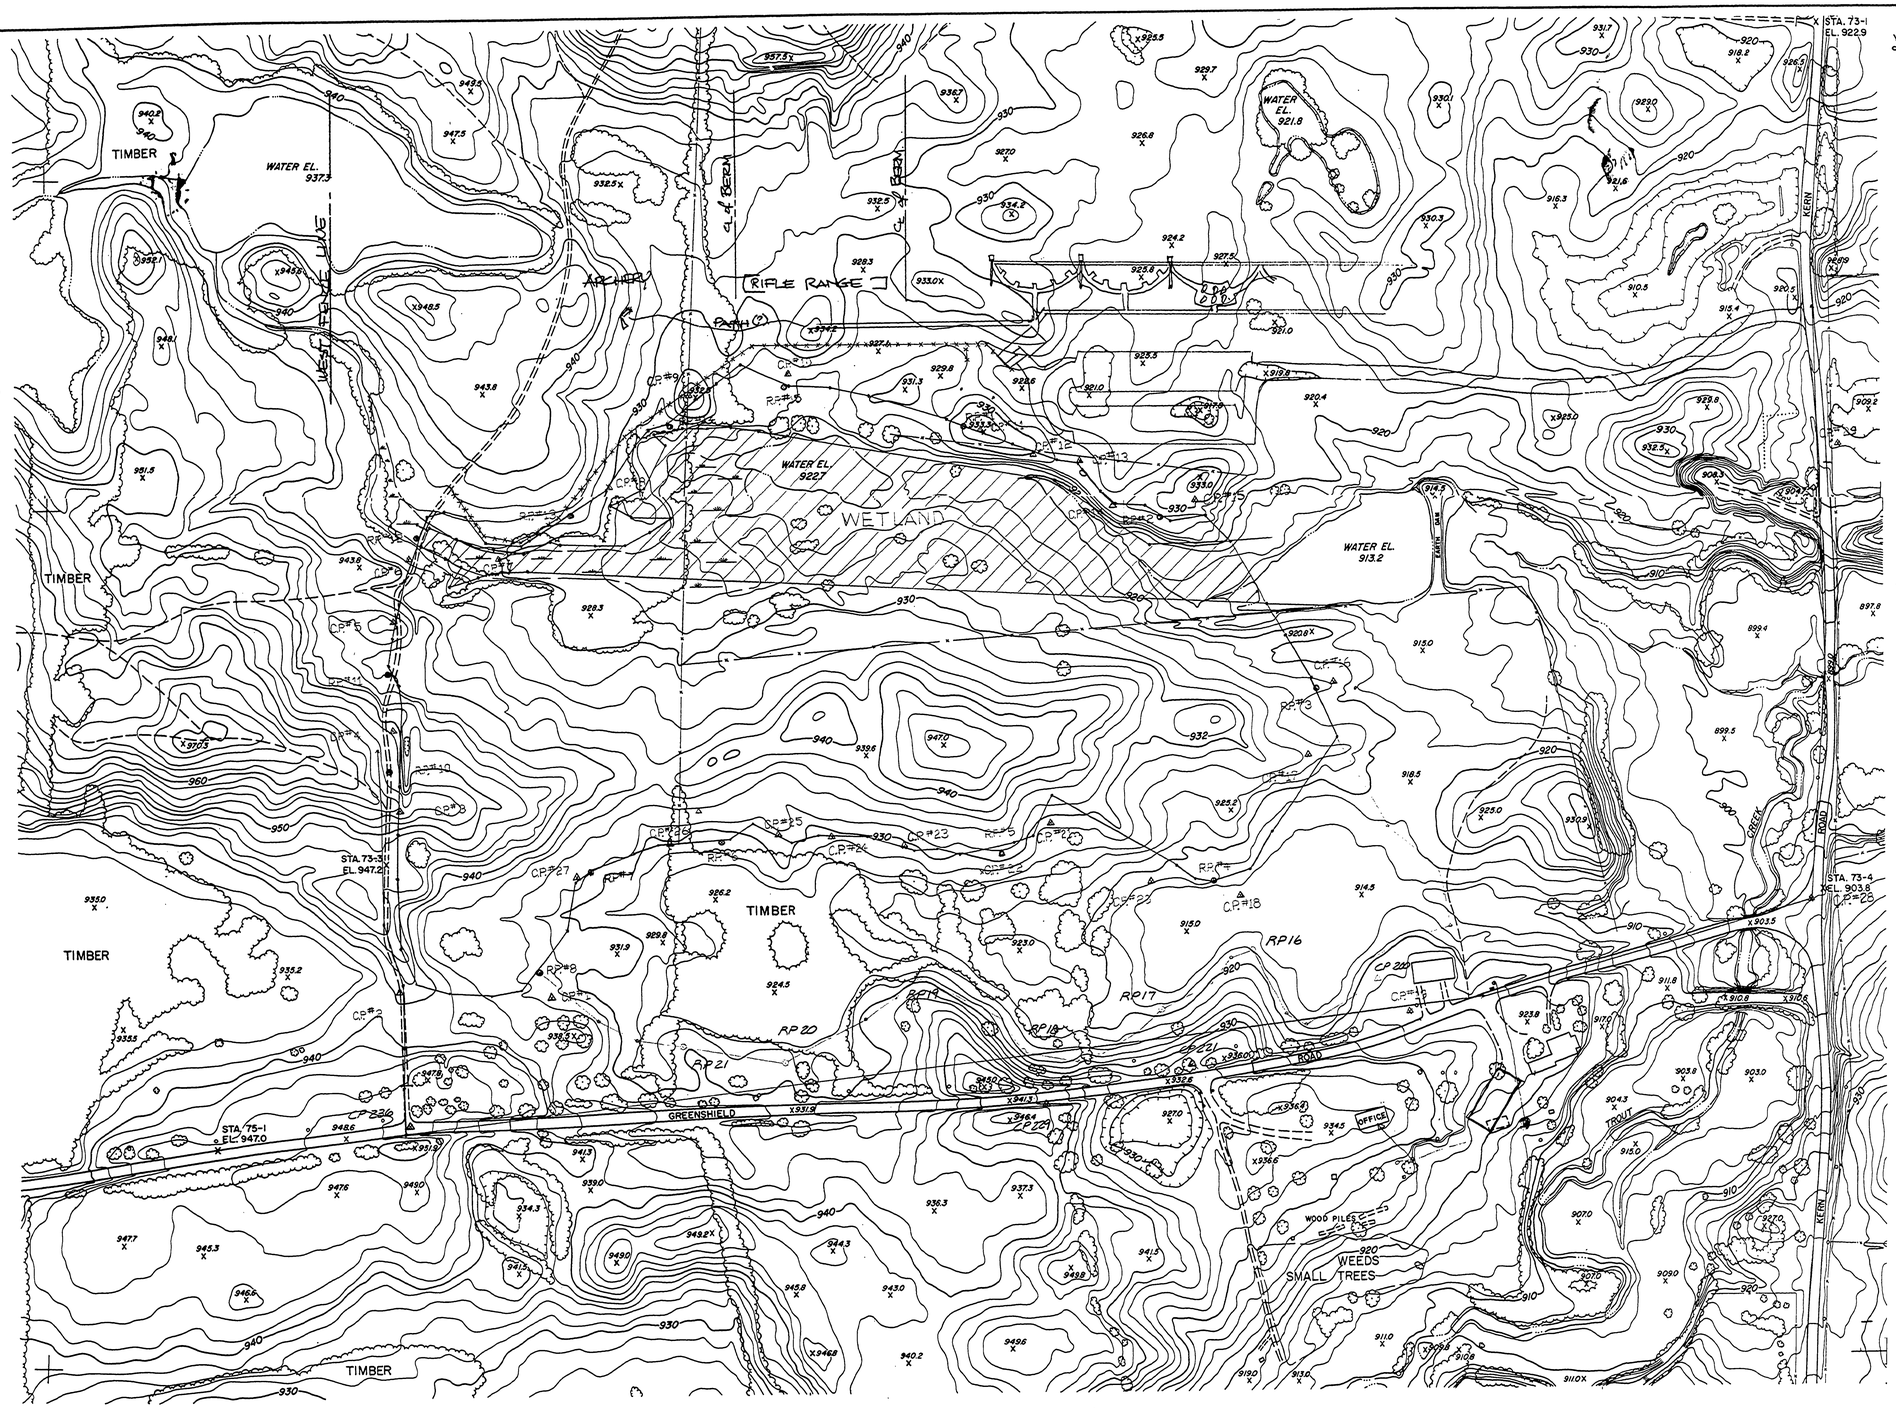

SURVEYED BY	HOITENGA	1-95	DRAWN BY	WRIGHT	1-26-95	NO.	DATE	BY	REVISIONS	NO.	DATE	BY	REVISIONS	MICHIGAN DEPARTMENT OF NATURAL RESOURCES	BALD MOUNTAIN SPORTING CLAYS SHEET TITLE
DESIGNED BY			CHECKED BY			1.	3-95	D.M.	SOUTH ALIGNMENT ADDED	3.					
		DATE			DATE	2.				4.					

AREA OR PARK: BALD MOUNTAIN R.A.
PROJECT: SPORTING CLAYS COURSE
PROJECT NO. 24-1484
SHEET 1 OF 1
PLAN NO. E-122