


DESIGNED BY	DATE	REVIEWED	DATE	APPROVED	DATE	NO.	DATE	BY	REVISIONS
DRIVEN BY	S.S.	ARCHITECTURAL				1			4
CHECKED BY		ENGINEERING				2			5
		LANDSCAPE				3			6

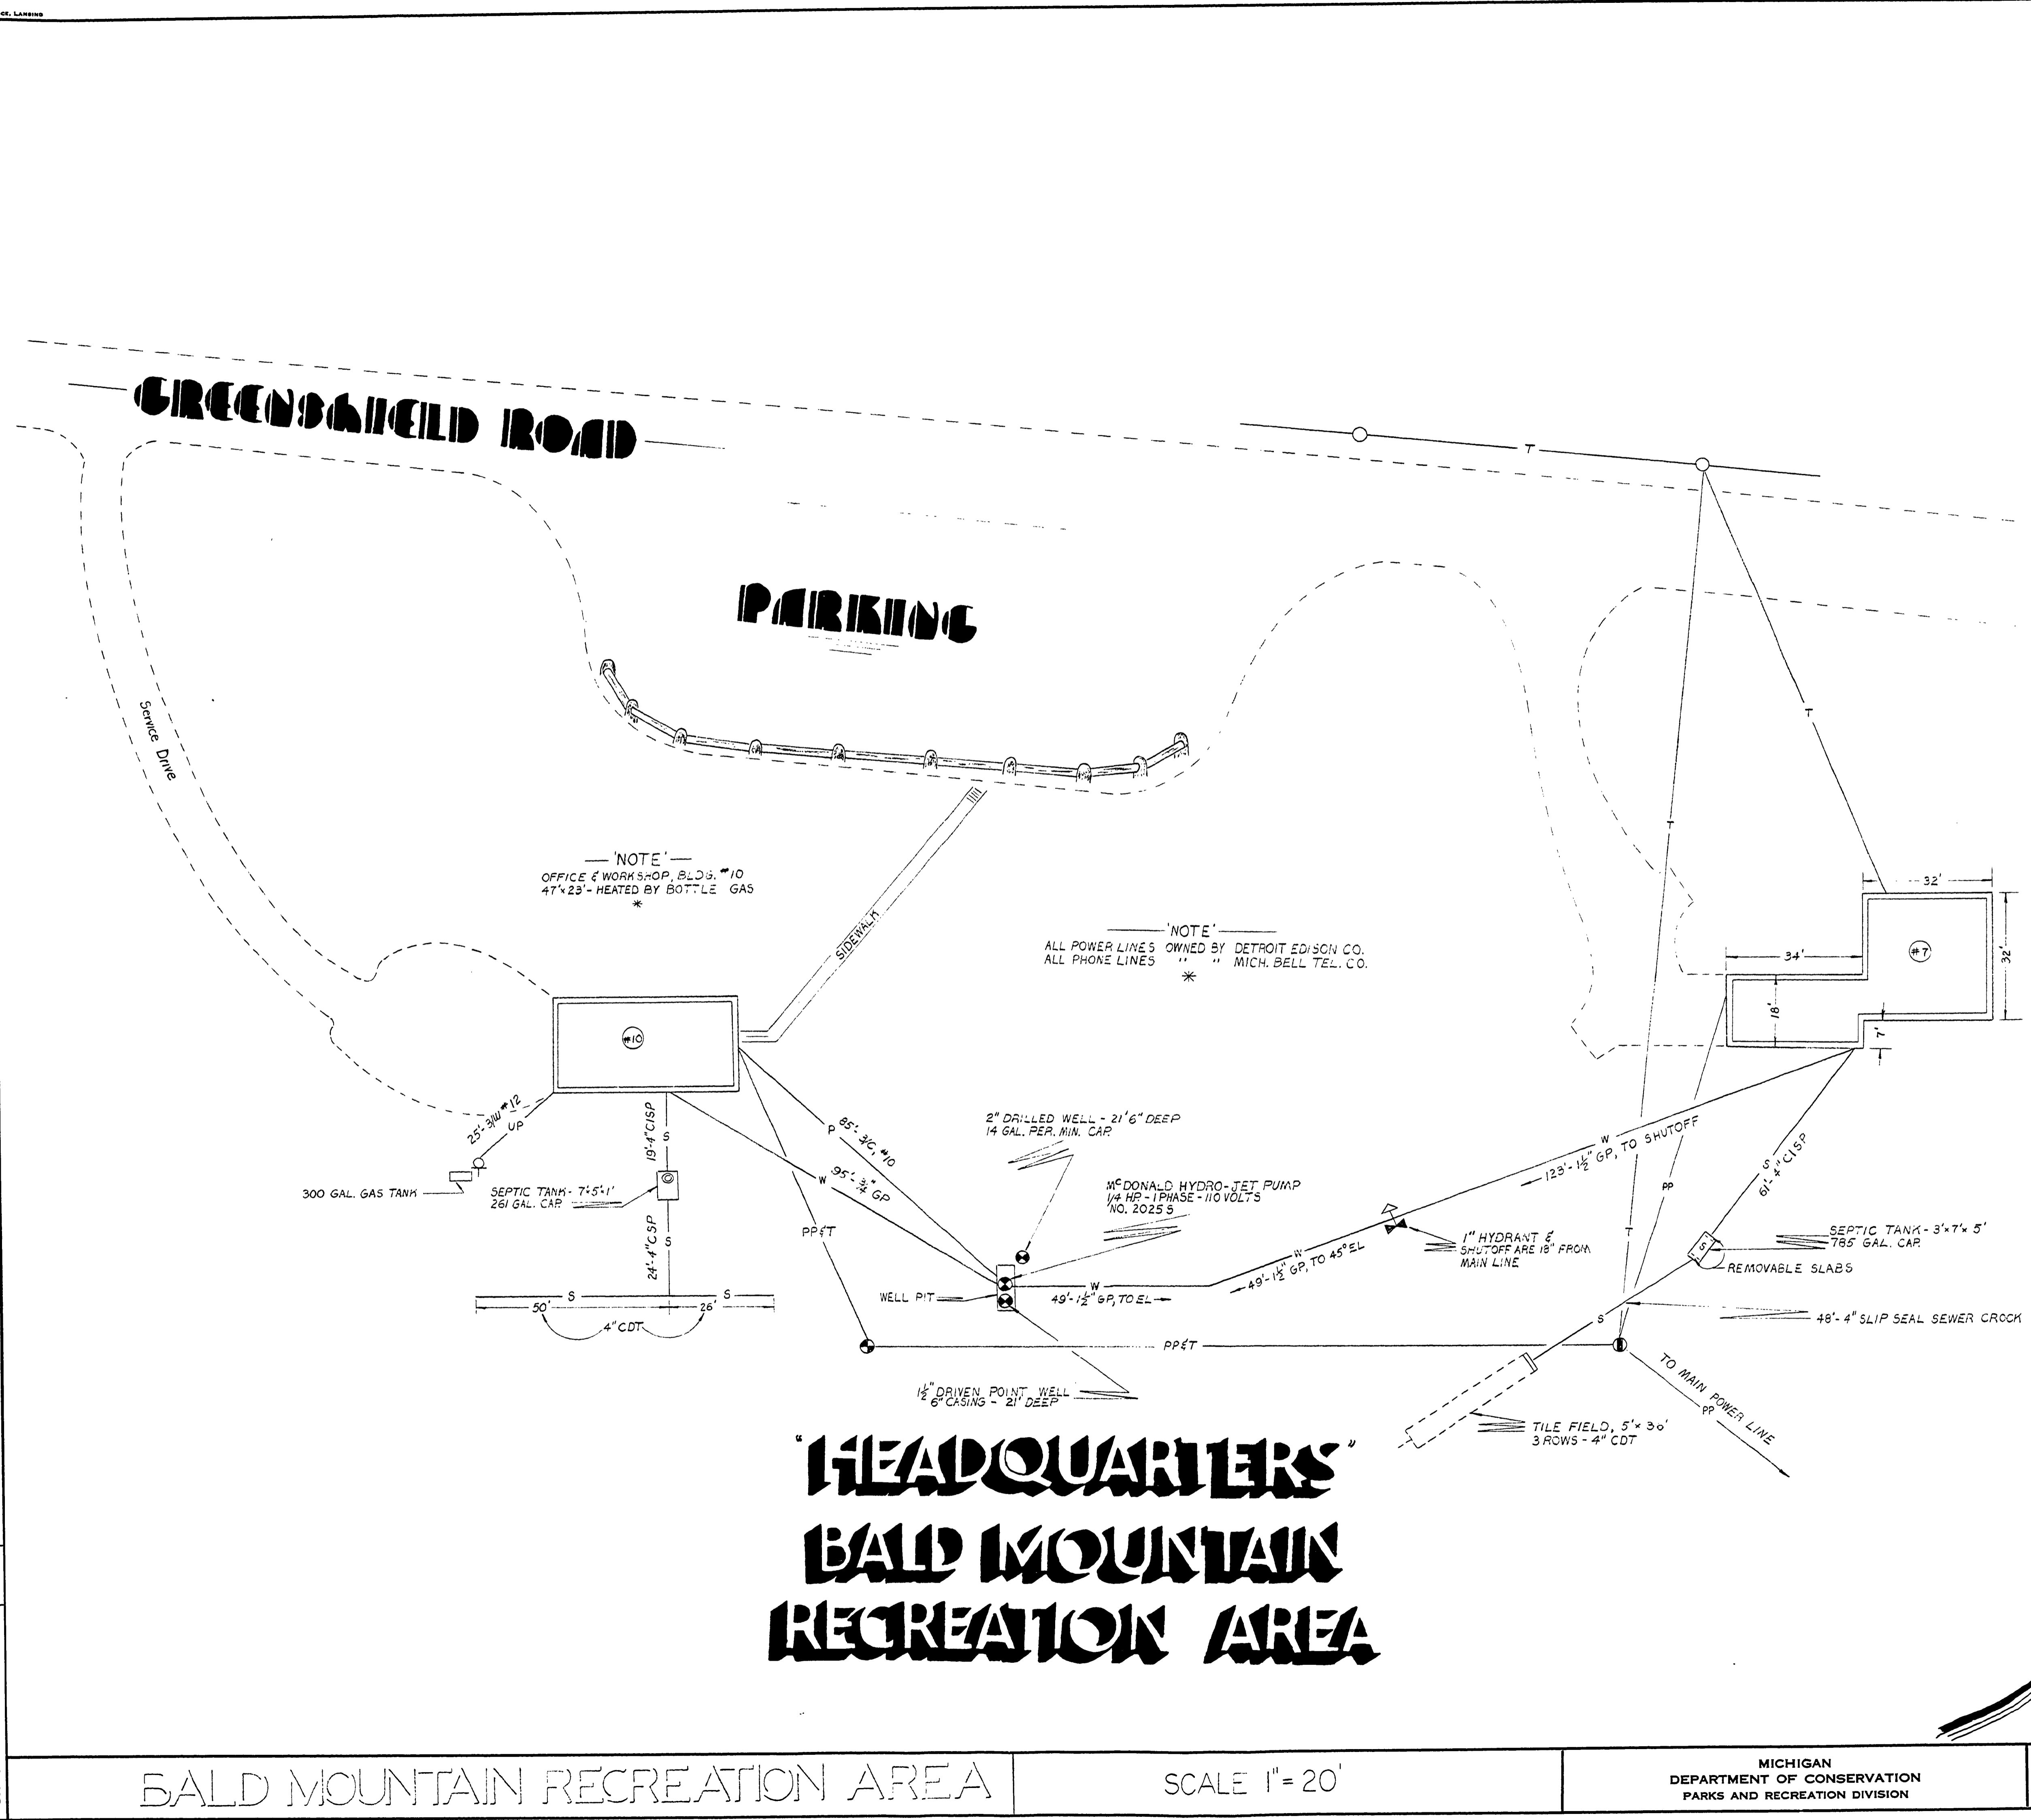

SYMBOL	LEGEND
PP	PUBLIC POWER LINE
P	POWER LINE
T	TELEPHONE LINE
PP&T	PUBLIC POWER & TELEPHONE LINE
UP	UNDERGROUND POWER LINE
W	WATER LINE
S	SEWAGE LINE
GP	GALVANIZED PIPE
CISP	CAST IRON SEWER PIPE
CDT	CLAY DRAIN TILE
CSP	CLAY SEWER PIPE
○	WELL
⊙	PUMP
⊕	UTILITY POLE "WATER"
⊕	" " "TRANSFORMER"
⊕	" " " "
⊕	MANHOLE
⊕	SHUTOFF VALVE
⊕	WATER HYDRANT
⊕	GAS PUMP

DO NOT USE -
SEE 3/87
REVISION

BALD MOUNTAIN RECREATION AREA

SCALE 1" = 20'

MICHIGAN
DEPARTMENT OF CONSERVATION
PARKS AND RECREATION DIVISION

BALD MOUNTAIN RECREATION AREA
UTILITY MAP
WATER, SEWAGE & ELECTRICAL DISTRIBUTION SYSTEM

SHEET
NO. 1
OF 1

PLAN NO.
U-1
R-12