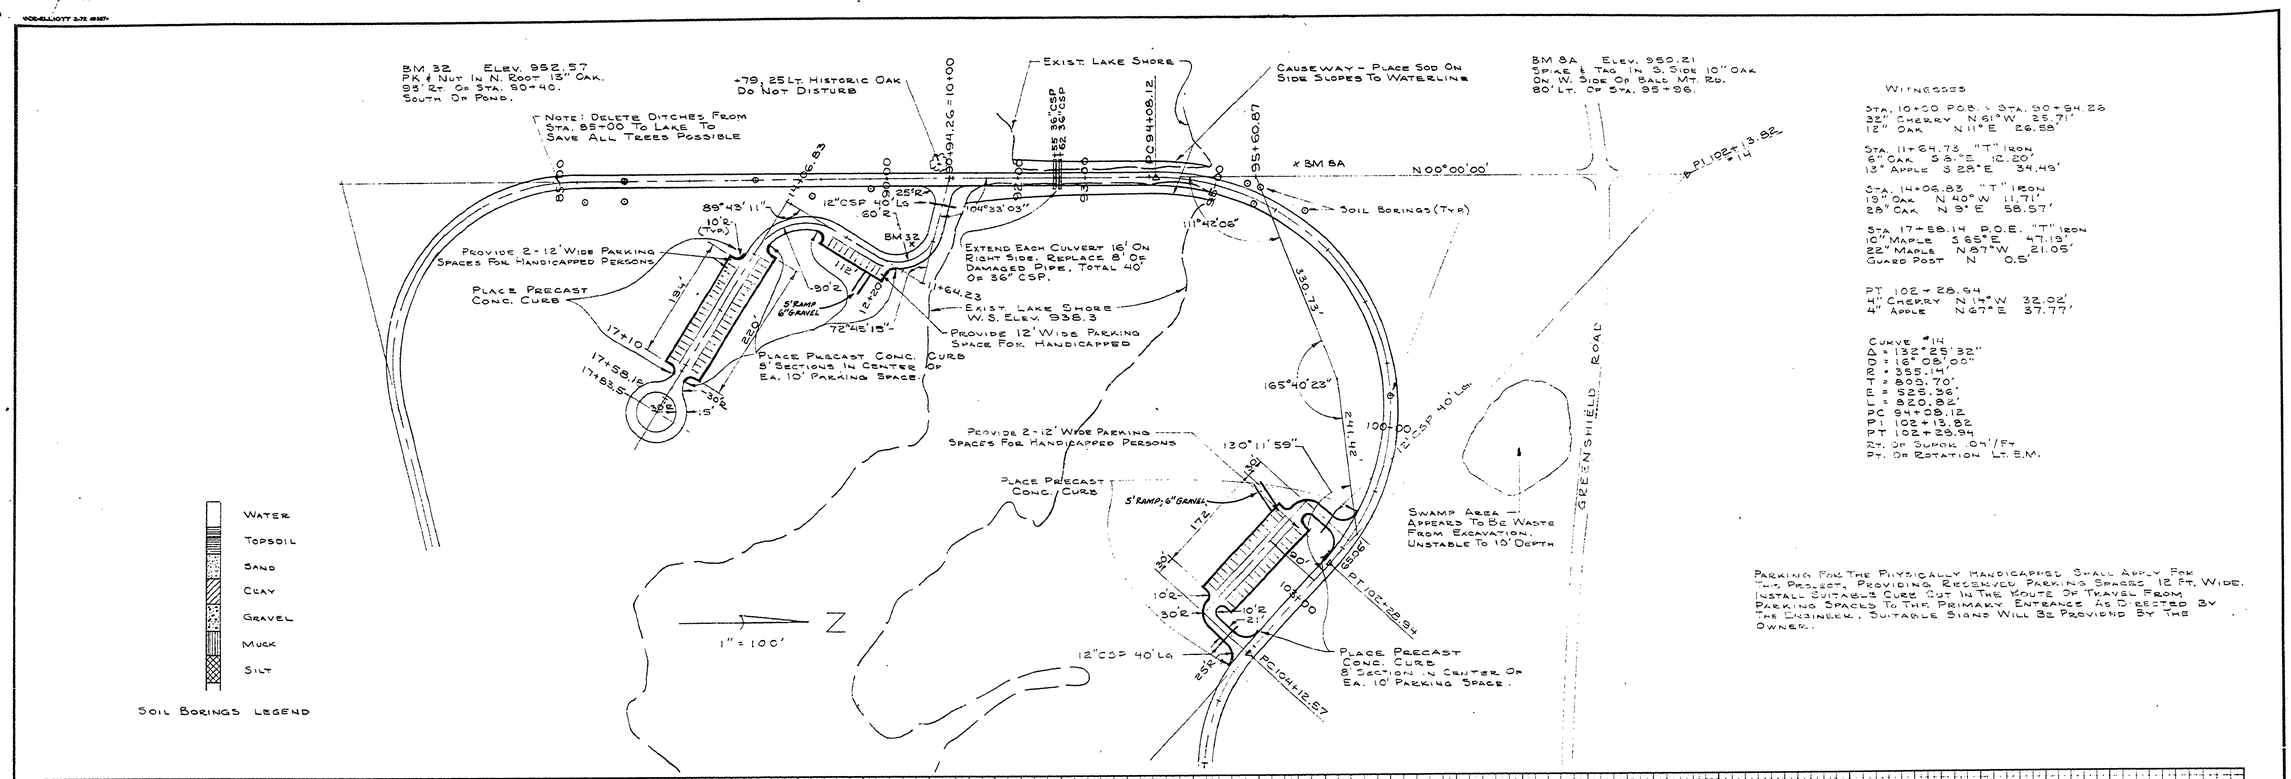

WITNESSES

STA. 10+00 P.O.B. & STA. 90+84.28
32" CHERRY N 61° W 25.71'
12" OAK N 11° E 26.58'

STA. 11+64.73 "T" IRON
6" OAK S 8° E 12.20'
13" APPLE S 28° E 34.49'

STA. 14+06.83 "T" IRON
19" OAK N 40° W 11.71'
28" OAK N 9° E 58.57'

STA. 17+58.14 P.O.E. "T" IRON
10" MAPLE S 65° E 47.19'
22" MAPLE N 87° W 21.05'
GUARD POST N 0.5'

PT 102+28.94
4" CHERRY N 14° W 32.92'
4" APPLE N 67° E 37.77'

CURVE #1
Δ = 132°25'32"
D = 16° 08'00"
R = 355.14'
T = 803.70'
E = 525.36'
L = 820.82'
PC 94+28.12
PI 102+13.82
PT 102+28.94
RT. OF SUPER .04'/FT.
PT. OF ROTATION LT. E.M.

PARKING FOR THE PHYSICALLY HANDICAPPED SHALL APPLY FOR THIS PROJECT, PROVIDING RESERVED PARKING SPACES 12 FT. WIDE. INSTALL SUITABLE CURB CUT IN THE ROUTE OF TRAVEL FROM PARKING SPACES TO THE PRIMARY ENTRANCE AS DIRECTED BY THE ENGINEER. SUITABLE SIGNS WILL BE PROVIDED BY THE OWNER.

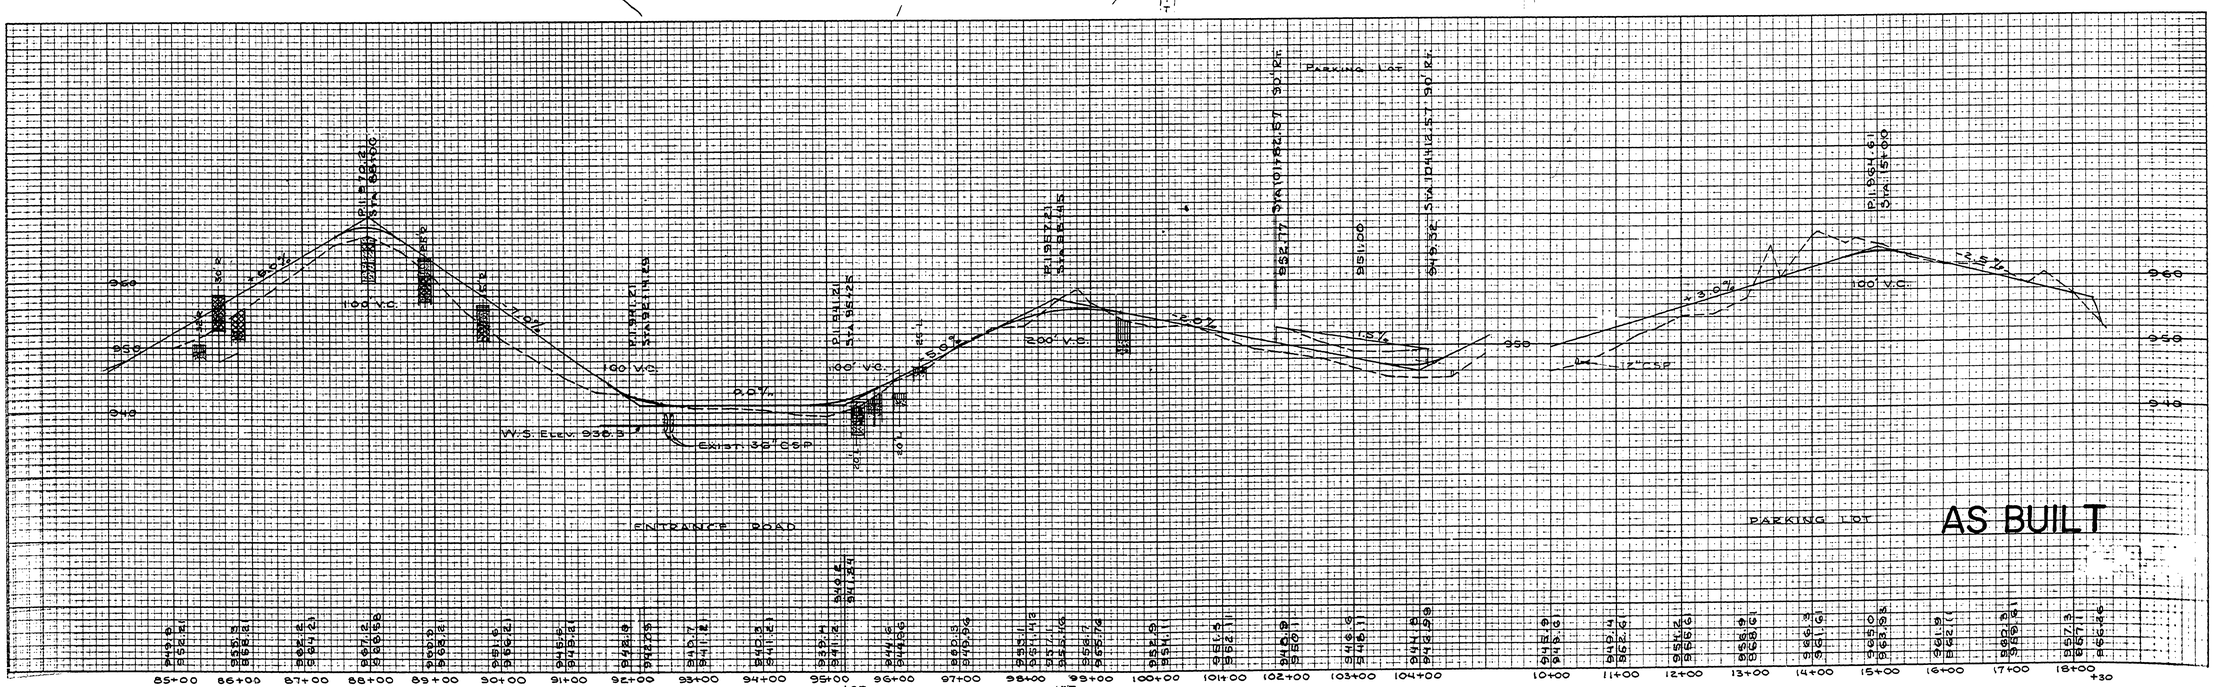

SURVEYED BY		DRAWN BY J. YPMA	MAR. '75
DESIGNED BY R. H. MERRILL	MAR '75 DATE	CHECKED BY	DATE

NO.	DATE	BY	REVISIONS	NO.	DATE	BY	REVISIONS
1.	6-13-75	J.Y	HANDICAPPED PARKING ADDED	3.	8-80	D.B.	AS BUILT WAS 3 OF 4
2.	11-14-75	J.Y	GRADE CHG. AT CAUSEWAY (-1')	4.			

MICHIGAN
DEPARTMENT OF NATURAL RESOURCES

ENTRANCE ROAD
STA. 85+00 TO STA. 104+00

SHEET NO. 3 OF 4
FOR PROJECT NO. 24-1173
DAY USE EXPANSION

BALD MOUNTAIN RECREATION AREA
SHEET 1 OF 2 PLAN NO. E-1175 AB