STATE LAW ACT 53
THREE FULL
WORKING DAYS
BEFORE YOU DIG
CALL MISS DIG
TOLL FREE
1-800-482-7171

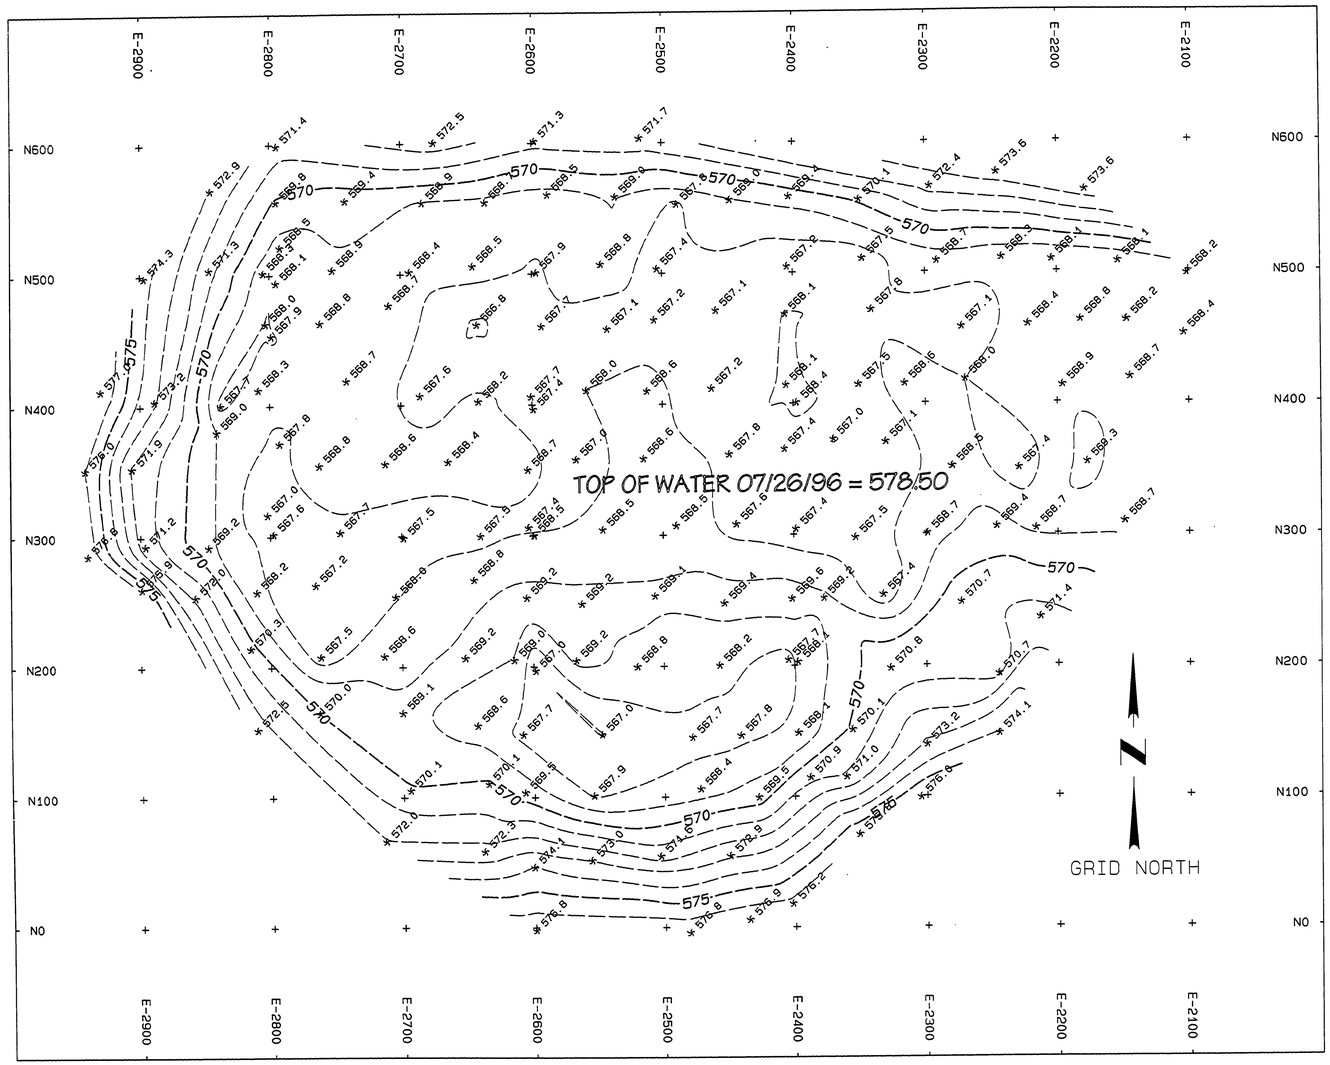

NOTES:

GRID SHOWN IS REFERENCED TO CONTROL POINTS 8 AND 9 PER PROJECT #90135 BY CAPITOL CONSULTANTS, INC., LANSING, MICHIGAN FOR "QUALITY OF LIFE RECREATION BOND - MICHIGAN DEPARTMENT OF NATURAL RESOURCES - PARKS DIVISION - STATE ACCT. NO. 607-75-2450-400".

ELEVATIONS SHOWN REFERENCED TO BENCHMARK DESCRIBED AS "SPIKE IN NORTH SIDE OF 50" COTTONWOOD SOUTHEAST OF R.P. #7 ELEV. = 583.37" PER PLAN SHEET 5 OF 6 OF ABOVE DESCRIBED PROJECT.

*500.0 = SPOT ELEVATION ON TOP OF SILT

---------- TOP OF SILT CONTOURS

FIELD SURVEY PMC DRAFTING DRB CHECKED DRB DATE: 08/12/96	ORIGINAL ISSUE INITIALS DATE	DATE REVISION BY FINAL MEASURE	TOPO F.B. PAGE LEVELS F.B. PAGE	CLIENT ZAP MARINE & SALVAGE, INC. 27950 S. POINTE GROSSE ILE, MICHIGAN 48138	Wade-Trim, Inc. P.O. Box 580 3933 Monitor Road Bay City, Michigan 48707 517-686-3100	TITLE BAY CITY STATE PARK TOBICO LAGOON - AS BUILT AUGUST 8, 1996	SCALE 1" = 50' SHEET 1 OF 2 FILE NO. ELS2060.63B JOB NO. ELS2060.63B

L-135