R-1634 COMMERCIAL BLUEPRINT SERVICE 800 11-74 59902

PLUMBING LEGEND

WASTE PLUMBING

SYMBOLS	ABBREV'S	DESCRIPTION
	V.T.R.	VENT THRU ROOF
	C.O.	CLEANOUT
	F.D.	FLOOR DRAIN
	DN.	DOWN
	W.C.	WATER CLOSET

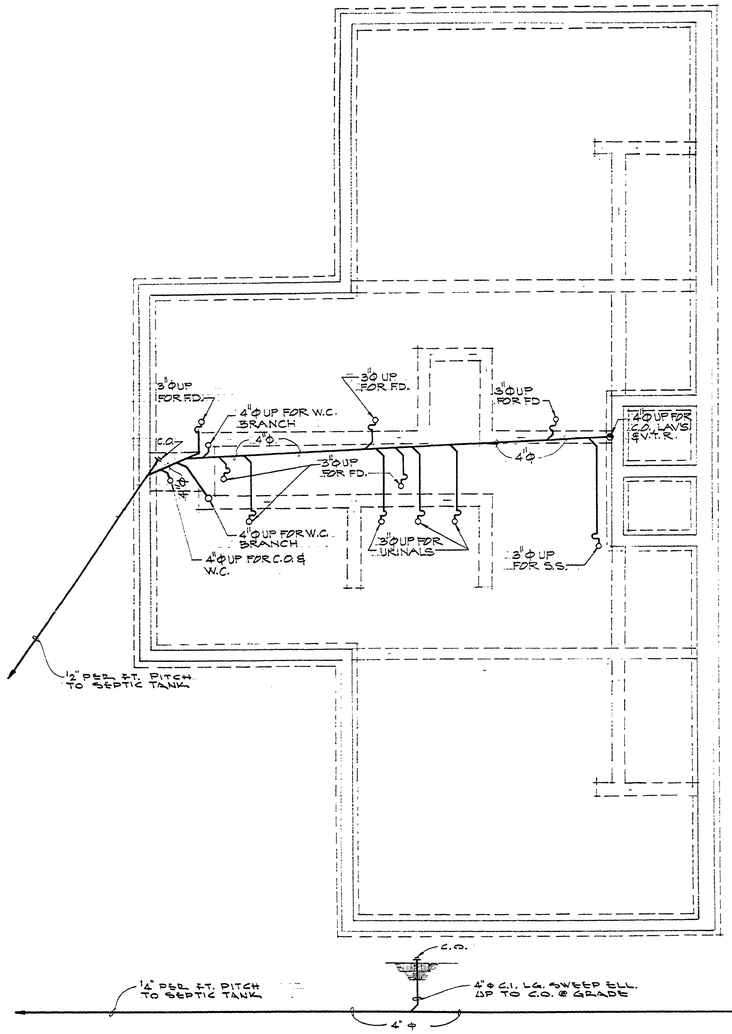

BEACH HOUSE

NO SCALE

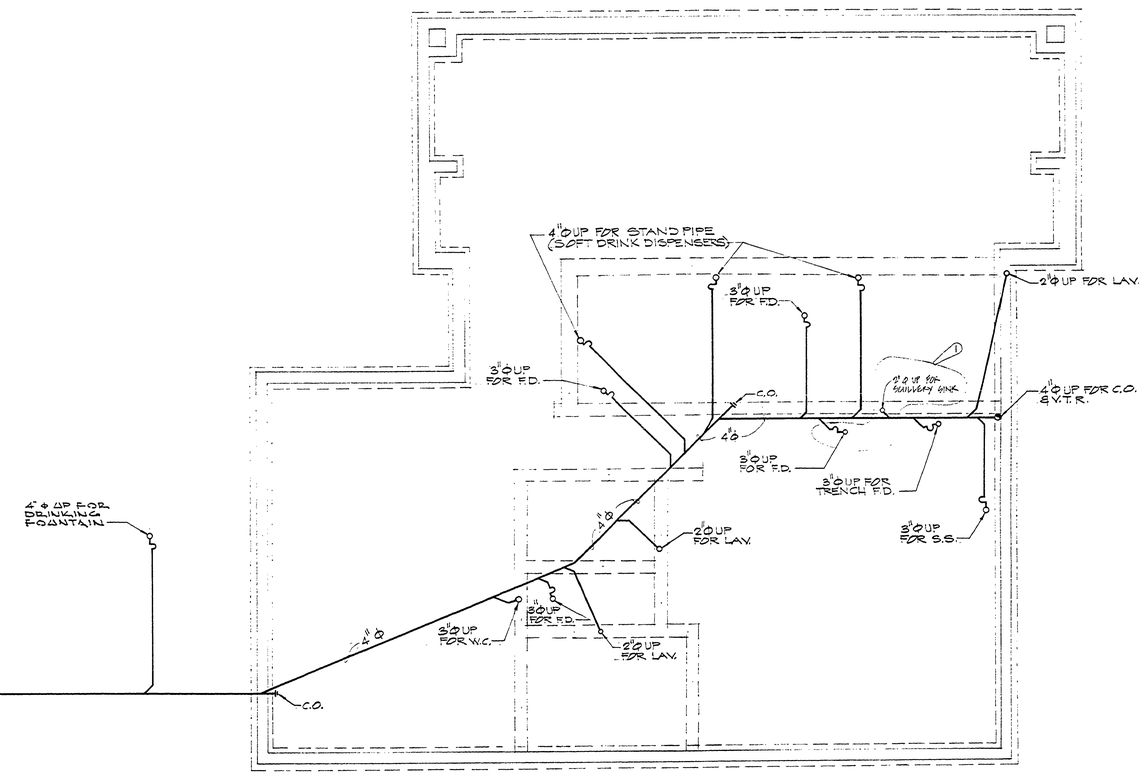

CONCESSION BUILDING

NO SCALE

SURVEYED BY		DRAWN BY DDP & MH.		NO.	DATE	BY	REVISIONS	NO.	DATE	BY	REVISIONS
DESIGNED BY MH		CHECKED BY		1.	9-9-77	MH. & D.P.	SCALLEY SINK WASTE PLUMBING CHANGED TO MEET NEW CODE	3.			
	DATE		DATE	2.				4.			

MICHIGAN
DEPARTMENT OF NATURAL RESOURCES

WASTE PLUMBING - BELOW FIN. FLR.
SHEET TITLE

AREA OR PARK BAY CITY
PROJECT BEACH HOUSE

PROJECT NO. 24-1582
SHEET 33 OF 34
PLAN NO. A-111