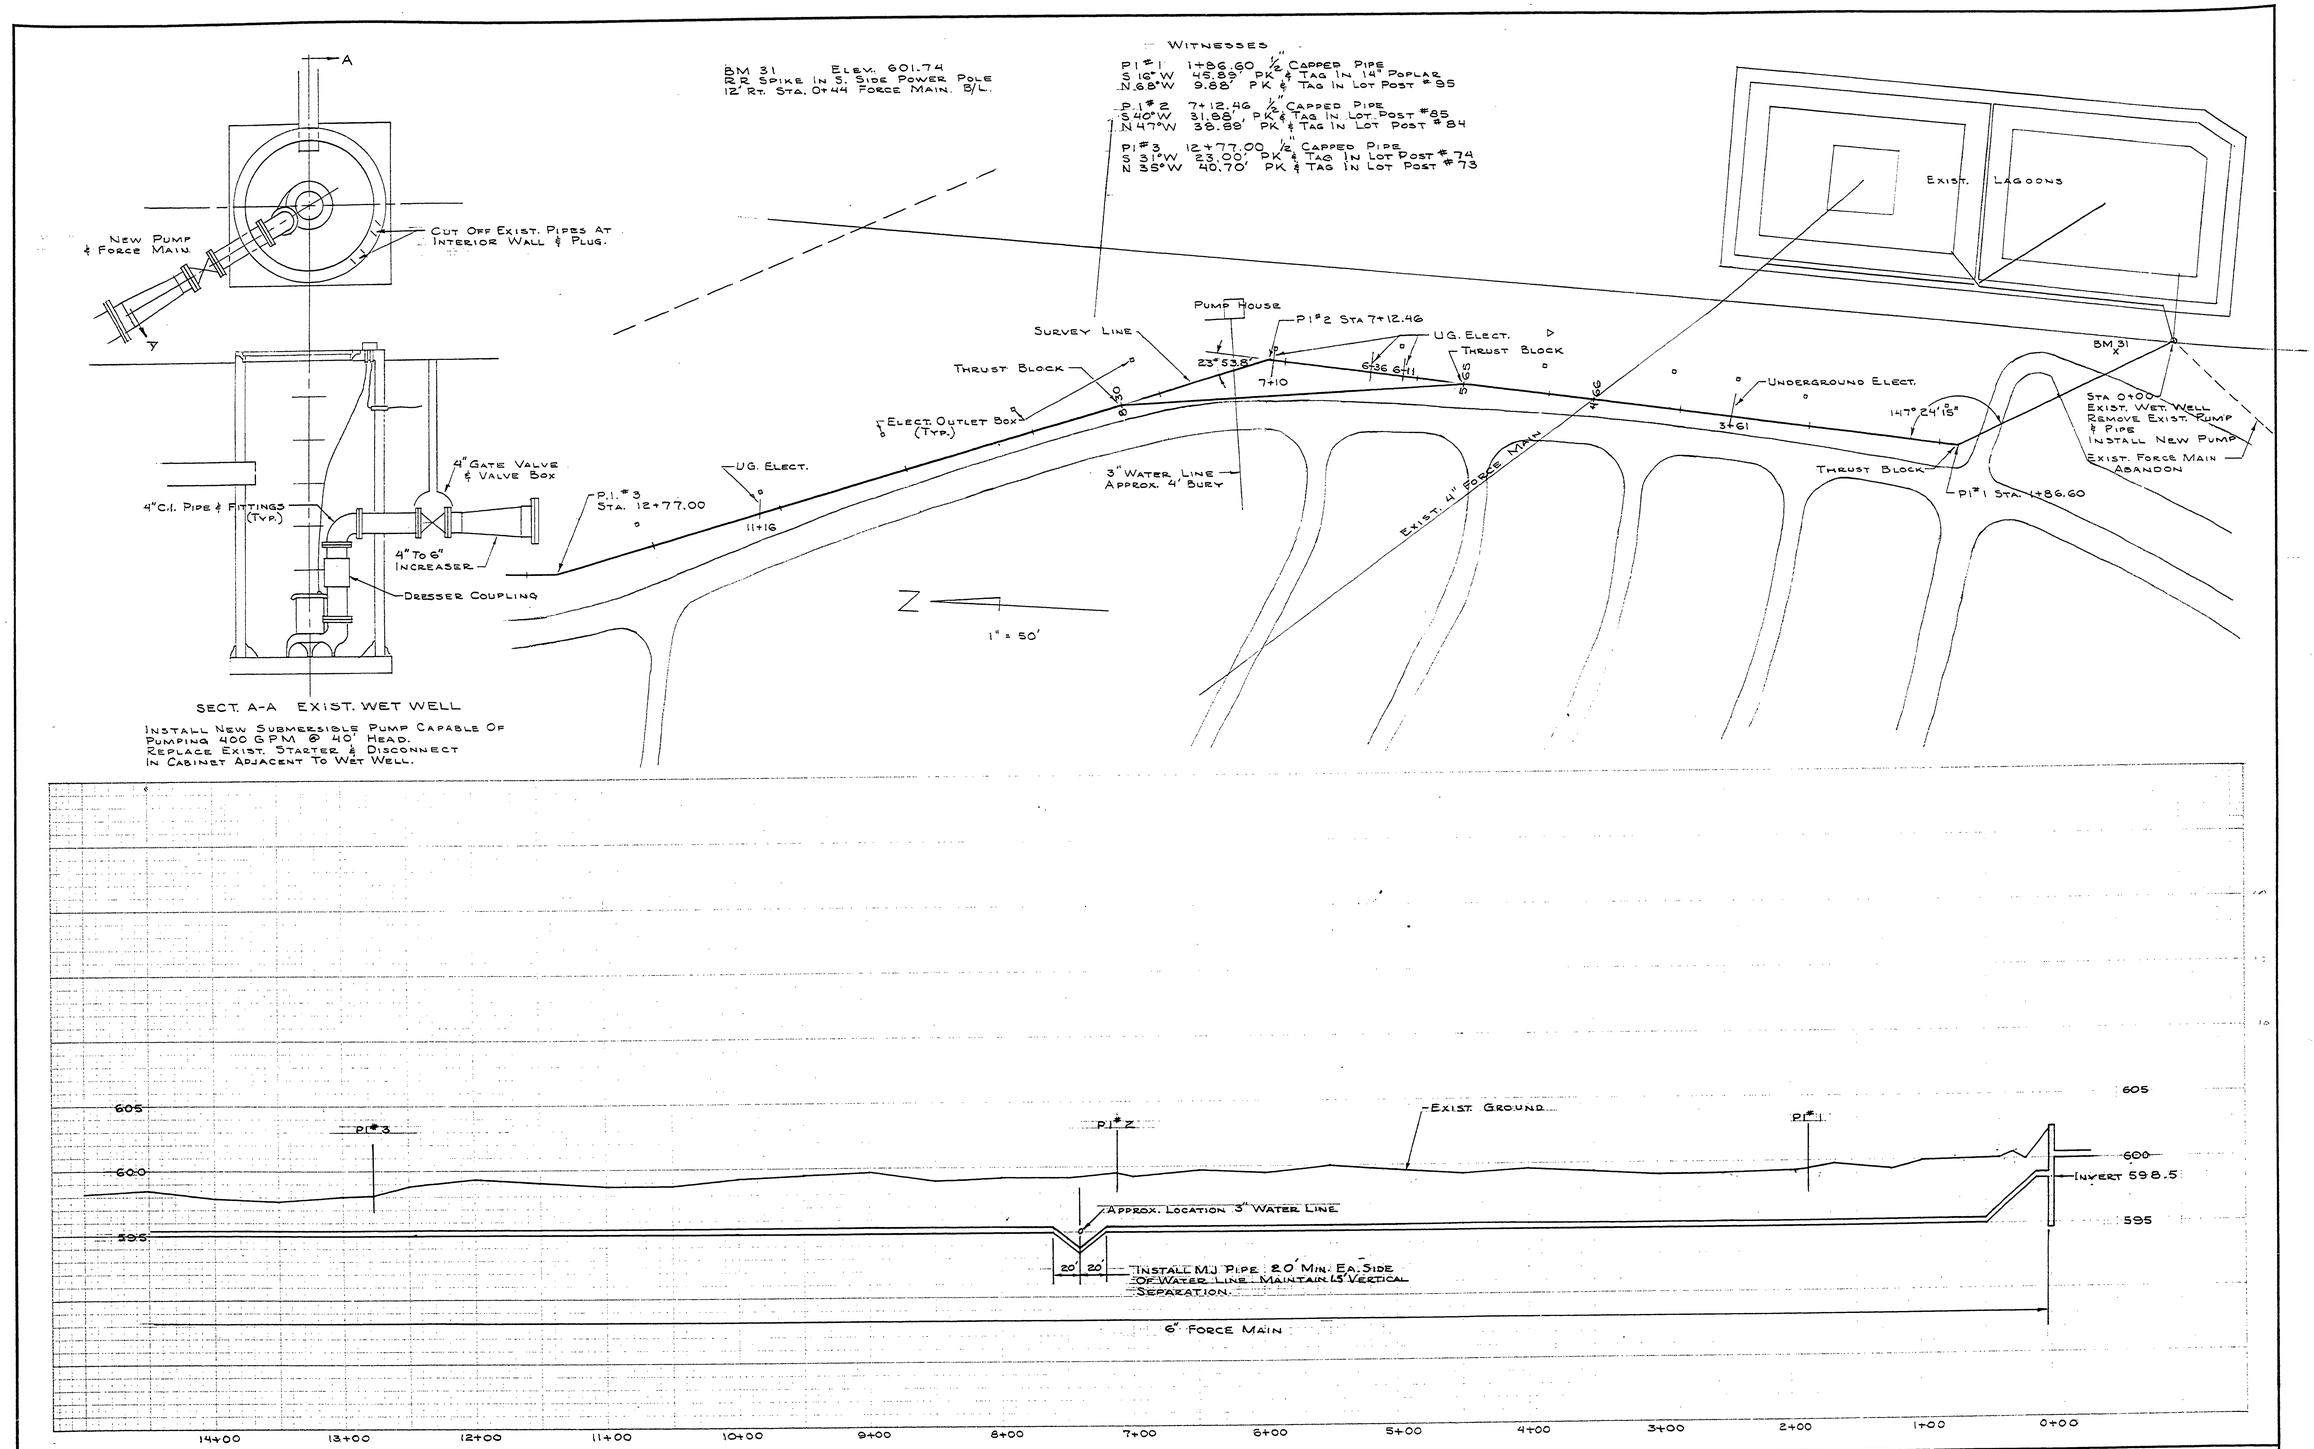


| | | | | | | | | | | | | | |
|---|---|---|---|---|---|---|---|---|---|---|---|---|---|
| SURVEYED BY | | DRAWN BY J. YPMA | AUG. '77 | NO. | DATE | BY | REVISIONS | NO. | DATE | BY | REVISIONS | MICHIGAN DEPARTMENT OF NATURAL RESOURCES | FORCE MAIN & WET WELL REVISIONS |
| DESIGNED BY R. H. MERRILL | AUG. '77 | CHECKED BY | | 1. | 10-5-77 | J.Y. | ALIGNMENT CHG. 3+65 TO 8+30 | 3. | | | | | |
| | DATE | | DATE | 2. | | | | 4. | | | | | |

SHEET NO. ____ OF ____
FOR PROJECT NO. 24-1862

ALOHA STATE PARK
SHEET 2 OF 4 PLAN NO. E-118