K&E 10 9155 4-78 20279

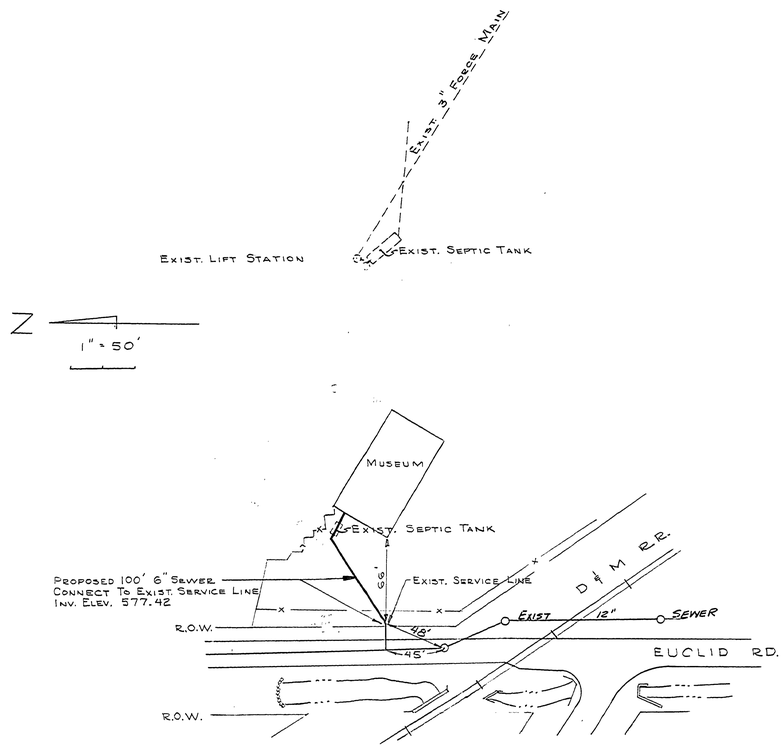

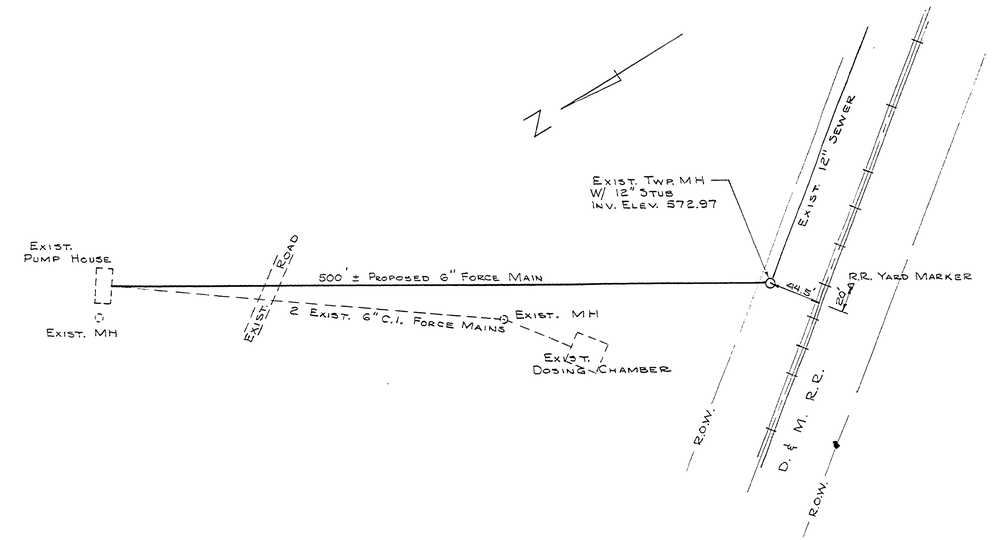

NOTES:
CALL "MISS DIG" (800-482-7171) 48 HRS. BEFORE EXCAVATING
CONTACT BANGOR TWP. D.P.W. 12 HRS BEFORE CONNECTING TO EXIST TWP. SEWERS.

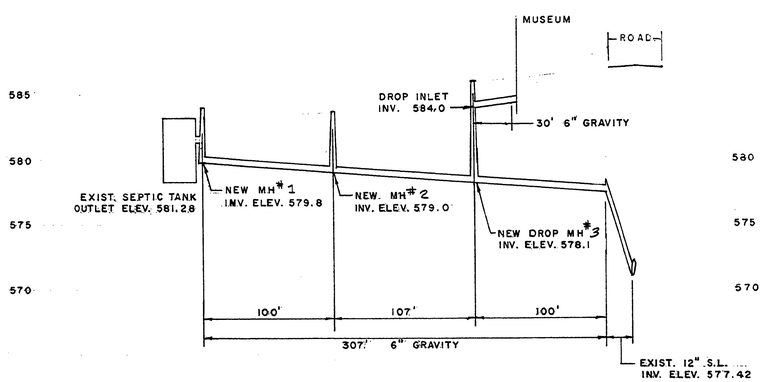

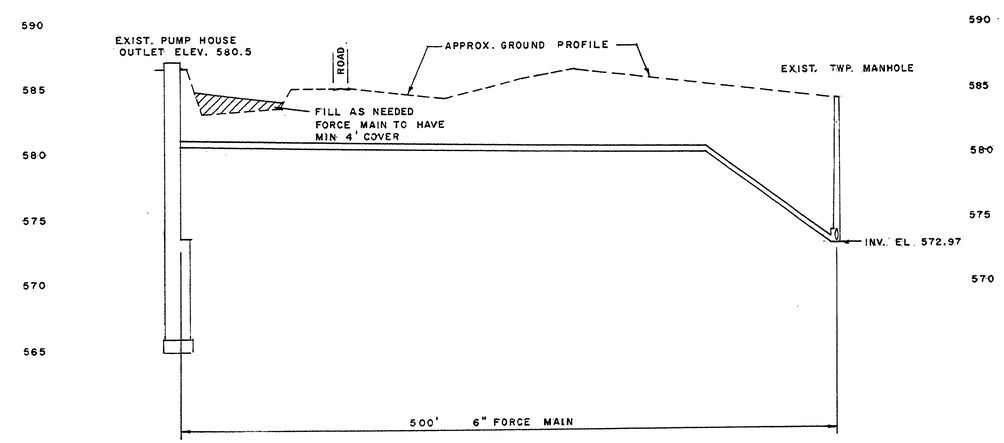

SURVEYED BY		DRAWN BY J. YPMA	4-84	NO.	DATE	BY	REVISIONS	NO.	DATE	BY	REVISIONS
DESIGNED BY R. H. MERRILL	4-84	CHECKED BY		1.	1-87	Cox	PLAN REVISED AS BUILT	3.			
	DATE		DATE	2.				4.			

MICHIGAN
DEPARTMENT OF NATURAL RESOURCES

CONNECTIONS TO MUNICIPAL SEWER SYSTEM
SHEET TITLE

BAY CITY STATE PARK
AREA OR PARK

TOWNSHIP SEWER CONNECTION
PROJECT

PROJECT NO. 24-2491
SHEET 3 OF 4
PLAN NO. E-120