R-1683 IMAGE MEDIA 21-32-01 500 2-79 66874a

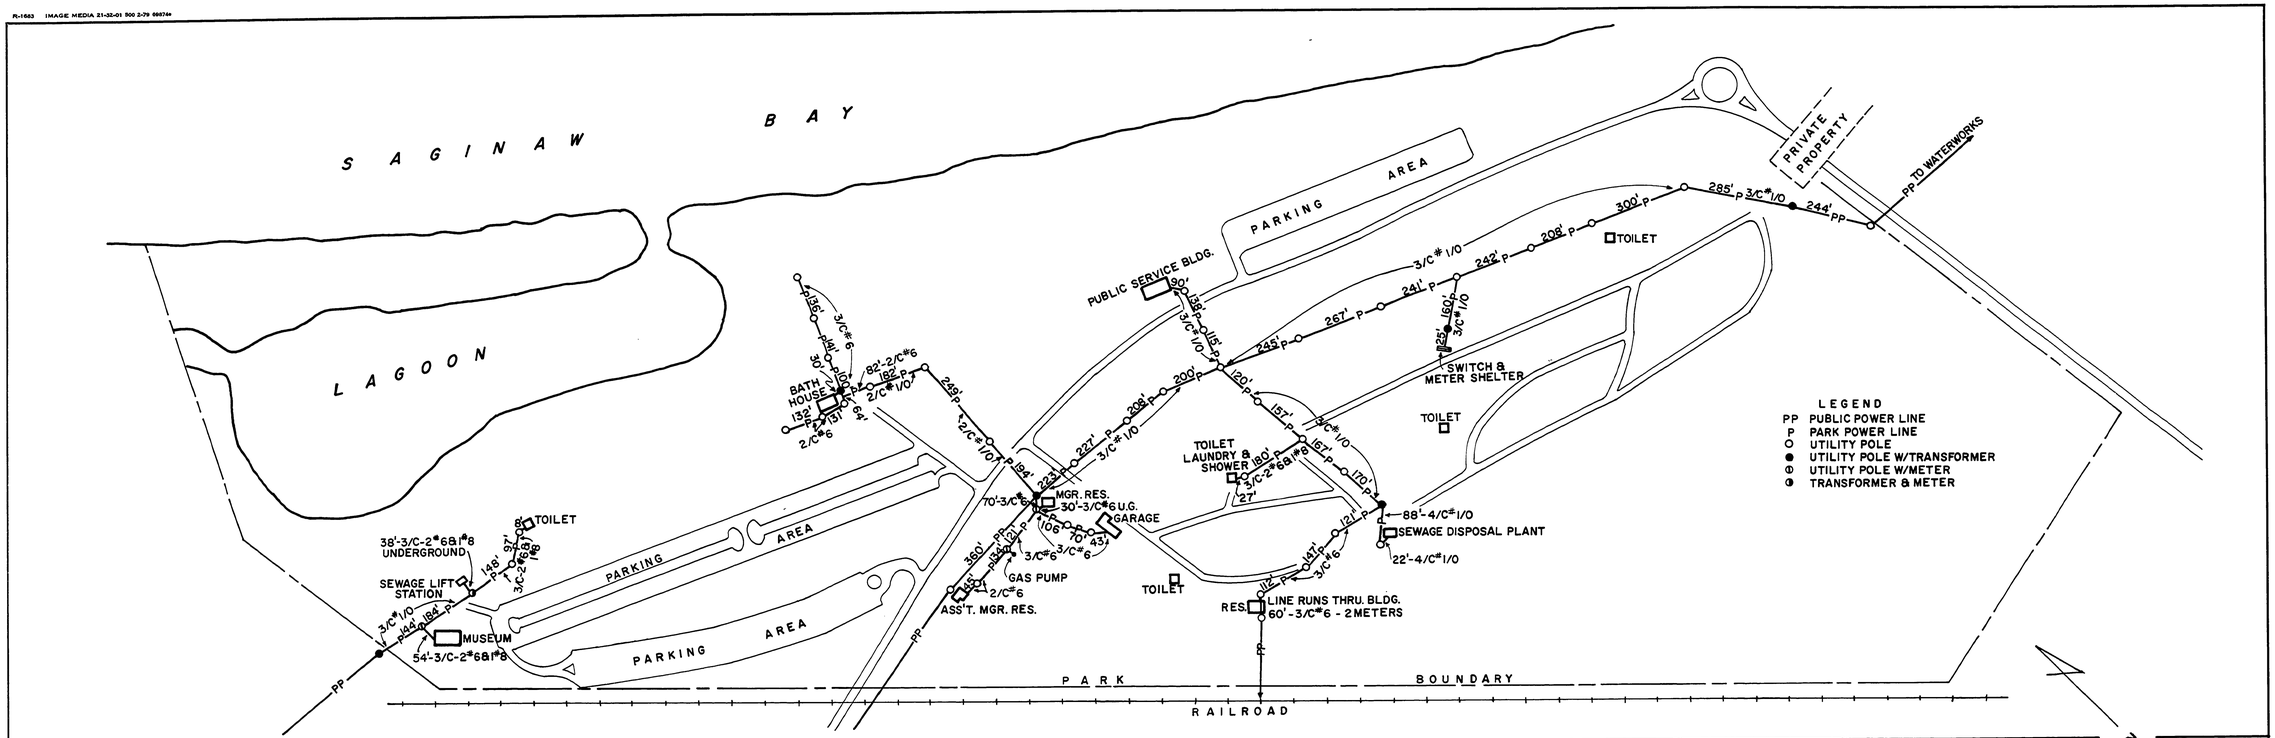

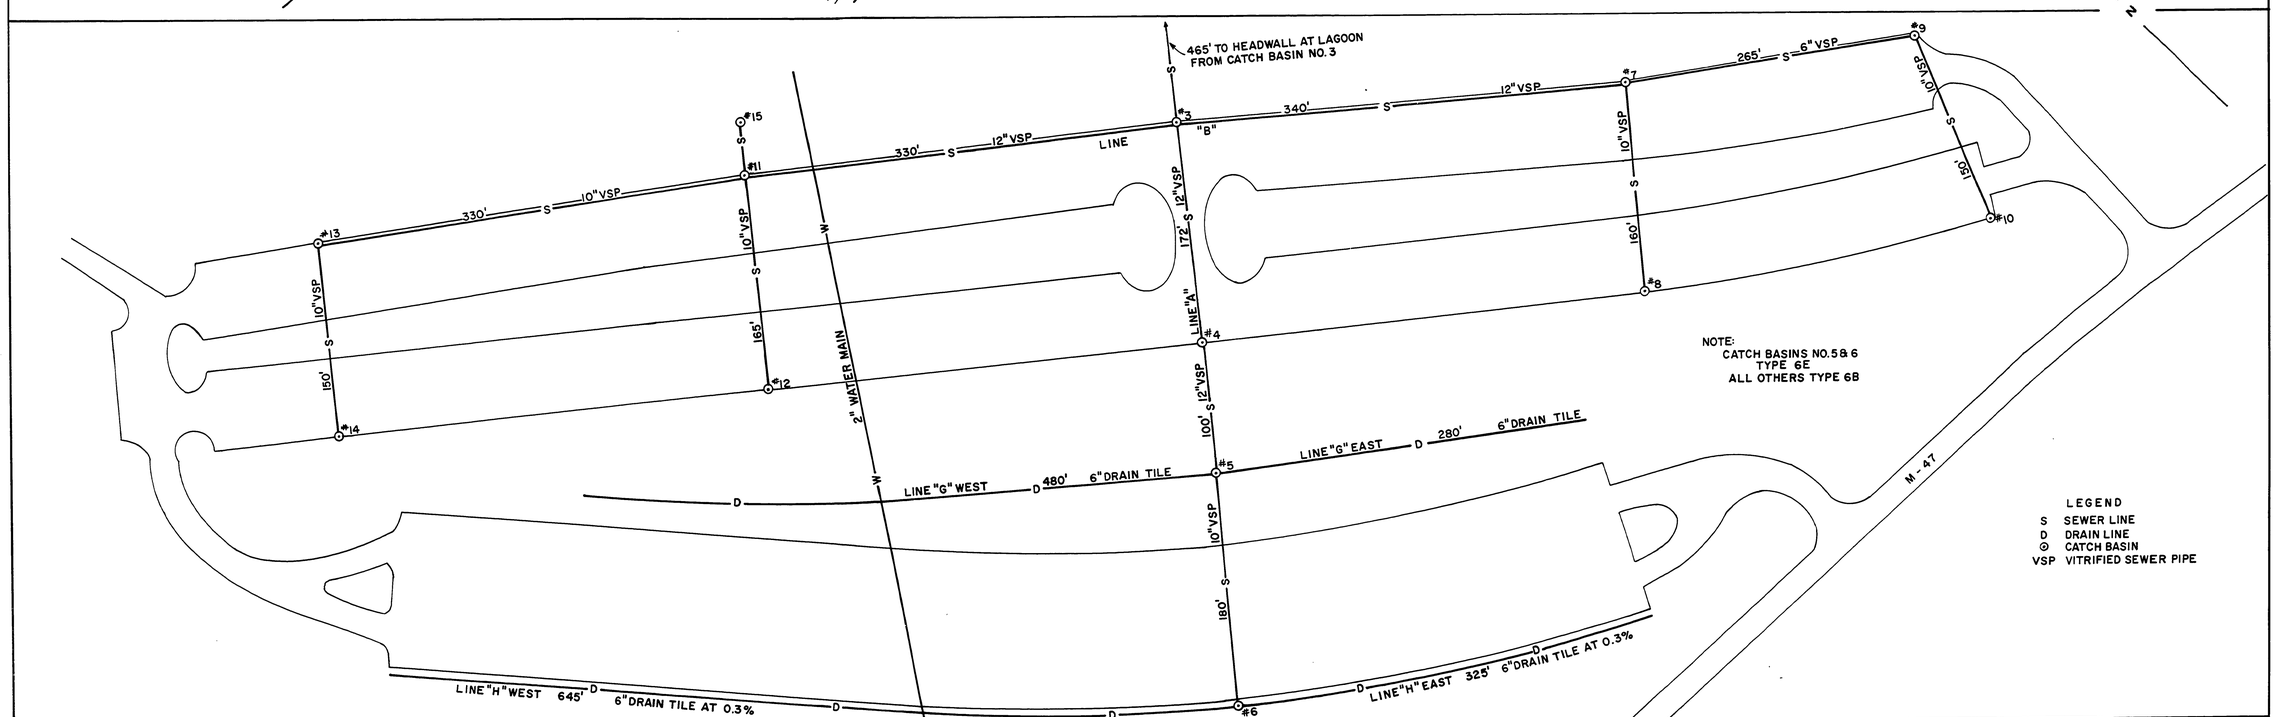

SURVEYED BY		DRAWN BY		NO.	DATE	BY	REVISIONS	NO.	DATE	BY	REVISIONS	MICHIGAN DEPARTMENT OF NATURAL RESOURCES	ELECTRICAL & PARKING AREA STORM SEWERS (SHEET TITLE)
DESIGNED BY		CHECKED BY		1.	3/81	D.B.	REDRAWN ON MYLAR	3.					
	DATE		DATE	2.				4.					

AREA OR PARK: BAY CITY STATE PARK
PROJECT
PROJECT NO.
SHEET 2 OF 2
PLAN NO. U-1