

SURVEY & REMONUMENTATION

APR 07 1998

Allegan County Remonumentation
LAND CORNER RECORDATION CERTIFICATE
Filing Requirement of Act 74, Mich. P.A. 1970

SECTION

For corners in

Allegan (County)	Located in:	Corner Code #
1. Public Land Survey	T 4N R 12W	L-1 (N $\frac{1}{2}$, 1)
	T R	Dorr Twp.
	T R	
	T R	
2. Property Controlling in Section	S T R	
	S T R	
3. Miscellaneous Property in Sec.	S T R	
	S T R	

98 JAN 21 PM 1:21
REGISTER OF DEEDS
ALLEGAN COUNTY, MICH.
John C. Bueche


FILED

Register of Deeds Stamp & File Number

4. Lot No. , Recorded Plat
5. Private Claims

I, John C. Bueche, in a field survey on April 28, 19 97, do hereby certify that under requirements of P.A. 74, Michigan P.A. of 1970, the corner points mentioned in lines 1 and 2 above were in conformance with regulations and rules therefore as required in the current manual of survey instructions of the United States Department of the Interior, Bureau of Land Management or by a decree of a Court of Law and/or that the corner points mentioned in lines 3, 4 and 5 above were in conformance with the rules of the Michigan Board of Land Surveyors or by a Decree of a Court of Law; established, re-established, monumented, re-monumented, recovered, found as expressed below:

NOTE: Not more than 4 corners, all in the same town and range, may be recorded on this certificate.

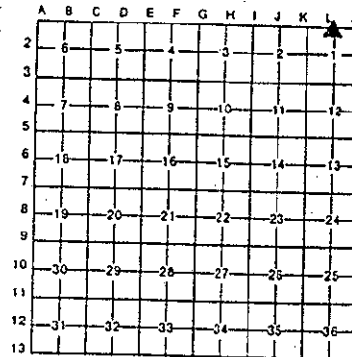

A. Description of original monument and accessories and/or subsequent restoration:

L-1 GLO	Wit. map, 1968	Survey Oct., 1972 Iron	CP 1975
Not set	Leaded stone set iron from wit.	Ratekin & Assoc.	Found 1/2" solid iron
	12" Apple clump S 30° E 23.21'	Same as left	
	14" Basswood clump N 27° E 27.97'	Hickory clump S 40° E 48.72'	LCRC L2, P81 Allegan Co.
	16" Elm clump S 60° E 64.12'		1" iron Dec., 1972
			Same as survey 1972

B. Description of corner evidence found and/or method applied in restoring or reestablishing corner: OVER

L-1 Found Kent Co. Mon. as per LCRC 1814 & 8663
Cor. is being held as a common cor.

As per wit. LCRC 8663


This position not established by original government surveyors. This monument is accepted as the best available evidence of the position of the corner.

Peer group approved May 13, 1997.

APPROVED REMONUMENTATION CORNER
P.A. 345 OF 1990
ALLEGAN COUNTY
DATE APPROVED 5-13-97
COUNTY REP. K.V.O.

C. Description of monument for corner and accessories established to perpetuate locating the position of the corner:

L-1 Kent Co. Mon.
Nail & Allegan Co. Remon. Tag in N side 12" Basswood S 70° E 33.87'
Nail & Allegan Co. Remon. Tag in W side 22" Basswood N 28° E 28.05'
Nail & Allegan Co. Remon. Tag in W side 10" W. Cherry S 30° E 35.63'
Nail & Allegan Co. Remon. Tag in E side 8" Elm S 45° W 21.62'
Nail & Kent Co. Remon. Tag in E side 14" Basswood N 3° E 19.27'
Nail & Kent Co. Remon. Tag in NE side 10" Basswood N 53° W 11.26'
On fence E-W, no occupation N or S

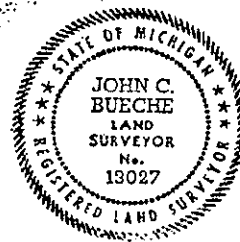

Signed by John C. Bueche P.S. 13027
Surveyor's Michigan License No. 13027

Date Sept 12, 1997

USE 0006 PAGE 079

Sheet 1 of 2

FORM APPROVED BY MICHIGAN STATE BOARD OF LAND SURVEYORS, JAN. 28, 1971
REVISED MAY 14, 1975
REVISED JAN., 1983

Card 1968
Leaded stone
Set iron from wit.
Same wit. as front

LCRC 1814 (Kent Co.) June, 1981
Statement "It appears that this stone had also been used a N¼ 1, 4-12 (from MDSHT plans 1955±)"

LCRC 8663 (Kent Co.) Sept., 1995
Statement "This point is common with N¼ 1, 4-12)

Kent Co. Mon.
Nail & Kent Co. Remon. Tag in W side 18" Triple Basswood N 28° E 28.05'
Nail & Kent Co. Remon. Tag in E side 12" Basswood N 3° E 19.27'
Nail & Kent Co. Remon. Tag in NE side 9" Basswood N 53° W 11.29'
Nail & kent Co. Remon. Tag in N side 10" Basswood S 71° E 33.87'