# LAND CORNER RECORDATION CERTIFICATE
## Filing Requirement of Act 74, Mich. P.A. 1970 as Amended

For corners in

Baraga
(County)

| | Located In: | Corner Code # |
|---|---|---|
| 1. Public Land Survey | T 49N R 33W | I11 |
| | T___ R___ | |
| | T___ R___ | |
| | S___ T___ R___ | |
| 2. Property Controlling | S___ T___ R___ | |
| in Section | S___ T___ R___ | |
| 3. Miscellaneous | S___ T___ R___ | |
| Property in Sec. | S___ T___ R___ | |

Register of Deeds Stamp & File Number

4. Lot No. _____ , Recorded Plat_____

5. Private Claims

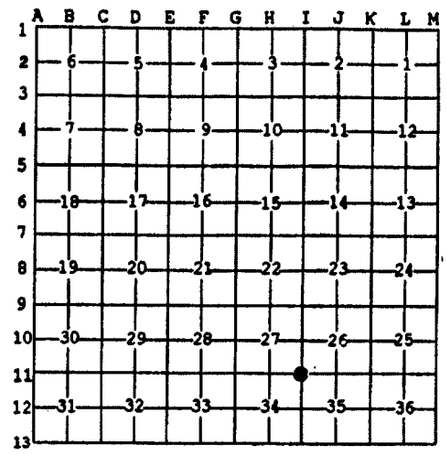


Oct 26 2005

I, Stephan J. Szyszkoski, in a field survey on _____, 20 ____ do hereby state that under requirements of P.A. 74, Michigan P.A. of 1970, the corner points mentioned in lines 1 and 2 above were in conformance with regulations and rules therefore as required in the current manual of survey instructions of the United States Department of the Interior, Bureau of Land Management or by a decree of a Court of Law and /or that the corner points mentioned in lines 3, 4 and 5 above were in conformance with the rules of the Michigan Board of Land Surveyors or by a Decree of a Court of Law; established, re-established, monumented, recovered, found as expressed below:

**NOTE: Not more than 2 corners, all in the same town and range, may be recorded on this certificate.**

A. Description of original monument and accessories and/or subsequent restoration:

(I11) Corner common to Sections 26-27-34-35. 1852 - Established by Zelotes Searles, Deputy Surveyor: "N3'W Corrected between Sections 34-35 ...79.96 Set post corner of Sections 26-27-34-35. Fir 8 S46W 53 links, Fir 14 N10E 10 links". Sept. 8, 1947 - Notes of N.T.Thompson RLS found at Northern Hardwoods office in Bovine, MI state: "Set this cor. Cedar post. New B.T. Y.Bir 18 N86W 26.3, Bal 6 N67E 13.2. "

B. Description of corner evidence found and/or method applied in restoring or reestablishing corner:

(I11) Found a 1"ID iron pipe set firm in a mound of rock and at record bearing and distance from the 1947 Y.Birch NBT N86W 26.3'. Also found a Ford Motor location poster on the ground adjacent with signatures dating to 1956. The Y.Birch NBT is now a dead stub with upper and lower blazes and scribing visible. Accepted the pipe as the best available evidence of the position of the original corner.

C. Description of monument for corner and accessories established to perpetuate locating the position of the corner:

(I11) Found 1"ID iron pipe. Set measuring nails in:

| | | |
|---|---|---|
| 9" Spruce S24E 24.0' | mrkd | "S35 NBT" |
| 16" Cedar S25W 32.3' | | "S34 NBT" |
| 7" Spruce N70W 22.1' | | "S27 NBT" |
| 7" Y.Birch N29W 30.0' | | "S27 NBT" |

Set sq'd spruce post adjacent. Bearings are magnetic. Distances are to nail with tag.

STATE OF MICHIGAN
STEPHAN J. SZYSZKOSKI
LAND SURVEYOR
No. 33986
LICENSED LAND SURVEYOR

Signed by Stephan J. Szyszkoski Date 2/29/06

Surveyor's Michigan License No. 33986

For the Michigan Department of Natural Resources, Office of Land and Facilities

FORM APPROVED BY MICHIGAN STATE BOARD OF PROFESSIONAL SURVEYORS, JAN. 28, 1971
Revised May 14, 1975
Revised Jan., 1983
Rervised Oct., 1995