

# BAY COUNTY REMONUMENTATION 1999

## LAND CORNER RECORDATION CERTIFICATE Filing Requirement of Act 74, Mich. P.A. 1970

RECORDED  
RECORDED

For corners in

SECTION

Bay

(County)

Located In:  
Bangor Twp.

Corner Code #

1. Public Land Survey

T \_\_\_\_\_ R \_\_\_\_\_  
T \_\_\_\_\_ R \_\_\_\_\_  
T \_\_\_\_\_ R \_\_\_\_\_  
T \_\_\_\_\_ R \_\_\_\_\_

2. Property Controlling  
in Section

S 14&15 T 14 N. R 5 E. #2

3. Miscellaneous  
Property in Sec.

S \_\_\_\_\_ T \_\_\_\_\_ R \_\_\_\_\_  
S \_\_\_\_\_ T \_\_\_\_\_ R \_\_\_\_\_

4. Lot No. \_\_\_\_\_, Recorded Plat \_\_\_\_\_

5. Private Claims \_\_\_\_\_

I, Roger P. Mahoney, in a field survey on 9-16, 1999 do hereby state that under requirements of P.A. 74, Michigan P.A. of 1970, the corner points mentioned in lines 1 and 2 above were in conformance with regulations and rules therefore as required in the current manual of survey instructions of the United States Department of the Interior, Bureau of Land Management or by a decree of a Court of Law and for that the corner points mentioned in lines 3, 4 and 5 above were in conformance with the rules of the Michigan Board of Land Surveyors or by a Decree of a Court of Law; established, re-established, monumented, recovered, found as expressed below:

NOTE: Not more than 2 corners, all in the same town and range, may be recorded on this certificate.

A. Description of original monument and accessories and/or subsequent restoration:

Property Controlling Corner #2.

Meander corner on East line Section 15, North of Saginaw River, South of I-5.  
Post set by Wampler 1821 on North Bank of Saginaw River.  
No further evidence of restoration.

B. Description of corner evidence found and/or method applied in restoring or reestablishing corner:

Property Controlling Corner #2.

Meander corner on East line Section 15, North of Saginaw River, South of I-5.

No corner found. No apparent property line North & South.

Set temporary point on a line from I-5 through the 1/8 corner on the East line of Section 15 at the GLO call of (32.0 ch) 2112.0' S. of I-5. Location of I-5 and 1/8 corner agrees with surveys performed by Burgin in 1990 and Spicer in 1974. Temporary point falls in bit. roadway E. & W.

Accepted the temporary point as the best available evidence of the position of the original corner.

C. Description of monument for corner and accessories established to perpetuate locating the position of the corner:

Property Controlling Corner #2.

Meander corner on East line Section 15, North of Saginaw River, South of I-5.

Replaced temporary point with 5/8" rebar and Bay County remon cap stamped 41105 M.C. and mon box in bit. roadway.

S.80°W. - 88.57' - N&T N. face utility pole.

S.60°E. - 74.39' - N&T S. face utility pole.

N.27°W. - 32.70' - 3" pipeline support post.

S.41°W. - 30.70' - 3" pipeline support post.

West - 18.10' - 3" above ground pipeline (3").

South - 4.2' - S. edge bit. service road.

Signed by

Roger P. Mahoney

Date


12-22-99

APPROVED LAND CORNER  
P.A. 345 OF 1990 - Bay County

Date 10-21-99

MH  
Michael MacDonald P.S.  
County Representative

Surveyor's Michigan License No. 41105

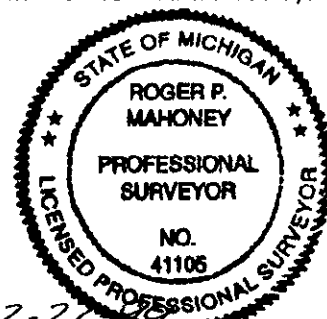

004

285