

SURVEY &
REMONUMENTATION

MAY 03 1995

CHEBOYGAN COUNTY REMONUMENTATION CORNER

LAND CORNER RECORDATION CERTIFICATE

Filing Requirement of Act 74, Mich. P.A. 1970

COMMISSION

RECEIVED
FOR RECORD
94 NOV 22 AM 10:42

Joanna Long
CLERK/REGISTER
CHEBOYGAN COUNTY, MICHIGAN

CHEBOYGAN
(County)

Located In:

Corner Code #

1. Public Land Survey T 37N R 1W D-1
T R
T R
T R
T R
2. Property Controlling S T R
in Section S T R
3. Miscellaneous S T R
Property in Sec. S T R
4. Lot No. , Recorded Plat
5. Private Claims

Register of Deeds Stamp & File Number

I, Ronald Bischer, in a field survey on September 16, 19 94,
do hereby certify that under requirements of P.A. 74, Michigan P.A. of 1970, the corner points mentioned
in lines 1 and 2 above were in conformance with regulations and rules therefore as required in the
current manual of survey instructions of the United States Department of the Interior, Bureau of Land
Management or by a decree of a Court of Law and/or that the corner points mentioned in lines 3, 4 and 5
above were in conformance with the rules of the Michigan Board of Land Surveyors or by a Decree of a
Court of Law; established, re-established, monumented, re-monumented, recovered, found as
expressed below:

NOTE: Not more than 4 corners, all in the same town and range, may be recorded
on this certificate.

A. Description of original monument and accessories and/or subsequent restoration:

June 1840 GLO Survey - John Mullett
Set Wood Post
Cedar 16" N39°E 11 links
Cedar 10" N38°W 16 links
02-03-73 - Orlando Doyle
Found 1" Bar
N75°E 69.02' 24" Elm
S30°E 52.14' 16" Elm
S45°W 54.23' Power pole

B. Description of corner evidence found and/or method applied in restoring or reestablishing corner:

3/4" Pipe
S58°W 54.30' Power pole


Replaced 3/4" Pipe with Cheboygan County Remonumentation Monument

C. Description of monument for corner and accessories established to perpetuate locating the position of the corner:

Cheboygan County Remonumentation Monument
S58°W 54.30' Power pole
N52°W 58.11' Anchor pole
N67°E 45.10' Stop sign
S42°E 44.95' Power pole

LIBER 010 PAGE 86

Maurice A. Ross

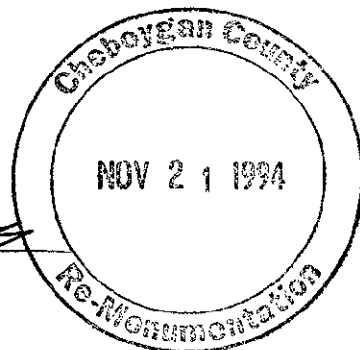

Signed by Ronald R. Bischer

Date Oct 25, 1994

Surveyor's Michigan License No. 22428