SURVEY & REMONUMENTATION

DEC 15 1998

SECTION

Register's Office } ss.
Gogebic County }

Received for record the 25TH day of NOVEMBER A. D. 1998 at 10:00 o'clock A m., and recorded in Liber 7 of CORNERS page 85

Ramona Collins, Deputy
Register of Deeds

Register of Deeds Stamp & File Number

LAND CORNER RECORDATION CERTIFICATE

Filing Requirement of Act 74, Mich. P.A. 1970

For corners in Gogebic (County)

		Located In:	Corner Code #
1. Public Land Survey		T 46N R 45W	A-4
		T ___ R ___	
		T ___ R ___	
		T 46N R 46W	M-4
2. Property Controlling	S ___	T ___ R ___	
in Section	S ___	T ___ R ___	
3. Miscellaneous	S ___	T ___ R ___	
Property in Sec.	S ___	T ___ R ___	

4. Lot No. _____, Recorded Plat _____
5. Private Claims _____

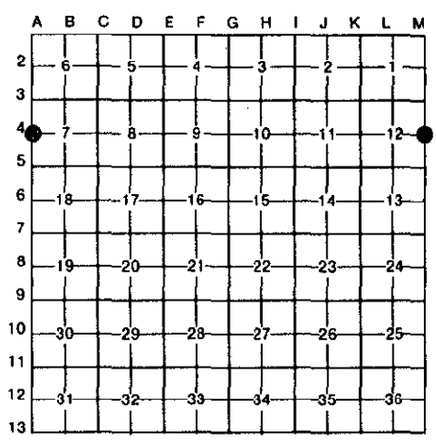

¼ Corner 7 & 12; T.46 N., R.45-46 W.

I, Richard L. Drahn in a field survey on October 28, 19 98, do hereby certify that under requirements of P.A. 74, Michigan P.A. of 1970, the corner points mentioned in lines 1 and 2 above were in conformance with regulations and rules therefore as required in the current manual of survey instructions of the United States Department of the Interior, Bureau of Land Management or by a decree of a Court of Law and/or that the corner points mentioned in lines 3, 4 and 5 above were in conformance with the rules of the Michigan Board of Land Surveyors or by a Decree of a Court of Law; established, re-established, monumented, re-monumented, recovered, found as expressed below:

NOTE: Not more than 4 corners, all in the same town and range, may be recorded on this certificate.

A. Description of original monument and accessories and/or subsequent restoration:

Corner established by John Burt on 9/1/1847. Original B.T.s --- Cedar 10" S.40 E. 13 links (8.58') --- Spruce 6" N.24 W. 14 links (9.24') ---

R. Burke & J. Peryam, timber cruisers, recovered this location in Feb. 1955. They reported a USFS Location Poster and recovered a leaning 12" Cedar signed by Wade Weston, on which he wrote "B T". 1955 notes state that work on B.T. was "very old".

B. Description of corner evidence found and/or method applied in restoring or reestablishing corner:

Restored corner position at record bearing and distance from the remains of the two original B.T.s. The first, a very badly decayed 14-16" Cedar with portions of the blaze overgrowth and face blaze still evident. The second on is now an extremely badly decayed 10-12" Spruce stump. The Cedar 8" line tree 0.20 chains (13.20') south, is now a large wind-thrown depression.

Recovered a 1935 era USFS Location Poster on a 8" Balsam stub bearing N.49 E., 8.4' from the original corner location.

Corner research on file with Gogebic County records.

PEER GROUP APPROVED
Richard L. Drahn 11/24/98
COUNTY REPRESENTATIVE

C. Description of monument for corner and accessories established to perpetuate locating the position of the corner:

At the corner I set a 3/4" X 8' aluminum rod with a 3¼" aluminum cap, stamped to indicate the corner position and the following new B.T.s:

6"	Cedar	S.55 E.	14.58'
5"	Cedar	N.52 E.	9.93'
9"	Cedar	S.57 W.	21.20'
6'	Steel sign rail	N.17 E.	2.94'

STATE OF MICHIGAN
RICHARD L. DRAHN
LAND SURVEYOR
No. 21564
REGISTERED LAND SURVEYOR

Signed by Richard L. Drahn Date November 9, 1998

Surveyor's Michigan License No. 21564

USFS G-1

FORM APPROVED BY MICHIGAN STATE BOARD OF LAND SURVEYORS, JAN. 28, 1971
REVISED MAY 14, 1975
REVISED JAN., 1983