SURVEY &
REMONUMENTATION

APR 27 1995

COMMISSION

STATE OF MICHIGAN
COUNTY OF KALAMAZOO
RECEIVED FOR RECORD

'94 DEC 15 PM 1 37

CLERK-REGISTER

LIBER 1 PG 1229

Register of Deeds Stamp & File Number

LAND CORNER RECORDATION CERTIFICATE

Filing Requirement of Act 74, Mich. P.A. 1970

For corners in ROSS TWP.

KALAMAZOO (County)

	Located In:	Corner Code #
1. Public Land Survey	T 1 S R 9 W	L-5
	T ___ R ___	
	T ___ R ___	
	T ___ R ___	
2. Property Controlling	S ___ T ___ R ___	
in Section	S ___ T ___ R ___	
3. Miscellaneous	S ___ T ___ R ___	
Property in Sec.	S ___ T ___ R ___	

4. Lot No. _____, Recorded Plat _____
5. Private Claims _____

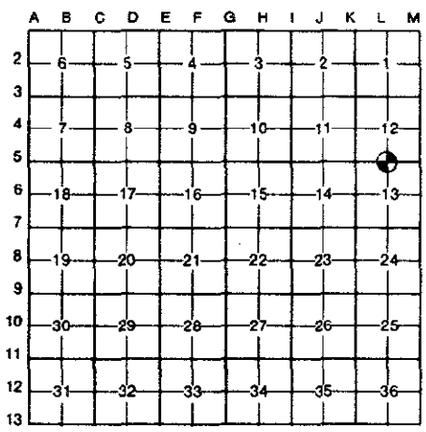

I, Allen H. McMachen a field survey on May 16, 19 94, do hereby certify that under requirements of P.A. 74, Michigan P.A. of 1970, the corner points mentioned in lines 1 and 2 above were in conformance with regulations and rules therefore as required in the current manual of survey instructions of the United States Department of the Interior, Bureau of Land Management or by a decree of a Court of Law and/or that the corner points mentioned in lines 3, 4 and 5 above were in conformance with the rules of the Michigan Board of Land Surveyors or by a Decree of a Court of Law; established, re-established, monumented, re-monumented, recovered, found as expressed below:

NOTE: Not more than 4 corners, all in the same town and range, may be recorded on this certificate.

A. Description of original monument and accessories and/or subsequent restoration:

1880's - F. Hodgeman C.S. Placed Clay Tile Post during official Township Remonumentation.

B. Description of corner evidence found and/or method applied in restoring or reestablishing corner:

Found Clay Tile 4' below road surface.

RATIFIED
BY KALAMAZOO COUNTY
REMONUMENTATION
PEER GROUP
11-17-94

STATE OF MICHIGAN
ALLEN H. McMACHEN
LAND SURVEYOR
No. 16935
REGISTERED LAND SURVEYOR

C. Description of monument for corner and accessories established to perpetuate locating the position of the corner:

Found Clay Tile is accepted as a careful & faithful perpetuation of the original corner. Place Harrison Monument over existing Clay Tile and Monument box.

Accessories:

Nail & Tab in 28" Maple N.67° E. 57.15'
Nail & Tab in 30" Oak SOUTH 32.52'
Nail & Tab in 36" Maple S. 60° W. 46.15'
Nail & Tab in 8" Triple Maple N. 40° W. 40.68'

Signed by Allen H. McMachen Date 11/30/94

Surveyor's Michigan License No. 16935

FORM APPROVED BY MICHIGAN STATE BOARD OF LAND SURVEYORS, JAN. 28, 1971
REVISED MAY 14, 1975
REVISED JAN., 1983