SURVEY & REC... ...TATION

MAR 1 7 2000

SECTION

LAND CORNER RECORDATION CERTIFICATE

Filing Requirement of Act 74, Mich. P.A. 1970

For corners in LIVINGSTON (County)

	Located In:	Corner Code ##
1. Public Land Survey	T 4N R 3E	J9
	T ___ R ___	
	T ___ R ___	
	T ___ R ___	
2. Property Controlling	S ___ T ___ R ___	
in Section	S ___ T ___ R ___	
3. Miscellaneous	S ___ T ___ R ___	
Property in Sec.	S ___ T ___ R ___	

FILED

1999 JUN -4 : P 12: 56

NANCY HAVILAND
REGISTER OF DEEDS
LIVINGSTON COUNTY, MI.
48843

L.S.C. #1033m

Register of Deeds Stamp & File Number

4. Lot No. _____, Recorded Plat _____
5. Private Claims _____

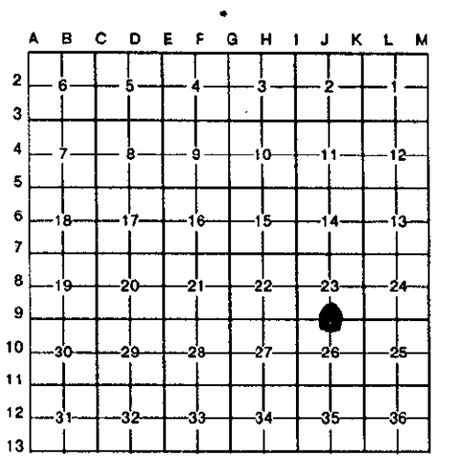

I, CHARLES E GARLOCK, in a field survey on MARCH 17, 19 99, do hereby certify that under requirements of P.A. 74, Michigan P.A. of 1970, the corner points mentioned in lines 1 and 2 above were in conformance with regulations and rules therefore as required in the current manual of survey instructions of the United States Department of the Interior, Bureau of Land Management or by a decree of a Court of Law and/or that the corner points mentioned in lines 3, 4 and 5 above were in conformance with the rules of the Michigan Board of Land Surveyors or by a Decree of a Court of Law; established, re-established, monumented, re-monumented, recovered, found as expressed below:

NOTE: Not more than 4 corners, all in the same town and range, may be recorded on this certificate.

A. Description of original monument and accessories and/or subsequent restoration:
GLO SURVEY DATED: APRIL 15, 1825 BY S SIBLEY AND NONE OF THE GLO WITNESSES REMAIN.
GLO WITNESSES: BEECH 20-S55E-19.8'
LYNN 6-WEST-3.3'

B. Description of corner evidence found and/or method applied in restoring or reestablishing corner:
FOUND 1/2" I. ROD 2-3' SOUTH OF GRAVEL ROAD C/L AND IN LINE WITH FENCES NORTH & SOUTH

P.A. 345 1990, APPROVED BY LIVINGSTON COUNTY
PEER GROUP ON 2-3-1999 CO REP VEO

C. Description of monument for corner and accessories established to perpetuate locating the position of the corner:
J9: S 1/4 COR. SEC. 23 T4N-R3E, CONWAY TWP. LIV. CO. MI., RESET WITH 1 1/4" X 36" BREAKAWAY IRON PIPE WITH LIVINGSTON CO. BRASS CAP # 14762
S35E-31.58'-SP & TAG N/S 12" FORKED WALNUT
N30E-33.95'-SP & TAG W/S 10" WALNUT
N58E-44.66'-SP & TAG E/S 8" WALNUT
N70E-70.44'-SP & TAG S/S 14" WALNUT
NORTH-3.0'-C/L GRAVEL ROAD

STATE OF MICHIGAN
CHARLES E. GARLOCK
PROFESSIONAL SURVEYOR
No. 14762
LICENSED PROFESSIONAL SURVEYOR

Signed by Charles E Garlock Date MARCH 19, 1999

Surveyor's Michigan License No. 14762

FORM APPROVED BY MICHIGAN STATE BOARD OF LAND SURVEYORS, JAN. 28, 1971
REVISED MAY 14, 1975
REVISED JAN., 1983