SURVEY & REMONUMENTATION

MAR 17 2000

FILED

1999 NOV 22 A 11: 10

NANCY HAVILAND
REGISTER OF DEEDS
LIVINGSTON COUNTY, MI.
48843

LAND CORNER RECORDATION CERTIFICATE

Filing Requirement of Act 74, Mich. P.A. 1970

SECTION 9

For corners in LIVINGSTON (County) Located in: TYRONE Corner Code # E-10

1. Public Land Survey		T 4N	R 6E	E-10
		T	R	
		T	R	
		T	R	
2. Property Controlling	S	T	R	
in Section	S	T	R	
3. Miscellaneous	S	T	R	
Property in Sec.	S	T	R	

LSC# 1131m

Register of Deeds Stamp and File Number

4. Lot No. _____ , Recorded Plat _____

5. Private Claims _____

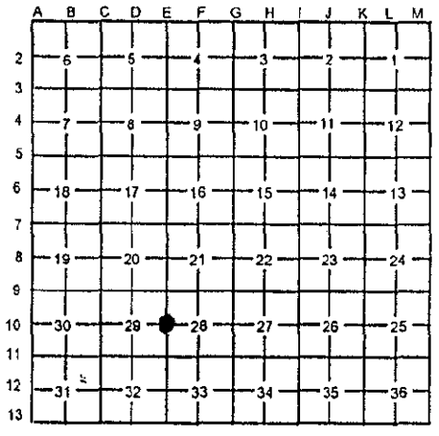

I, Bryan L. Boss, in a field survey on NOV. 8, 1999, do hereby certify that under requirements of P.A. 74, Michigan P.A. of 1970, the corner points mentioned in lines 1 and 2 above were in conformance with regulations and rules therefor as required in the current manual of survey instructions of the United States Department of the Interior, Bureau of Land Management or by a decree of a Court of Law and/or that the corner points mentioned in lines 3,4 and 5 above were in conformance with the rules of the Michigan Board of Land Surveyors or by a Decree of a Court of Law; established, re-established, monumented, re-monumented, recovered, found as expressed below.

NOTE: Not more than 4 corners, all in the same town and range, may be recorded on this certificate.

A. Description of original monument and accessories and/or subsequent restoration:

SET POST
N60°E 6" B. OAK 7 LINKS
S49°W 18" W. OAK 40 LINKS

B. Description of corner evidence found and/or method applied in restoring or reestablishing corner:

FD. R.R SPIKE 0.5 FEET WEST OF CENTERLINE OLD US. 23

C. Description of monument for corner and accessories established to perpetuate locating the position of the corner:

SET 1 1/4" X 30" PIPE CONNECTED BY PLASTIC PIPE TO A 1 1/4" X 6" PIPE WITH A BRASS CAP STAMPED "LIVINGSTON COUNTY REMONUMENTATION CORNER" IN MON. BOX
N32°W 71.00' SET REMON NAIL & TAG NE/S TWIN ELM
N42°E 54.93' SET REMON NAIL & TAG NE/S MULTI-STEM ELM
N89°W 95.44' SET REMON NAIL & TAG 16" CHERRY IN E-W FENCE LINE
S50°W 98.74' SET REMON NAIL & TAG N/S P. POLE
N55°E 24.06' FD COR. ANGLE IRON POST
N85°W 79.59' FD. PK TOP OF RR TIE FENCE POST

STATE OF MICHIGAN
BRYAN L. BOSS
Land Surveyor
NO. 29238
LICENSED LAND SURVEYOR

P.A. 345 1990, APPROVED BY LIVINGSTON COUNTY

PEER GROUP ON 6-16-99 CO. REP JED

Signed by _____ Date Nov. 11, 1999

Surveyor's Michigan License No. 29238

FORM APPROVED BY MICHIGAN STATE BOARD OF LAND SURVEYORS,
REVISED MAY 14, 19
REVISED JAN., 19