Muskegon Co.
10N-16W

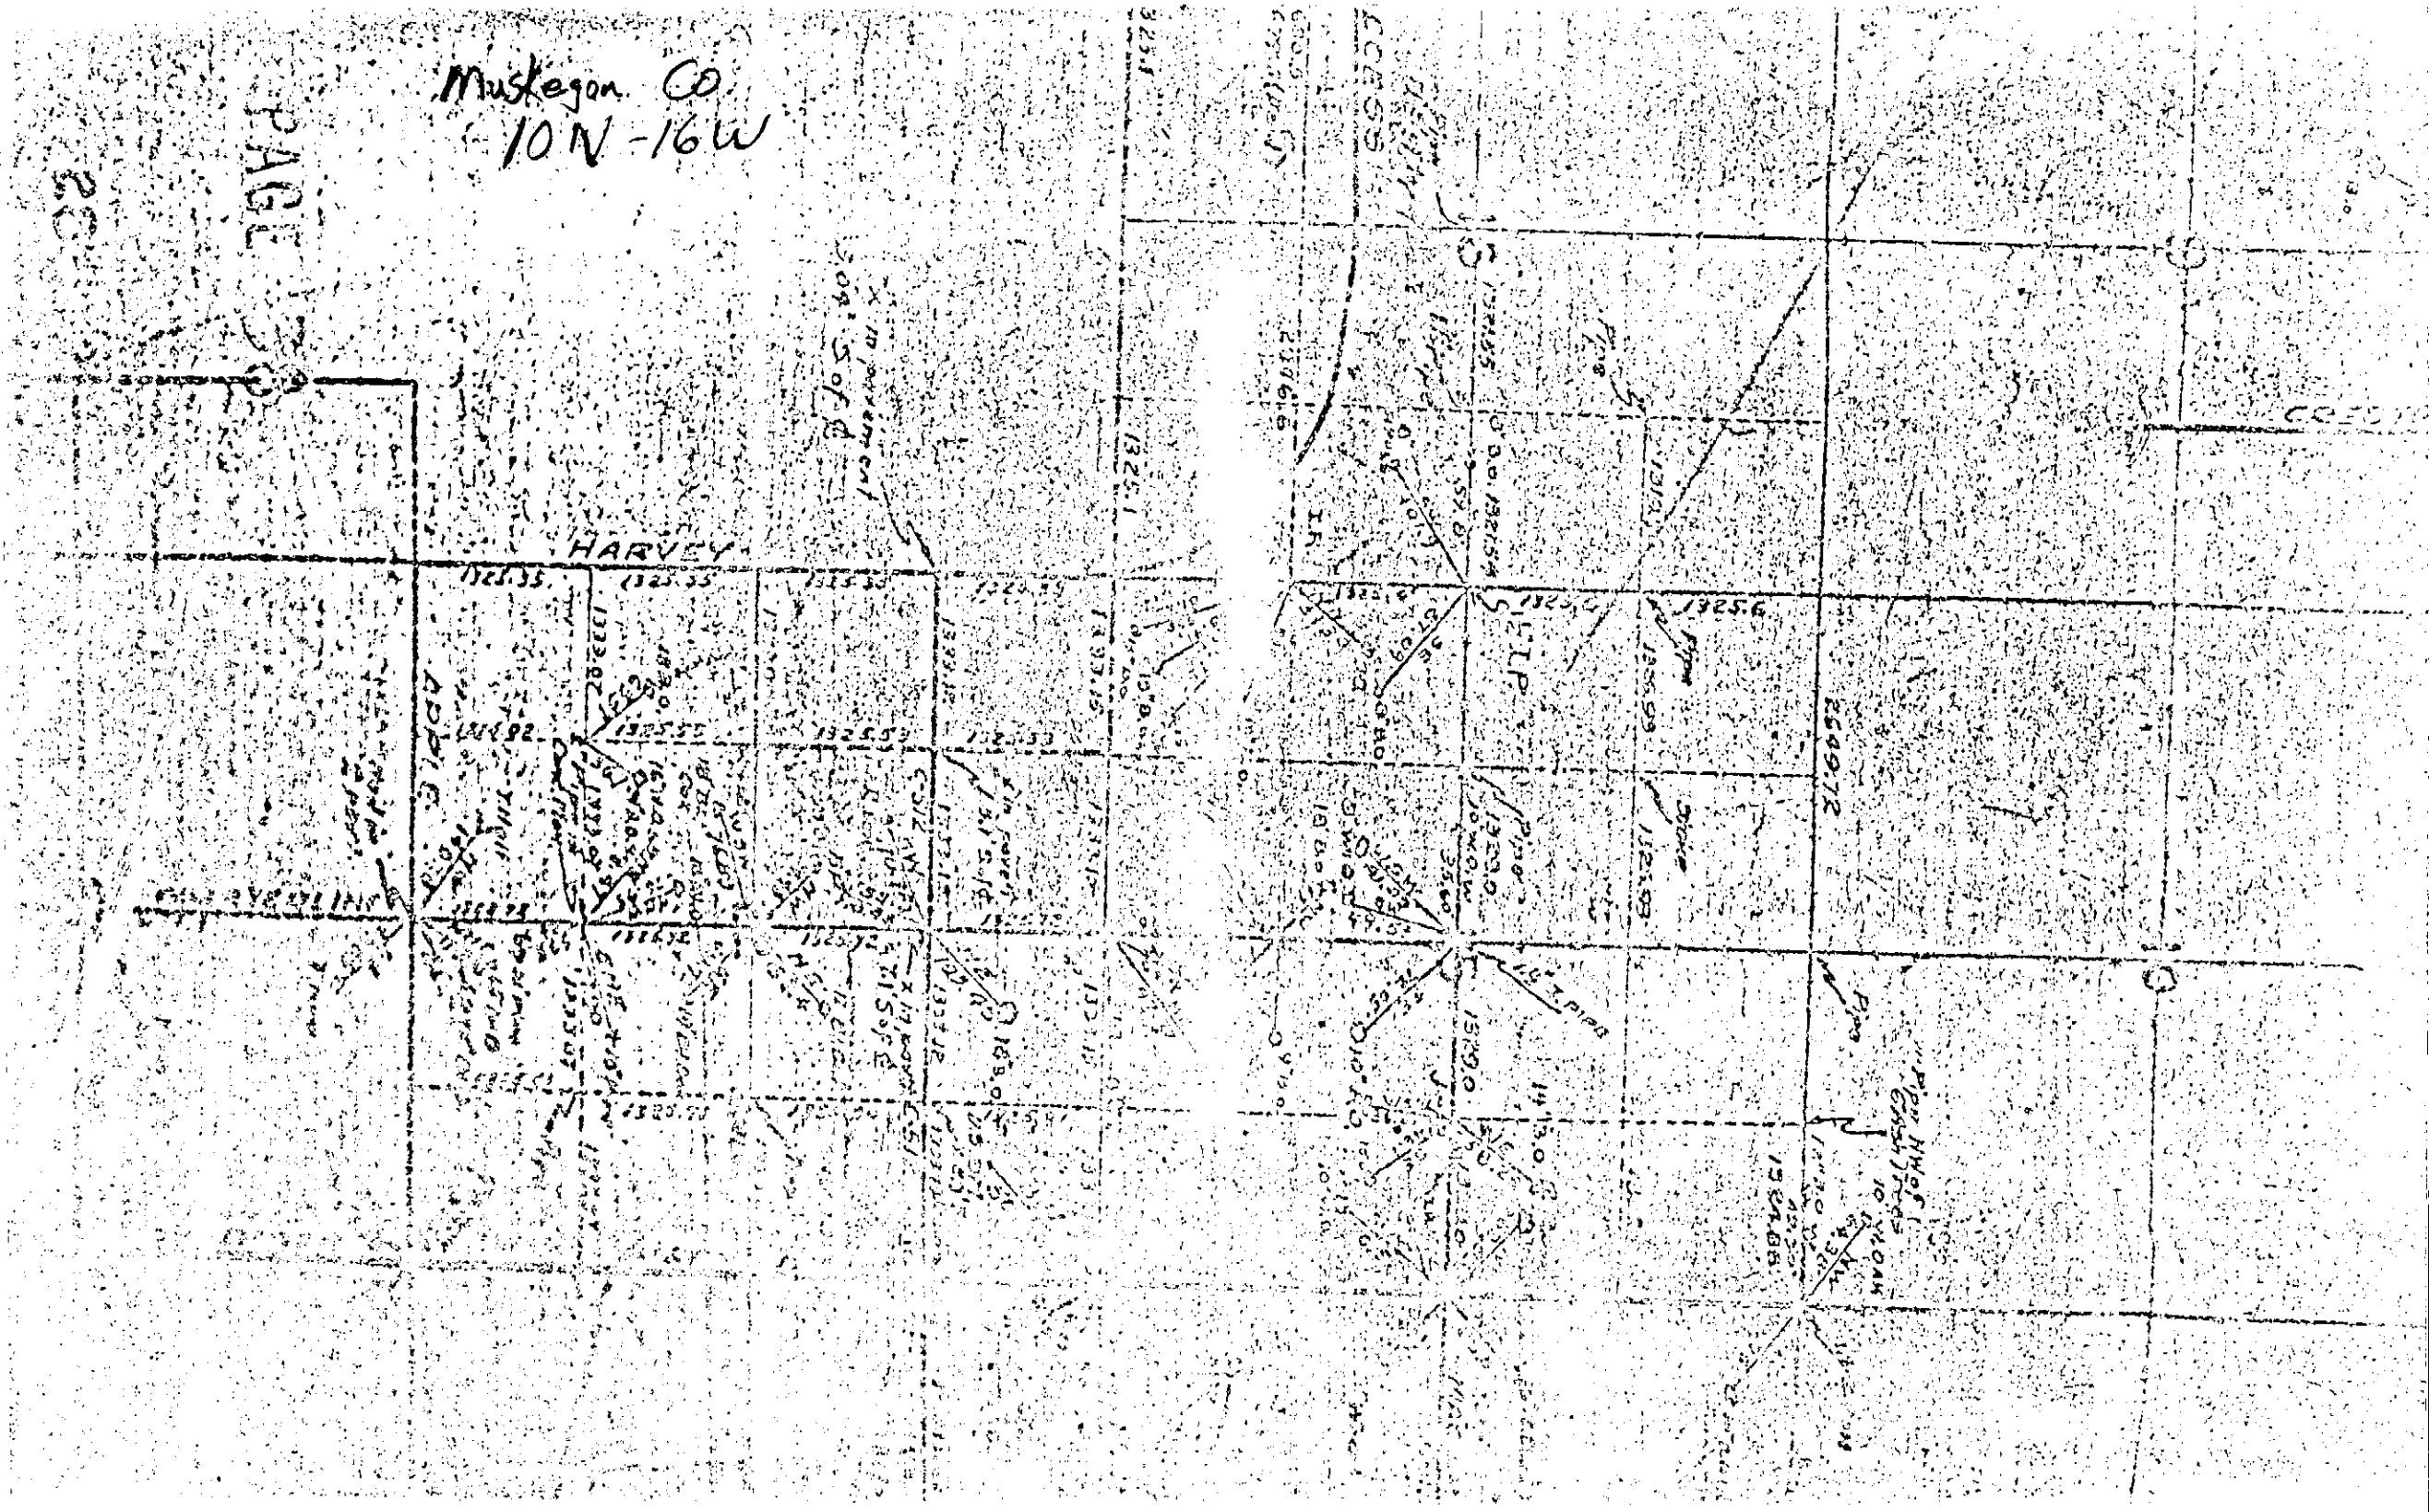
HARVEY
1325.35
1325.35
1325.35