Approved by Menominee County
Land Survey Remonumentation
Peer Group Under Act 345 Of
P.A. Of 1990 On 12/27, 1996
Mr Davis RLS
Chairman

LAND CORNER RECORDATION CERTIFICATE
Filing Requirement of Act 74, Mich. P.A. 1970

For corners in

MENOMINEE (County) Located In: Corner Code #

1. Public Land Survey		T~~37N~~ R~~25W~~	~~E01~~
		T___ R___	
		T___ R___	
		T___ R___	
2. Property Controlling	S___	T___ R___	
In Section	S___	T___ R___	
3. Miscellaneous	S___	T___ R___	
Property in Sec.	S___	T___ R___	

95 DEC 30 PM 9:08
454 BK 5

Register of Deeds Stamp & File Number

4. Lot No. _____, Recorded Plat _____
5. Private Claims _____

SAME AS CORNER E-13, T38N-R25W

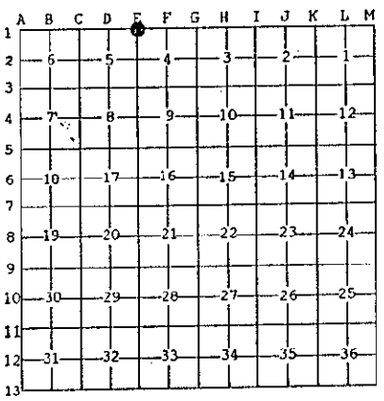

I, William Lenca, in a field survey on Jun. 13, 19 96 do hereby state that under requirements of P.A. 74, Michigan P.A. of 1970, the corner points mentioned in lines 1 and 2 above were in conformance with regulations and rules therefore as required in the current manual of survey instructions of the United States Department of the Interior, Bureau of Land Management or by a decree of a Court of Law and /or that the corner points mentioned in lines 3, 4 and 5 above were in conformance with the rules of the Michigan Board of Land Surveyors or by a Decree of a Court of Law; established, re-established, monumented, recovered, found as expressed below:

NOTE: Not more than 2 corners, all in the same town and range, may be recorded on this certificate.

A. Description of original monument and accessories and/or subsequent restoration:

1847: Original Survey (Twp Bdy) by James H. Mullett - B.T.'s - Hemlock, 12" - N37°E - 43 lks.; Birch,12" - N08°W - 42 lks. All original evidence for this corner has been destroyed by farming activities.

1852: Original Survey (Sec Subd) by George Adair - B.T.'s - Cedar, 14" - S52.5°E - 40 lks.; Cedar, 12" - S52°W - 27 lks. All original evidence for this corner has been destroyed by farming activities.

B. Description of corner evidence found and/or method applied in restoring or reestablishing corner:

We found an ancient fence corner in a location that matches well with distances to corners 1/2 mile West, 1 mile East of and 1/2 mile South. Mr. Robert Hanchek, a long time local resident, stated that the old fence lines had been in existence and accepted as the boundary for more than 60 years. We accepted the old fence corner as the best available evidence of the position of the original corner.

C. Description of monument for corner and accessories established to perpetuate locating the position of the corner: Set 2" dia. Aluminum Pipe/3-1/4" dia. Alum. cap stamped for corner location:

STATE OF MICHIGAN
WILLIAM LENCA
LAND SURVEYOR
No. 26461
REGISTERED LAND SURVEYOR

8" dia. Cedar	S54°E	45.93 feet	Scr. NBT
5" dia. Balsam	S08°W	13.65 feet	Scr. NBT
5" dia. Cedar	S70°W	85.26 feet	Scr. NBT
Metal Survey Sign Post	East	1.00 feet	

NOTE: All bearings are magnetic bearings. All distances are measured with steel tape. Distances to trees are to nail in side of tree.

Signed by William Lenca Date Dec. 20, 1996
Surveyor's Michigan License No. 26461

FORM APPROVED BY MICHIGAN STATE BOARD OF PROFESSIONAL SURVEYORS, JAN. 28, 19
REVISED MAY 14, 19
REVISED JAN., 19
REVISED OCT., 19

454