LAND CORNER RECORDATION CERTIFICATE

Filing Requirement of Act 74, Mich. P.A. 1970

For corners in
OSCEOLA
(County)

Located In: | Corner Code ##

1. Public Land Survey — T 19N R 9W — I-11
   T ____ R ____ — K-10
   T ____ R ____
   T ____ R ____
2. Property Controlling — S 26 T ____ R ____ — 7
   in Section — S 26 T ____ R ____ — 15
3. Miscellaneous — S ____ T ____ R ____
   Property in Sec. — S ____ T ____ R ____

Register of Deeds Stamp & File Number

4. Lot No. ____ , Recorded Plat ____
5. Private Claims ____

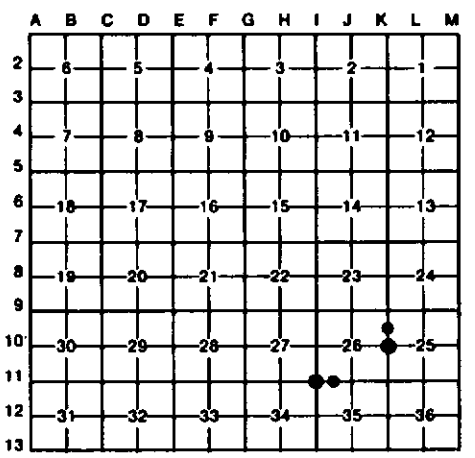

I, CARL F. ROSER, in a field survey on 02/09, 19 88, do hereby certify that under requirements of P.A. 74, Michigan P.A. of 1970, the corner points mentioned in lines 1 and 2 above were in conformance with regulations and rules therefore as required in the current manual of survey instructions of the United States Department of the Interior, Bureau of Land Management or by a decree of a Court of Law and/or that the corner points mentioned in lines 3, 4 and 5 above were in conformance with the rules of the Michigan Board of Land Surveyors or by a Decree of a Court of Law; established, re-established, monumented, re-monumented, recovered, found as expressed below:

NOTE: Not more than 4 corners, all in the same town and range, may be recorded on this certificate.

A. Description of original monument and accessories and/or subsequent restoration:

I-11	K-10	7	15

B. Description of corner evidence found and/or method applied in restoring or reestablishing corner:

I-11	K-10	7	15
THIS COR WAS RECOVERED AS AN OLD IR IN 3" TILE IN 1972 (TEMPLE 1892 COR FROM U.S.B.T.'S) BY THE DEPT IN 1972; IT HAS SINCE BEEN BUSTED OFF & DRIVEN OVER BY PULP CUTTER'S. WE RE-SET TILE & IR & ADDED DNR MON & CED POST.	FD TEMPLES 1892 IR ROD IN 3 VIT TILES; ADDED DNR MON. A. TEMPLE, CO SURVEYOR, HAD "BLAZE LINE CROSSING AT THAT POINT".	ESTAB. NE COR, S 1/2-NE 1/4, SEC. 26, PER STD BLM INSTRUCTIONS.	ESTAB SW COR, SE 1/4-SW 1/4, SEC. 26, PER STD BLM INSTRUCTIONS.

C. Description of monument for corner and accessories established to perpetuate locating the position of the corner:

I-11	K-10	7	15
FD 1/2" IR ROD IN TILE; ADDED DNR MON & CED POST W/LOC TAG.	FD 1/2" IR ROD IN 3-3" X 12" TILES; ADDED DNR MON & CED POST	DROVE 5/8" X 34" RE-ROD W/RLS CAP & SET CED POST.	DROVE 5/8" X 34" RE-ROD & SET CED POST W/LOC. TAG.
10" MAPLE IN	5" B. CHERRY N30°W 10.7'	2-12" SOFT MAPLES N10°E 17.9'	2" MAPLE N 5°W 40.3'
CLUMP 6 N15°W 39.5'	HI PT 3'13', 1 1/2' ABOVE	6" B.CHERRY S25°E 53.6'	2" MAPLE S10°W 35.1'
11" MAPLE S40°E 141.7'	GND, STONE N35°E 85'	16" SOFT MAPLE S30°W 24.5'	2" B.CHERRY N75°W 74.0'
20" R.OAK N65°W 47.7'	5" B. CHERRY S35°E 19.1'	11" SOFT MAPLE S85°W 17.3'	CTR CROOKED N-S
CTR LINE CROOKED	3" B. CHERRY S75°W 10.1'		TRAIL DUE E 25'
TRAIL S45°W 8.0'			

Signed by Carl F. Roser 02-05-91 Date ____

Surveyor's Michigan License No. 12028

STATE OF MICHIGAN
CARL F. ROSER
LAND SURVEYOR
No. 12028
REGISTERED LAND SURVEYOR

FORM APPROVED BY MICH... JAN. 28, 1971
...ED MAY 14, 1975
...EVISED JAN., 1983