9251
FEB 1 8 1994
COMMISSION

STATE OF MICHIGAN
COUNTY OF ROSCOMMON
REGISTER OF DEEDS
DEC 28 10 47 AM '93
REGISTER OF DEEDS

ROSCOMMON COUNTY REMONUMENTATION

LAND CORNER RECORDATION CERTIFICATE

Filing Requirement of Act 74, Mich. P.A. 1970

For corners in Roscommon (County)

	Located In:	Corner Code #
1. Public Land Survey	T 23 R 1 W	I - 7
	T ___ R ___	
	T ___ R ___	
	T ___ R ___	
2. Property Controlling	S ___ T ___ R ___	
in Section	S ___ T ___ R ___	
3. Miscellaneous	S ___ T ___ R ___	
Property in Sec.	S ___ T ___ R ___	

ROSCOMMON COUNTY PEER GROUP APPROVAL
DATE 12-14-93

Register of Deeds Stamp & File Number

4. Lot No. _____ , Recorded Plat _____
5. Private Claims _____

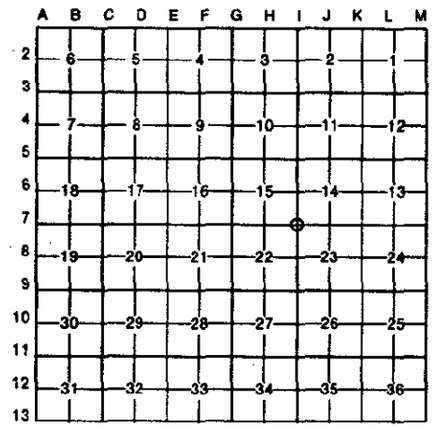

I, Frank J. Arleth, in a field survey on December, 19 93, do hereby certify that under requirements of P.A. 74, Michigan P.A. of 1970, the corner points mentioned in lines 1 and 2 above were in conformance with regulations and rules therefore as required in the current manual of survey instructions of the United States Department of the Interior, Bureau of Land Management or by a decree of a Court of Law and/or that the corner points mentioned in lines 3, 4 and 5 above were in conformance with the rules of the Michigan Board of Land Surveyors or by a Decree of a Court of Law; established, re-established, monumented, re-monumented, recovered, found as expressed below:

NOTE: Not more than 4 corners, all in the same town and range, may be recorded on this certificate.

A. Description of original monument and accessories and/or subsequent restoration:

William Burt set post 1852
Spruce 8" N62°E 27 Lks.
Cedar 10" S62°W 9 Lks.

B. Description of corner evidence found and/or method applied in restoring or reestablishing corner:

Northwest corner of Section 23, T23N, R1W., found ½" bar in pav't box, Note: in a section subdivision made of section 23 in 1954 he indicates a iron was found in center line of road.

Witness : 10" Tamarack E-SE 36.7
10" Tamarack N50°E 45.1

Witness: in R.C.R.C. book
8" cedar N20°W 83.5
4" cedar S43°W 61.2

C. Description of monument for corner and accessories established to perpetuate locating the position of the corner:

Set Roscommon County Std. Mon. Stamped I - 7 Note: corner in pav't box
M.D.O.T. Nail & tag 10" Tamarack S79°E 36.65
M.D.O.T. Nail & tag 6" Tamarack N52°E 45.24
M.D.O.t. Nail & tag in power pole N62°W 58.76
Nail & tag in 8" Tamarack S49°E 42.25

STATE OF MICHIGAN
FRANK J. ARLETH
SURVEYOR NO. 21266
LICENSED PROFESSIONAL SURVEYOR

Signed by Frank J. Arleth Date 22DEC 93

Surveyor's Michigan License No. 21266

Date December 14, 1993 **Peer Group Approved**

FORM APPROVED BY MICHIGAN STATE BOARD OF LAND SURVEYORS, JAN. 28, 1971
REVISED MAY 14, 1975
REVISED JAN., 1983

LIBER 3 PAGE 77