5043

LAND CORNER RECORDATION CERTIFICATE
Filing Requirement of Act 74, Mich. P.A. 1970

STATE OF MICHIGAN
ROSCOMMON COUNTY
RECORDED

8 JUN 99 3:50 P.M.

ROBERT W. SMITH
REGISTER OF DEEDS

FILE IN LIBER 3 OF LAND CORNERS
Register of Deeds Stamp & File Number

For corners in

Roscommon
(County)

	Located in:	Corner Code #
1. Public Land Survey	T 24N R 4W	C-1
	T ____ R ____	
	T ____ R ____	
	T ____ R ____	
2. Property Controlling	S ____ T ____ R ____	
in Section	S ____ T ____ R ____	
3. Miscellaneous	S ____ T ____ R ____	
Property in Sec.	S ____ T ____ R ____	

4. Lot No. _____ , Recorded Plat _____
5. Private Claims_____

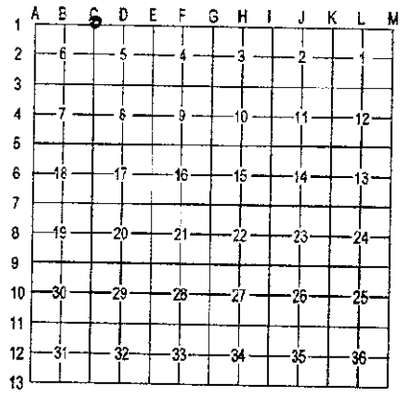

I, Marvin E. Myers, in a field survey on April, 1999 do hereby state that under requirements of P.A. 74, Michigan P.A. of 1970, the corner points mentioned in lines 1 and 2 above were in conformance with regulations and rules therefore as required in the current manual of survey instructions of the United States Department of the Interior, Bureau of Land Management or by a decree of a Court of Law and /or that the corner points mentioned in lines 3, 4 and 5 above were in conformance with the rules of the Michigan Board of Land Surveyors or by a Decree of a Court of Law; established, re-established, monumented, recovered, found as expressed below:

NOTE: Not more than 2 corners, all in the same town and range, may be recorded on this certificate.

A. Description of original monument and accessories and/or subsequent restoration:

G.L.O – 1839 John Brink, D.S.
Mon – Post
Wit: 17" Yellow Pine N45°E 25 lks.
10" Yellow Pine N33°W 80 lks.
GLO – August 1852 Addison P. Brewer, D.S.
Mon – Post
Wit: 8" Dead S. Pine S19°E 14 lks.
12" Dead S. Pine S35°W 53 lks.

Marcus Schaaf 1940's
Mon – Iron Set

B. Description of corner evidence found and/or method applied in restoring or reestablishing corner:
Found Schaaf 1 ½" pipe in concrete. Accepted pipe as the best available evidence of the position of the Original Corner. Replaced pipe with Standard Crawford County Monument.

C. Description of monument for corner and accessories established to perpetuate locating the position of the corner:
Mon: Standard Crawford County Monument.
Wit: West edge of Carsonite Post N71°E 31.0
Nail & tag NW side 5" W. Oak N78°E 33.40
Nail & tag SW side 2" Cherry S48°E 30.74
Nail & tag W. side 7" R. Oak N15°W 38.96

SURVEY &
RE[illegible]
MAR 1 1 2000
SECTION

ROSCOMMON COUNTY
PEER GROUP APPROVAL
DATE April 19, 1999
Marvin E. Myers MERM
Marvin E. Myers, P.S.
County Surveyor

STATE OF MICHIGAN
MARVIN E. MYERS
PROFESSIONAL SURVEYOR
No. 31600
LICENSED PROFESSIONAL SURVEYOR

Signed by Marvin E. Myers
Surveyor's Michigan License No. 31600

Date June 2, 1999

FORM APPROVED BY MICHIGAN STATE BOARD OF PROFESSIONAL SURVEYORS, JAN. 28, 1971
REVISED MAY 14, 1975
REVISED JAN., 1983
REVISED OCT., 1995

LIBER 3 PAGE 602