ST. CLAIR COUNTY, MICHIGAN
OFFICIAL GOVERNMENT CORNER

LAND CORNER RECORDATION CERTIFICATE
Filing Requirement of Act 74, Mich. P.A. 1970

		Located In:	Corner Code #/
		Port Huron Twp.	
1. Public Land Survey		T 6N. R 17E.	A-1
		T ____ R ____	
		T ____ R ____	
		T ____ R ____	
2. Property Controlling	S ____	T ____ R ____	
in Section	S ____	T ____ R ____	Seg. 2
3. Miscellaneous	S ____	T ____ R ____	
Property in Sec.	S ____	T ____ R ____	

1995 AUG -4 AM 10: 23
REGISTER OF DEEDS ST. CLAIR COUNTY
RECEIVED

Register of Deeds Stamp & File Number

4. Lot No. _____ , Recorded Plat _____
5. Private Claims _____

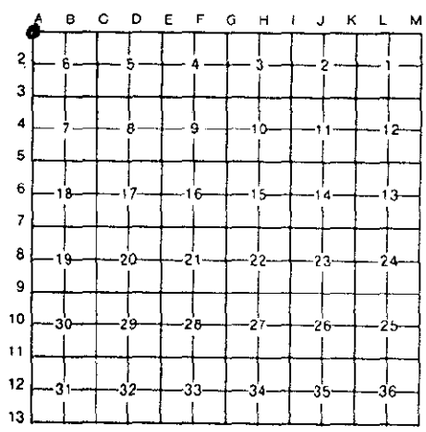

Daniel E. Johnson May 11 95

I, _____ , in a field survey on _____ , 19 _____ , do hereby certify that under requirements of P.A. 74, Michigan P.A. of 1970, the corner points mentioned in lines 1 and 2 above were in conformance with regulations and rules therefore as required in the current manual of survey instructions of the United States Department of the Interior, Bureau of Land Management or by a decree of a Court of Law and/or that the corner points mentioned in lines 3, 4 and 5 above were in conformance with the rules of the Michigan Board of Land Surveyors or by a Decree of a Court of Law; established, re-established, monumented, re-monumented, recovered, found as expressed below:

NOTE: Not more than 1 corner, may be recorded on this certificate.

A. Description of original monument and accessories and/or subsequent restoration:

LIBER 007 PAGE 380

STATE PLAIN COORDINATES

N. _____

E. _____

ELEVATION _____

B. Description of corner evidence found and/or method applied in restoring or reestablishing corner:

LIBER 007 PAGE 380

STATE OF MICHIGAN
DANIEL E. JOHNSON
LAND SURVEYOR
13754
REGISTERED LAND SURVEYOR

C. Description of monument for corner and accessories established to perpetuate locating the position of the corner:

Set 1/2" Rebar with 2" dia. aluminum cap inscribed "St. Clair County Official Corner" with magnet (in monument box) on a
1 1/2" iron pipe in monument box in centerline of existing pavement of W. Water St. and Range Rd. to south. Corner common to M-1, T6N-R16E.
Located on the true Township Line.
S 54°E 70.71' to set PK nail w/county remon tag in N side power pole
N 42°30'E 74.21' to set PK nail w/county remon tag in W side power pole
N 65°W 95.82' to set PK nail w/county remon tag in S side pwer pole
S 40°W 41.74' to set PK nail w/county remon tag in NW side power pole
WEST 2768.57' to N 1/4 corner, Section 1, T6N-R16E
EAST 2648.11' to N 1/4 corner, Section 6, T6N-R17E

Signed by Daniel E. Johnson Date May 11, 1995

Daniel E. Johnson

Surveyor's Michigan License No. 13754

PA 345-1990
PEER COMMITTEE
APPROVED 6-17-94

APPROVED AS AN OFFICIAL GOVERNMENT CORNER BY ST. CLAIR COUNTY:

Signed By: Daniel E. Johnson : 7-31-95

St. Clair County Land Surveyor Daniel E. Johnson 13754 Date

Surveyor's Michigan License No. _____

LIBER 008 PAGE 166