


J. B. Crane's subdivision of Oak lots 117, 118, 119, 120, 127, 128, 129, 130, 131, 132 Mullett farm City of Detroit 1852.

Recd for record this 22 day of July 1854
at 12 o'clock noon
Henry Campau
Register

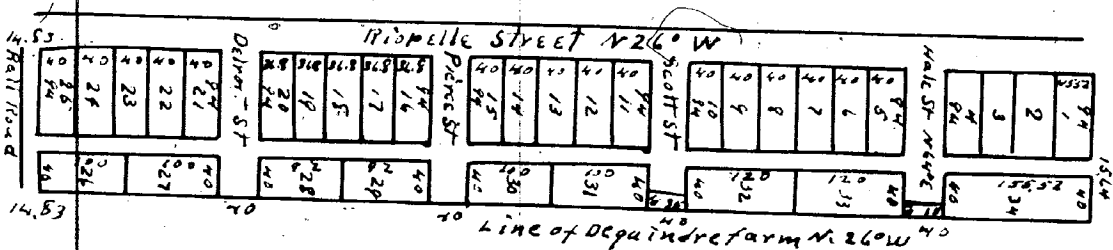


10095

I Certify that this Plat is correct as by
actual survey and calculation Detroit
Oct 19. 1854 John F. Monro Surveyor

J. B. Crane's subdivision of lots 117, 118, 119, 120, 127, 128, 129, 130, 131, 132 Mullett farm City of Detroit

Received for record this 22nd July 1854
at 12 o'clock noon.

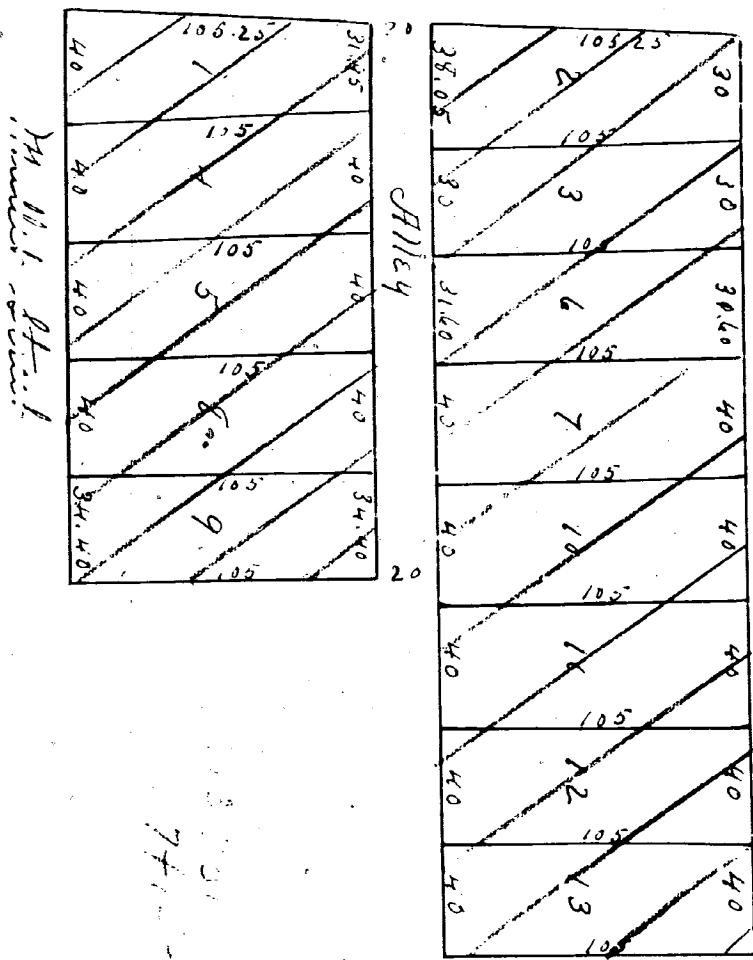

10094

Know all men by these presents that we J. B. Crane and Anna
Crane & Elizabeth his wife of Detroit Michigan do hereby present for record the above
said the annexed plat being a subdivision of lots 117, 118, 119, 120
127, 128, 129, 130, 131, 132 Mullett farm City of Detroit and do dedicate
to the perpetual use of the public the alley shown running between the same may be
we have and assign the reservation thereof whenever the same may be
discontinued by law Witness our hands and the 27 July 1853
Created in presence of
Walter Crane
M. Dunn

J. B. Crane
A. E. Crane

State of Michigan ss On this 27 July 1853 the above named
Wayne County } J. B. Crane & Anna & Elizabeth his wife
to me known as the persons described in and who created the above in
abundant appeared before me and duly acknowledged the execution thereof
and the said Anna & Elizabeth on a private examination separate and
apart from her husband acknowledged she created the same freely without
fraud or compulsion of her said husband or any one

Walter Crane

Notary Public

Wayne Co Mich

I hereby certify that these facts are correct as by actual survey and calculation
on record in the Register of Deeds office being made under the
authorization of the Auditor General by having the plat measured
and affixing thereto a carefully compared copy of the dedication
& certificate.
Dated this 12th day of May 1854.

John B. Fountain
Clerk and Ex. Deput.

J. B. Crane
A. E. Crane

Know all men by these presents that we J. B. Crane and Anna
& Elizabeth his wife of Detroit Michigan do hereby present for record the above
plat being a subdivision of our lots fifty three fifty four fifty seven
fifty eight, Roselle farm North Detroit road City of Detroit and do
dedicate to the perpetual use of the public the alley and oblique thorough
running between the same and assign the reservation thereof whenever
the same may be discontinued by law Witness our hands and the
the 19th day of July 1853
Created in presence of
Walter Crane
M. Dunn

State of Michigan ss On this 27th day of July 1853 the above
Wayne County } named J. B. Crane and Anna & Elizabeth
his wife to me known as the persons who created the above instrument
duly acknowledged the execution thereof And the said Anna & Elizabeth
on a private examination separate and apart from her said husband
acknowledged she created the same freely without fraud or compulsion
of her said husband or any one

Walter Crane
Notary Public
Wayne Co Mich

10094

Scott Street, as platted in F. J. B. Crane's Subdivision of Outlots 23, 54, 57 and 58 of Riopelle Farm as recorded in Liber 53, Page 346 of Deeds Wayne County Records lying east of and adjoining the easterly line of Lots 11 to 15 both inclusive, and adjoining the western line of the 15.64 foot alley lying between the line of Lots 30 and 31 and the above mentioned subdivision;

Also, all of the north-south public alley, 15.64 feet wide, east of Riopelle Street, between Scott Street and Erskine Street as platted in F. J. B. Crane's Subdivision of Outlots 53, 54, 57 and 58 of Riopelle Farm as recorded in Liber 53, Page 346 of Deeds Wayne County Records lying east of adjoining the easterly line of Lots 16 to 19 both inclusive, and adjoining the western line of Lots 28 and 29, all of the above mentioned subdivision;

Be and the said hereby vacated a part and parcel of the adjoining property; and further

Resolved, That all that part of said street, 50 feet wide, east of Riopelle Street, the southerly 40.00 feet of said street as platted in F. J. B. Crane's Subdivision of Outlots 53, 54, 57 and 58 of Riopelle Farm as recorded in Liber 53, Page 346 of Deeds Wayne County Records lying north of and adjoining the southerly line of the 15.64 foot alley lying between Lots 1 and 31, south of and adjoining the southerly line of Lots 10 and 32 south of and adjoining the southerly line of the 15.64 foot alley lying between Lots 10 and 22, south of and adjoining the southerly line of the north 10.00 feet of said Scott Street, as opened through condemnation proceedings in 1885, File 10,000, south of and adjoining the 10.00 feet of Lots 10 and 32 of F. J. B. Crane's Subdivision of Outlots 53, 54, 57 and 58 Riopelle Farm as recorded in Liber 53, Page 346 of Deeds Wayne County Records;

Also, all that part of Scott Street, 50 feet wide, west of Orleans Street, as platted in the Plat of the Subdivision of the Riopelle Farm, the Rear of Dequindre Farm as recorded in Liber 53, Page 195 of Deeds Wayne County Records lying south of and adjoining the southerly line of Lots 61 to 65, both inclusive, north of and adjoining the northerly line of Lots 76 to 80 both inclusive, all of the above mentioned subdivision;

Also, all of the north-south public alley, 15.64 feet wide, east of Riopelle Street between Scott Street and Hale Street as platted in F. J. B. Crane's Subdivision of Outlots 53, 54, 57 and 58, Riopelle Farm as recorded in Liber 53, Page 346 of Deeds Wayne County Records lying east of and adjoining the easterly line of Lot 5 to 10, both inclusive, west of and

adjoining the westerly line of Lots 32 and 33, all of the above-mentioned subdivision;

2) That that part of the east-west public alley, 20 feet wide, east of Ripellee Street between Hale Street and Scott Street, as platted in the plat of Subdivision of Lot 5 of Block 58, Lots 53, 54, 57 and 58, Ripellee Farm as recorded in Liber 53, Page 346 of Deeds Wayne County Records lying north of and adjoining the easterly line of Lot 33, north of and adjoining the northerly line of Lot 32, all of the above mentioned subdivision;

3) Also all that part of the east-west public alley, 20 feet wide, west of Orleans Street between Hule Street and Scott Street, as platted in the Plat of Subdivision of Lot 5 of Subdivision of Rear of Degundine Farm as recorded in Liber 53 Page 195 of Deeds Wayne County Records lying north of and adjoining the northerly line of Lots 61 to 65, both inclusive, south of and adjoining the easterly line of Lot 33, both inclusive, all of the above mentioned subdivision.

Be and the same are hereby vacated as to the streets and alleys to become a part and parcel of the adjoining property subject to the following provisions:

That by reason of the vacation of the above described street and alleys, the City of Detroit does hereby certify that the lots so located therein and at all times shall have the right to enter upon the premises, if found necessary on account of the construction, alteration or service same; and further:

2) Provided, That if a building is to be constructed over said sewer, it shall be constructed of brick or cast-iron pipe of same size, routed or encased in 8 inches of Class "A" concrete, or in lieu of the above, the City Engineer may specify by the City Engineer, all of the work mentioned to be done under the supervision and control of the Department of Public Works and all costs entailed to be borne by the petitioners, their successors, or assigns.

3) Provided, That no buildings shall be constructed over said sewer without the prior approval of such action of the City Engineer, the City Engineer and the Department of Buildings and Safety Engineering; and

4) Provided, That in the event that the sewer located in said street and alleys, if built upon, shall break causing damage to any constructions thereon, the City Engineer shall post signs by acceptance of the permit for building over said sewer, waive all claims for damages to such constructions, and shall be liable in damages incident to the repair of said broken sewer; and further

Resolved, That the petitioner at the City Council Chamber, do construct a new manhole in Scott Street at the alley east of Ripellee Street.

Adopted as follows:
Yeas—Councilmen Brickley, Connor, Patrick, Ravitz, Rogell, Van Hook, Wainwright
Nays—President Carey—8.


Nays—None.

SHORT FORM--TRUE COPY CERTIFICATE

as appears from the Journal of said Common Council, on file in my office,

IN WITNESS WHEREOF, I have hereunto
set my hand and affixed the Corporate
Seal of said City, at Detroit, on

Thomas D. Headlutt
City Clerk

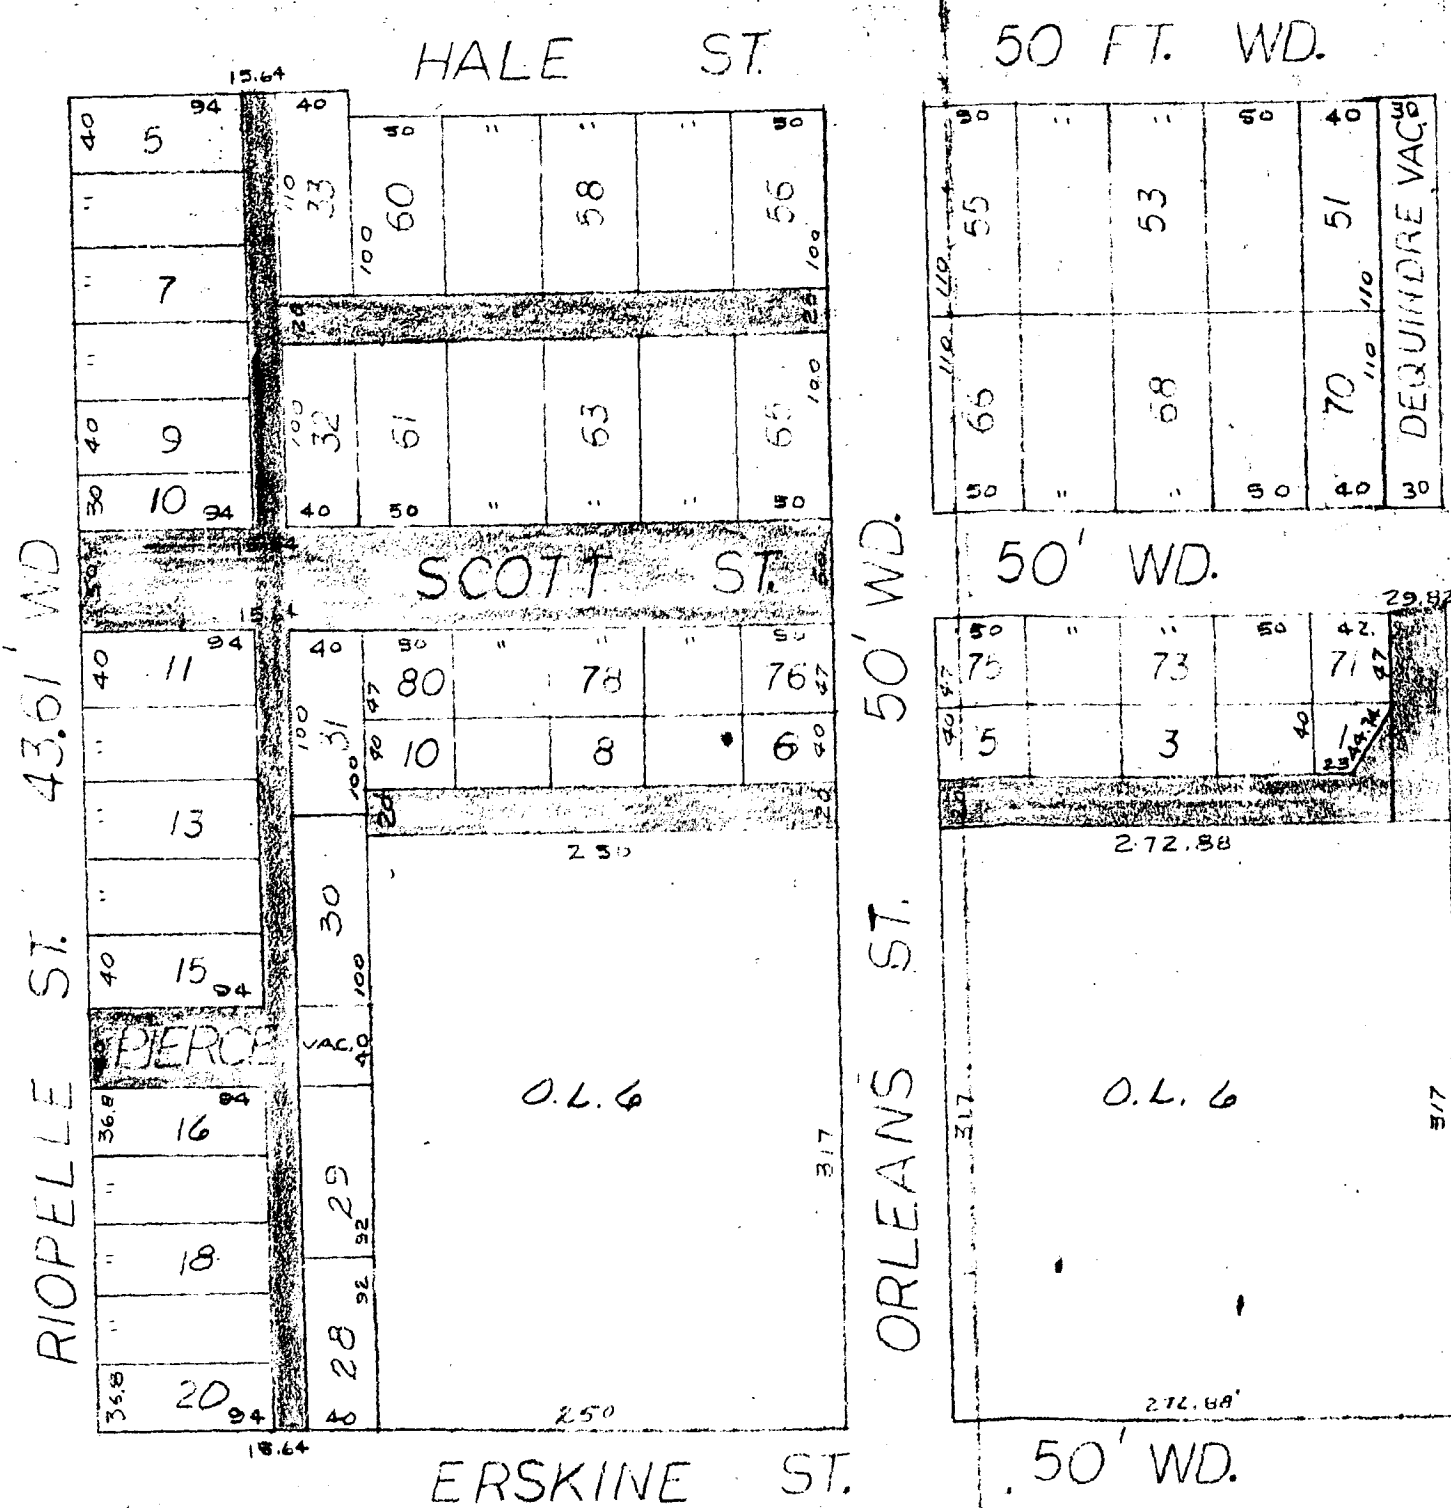

REQUESTED VACATIONS
STREETS & ALLEYS
IN RED

PETITIONER:
DEPARTMENT OF WATER SUPPLY

CRANE'S SUB'N
FARRAND'S SUB'N
PLAT OF DEQUINDRE FARM
TOPO. 39

FOR OFFICE USE ONLY

F		DESIGNED BY		APPROVED:		CITY OF DETROIT DEPARTMENT OF PUBLIC WORKS CITY ENGINEER'S OFFICE BUREAU OF DESIGN	REQUESTED VACATION AREA
E							BOUNDED BY RIOPELLE, HALE,
D		DRAWN BY	W. J. K.				GRAND TRUNK RR, & ERSKINE
C							
B		TRACED BY		ENGINEER OF			
A							
DESCRIPTION		DRW.	CKD.	APR.	DATE	Form C of D-346-EN-A	BOOK NO. SCALE 1" = 100' DATE 2-18-63 DRG. NO. X-2192
CHECKED BY R. K.		CITY ENGINEER					