


Bro Alfred Denny

May 28 1839

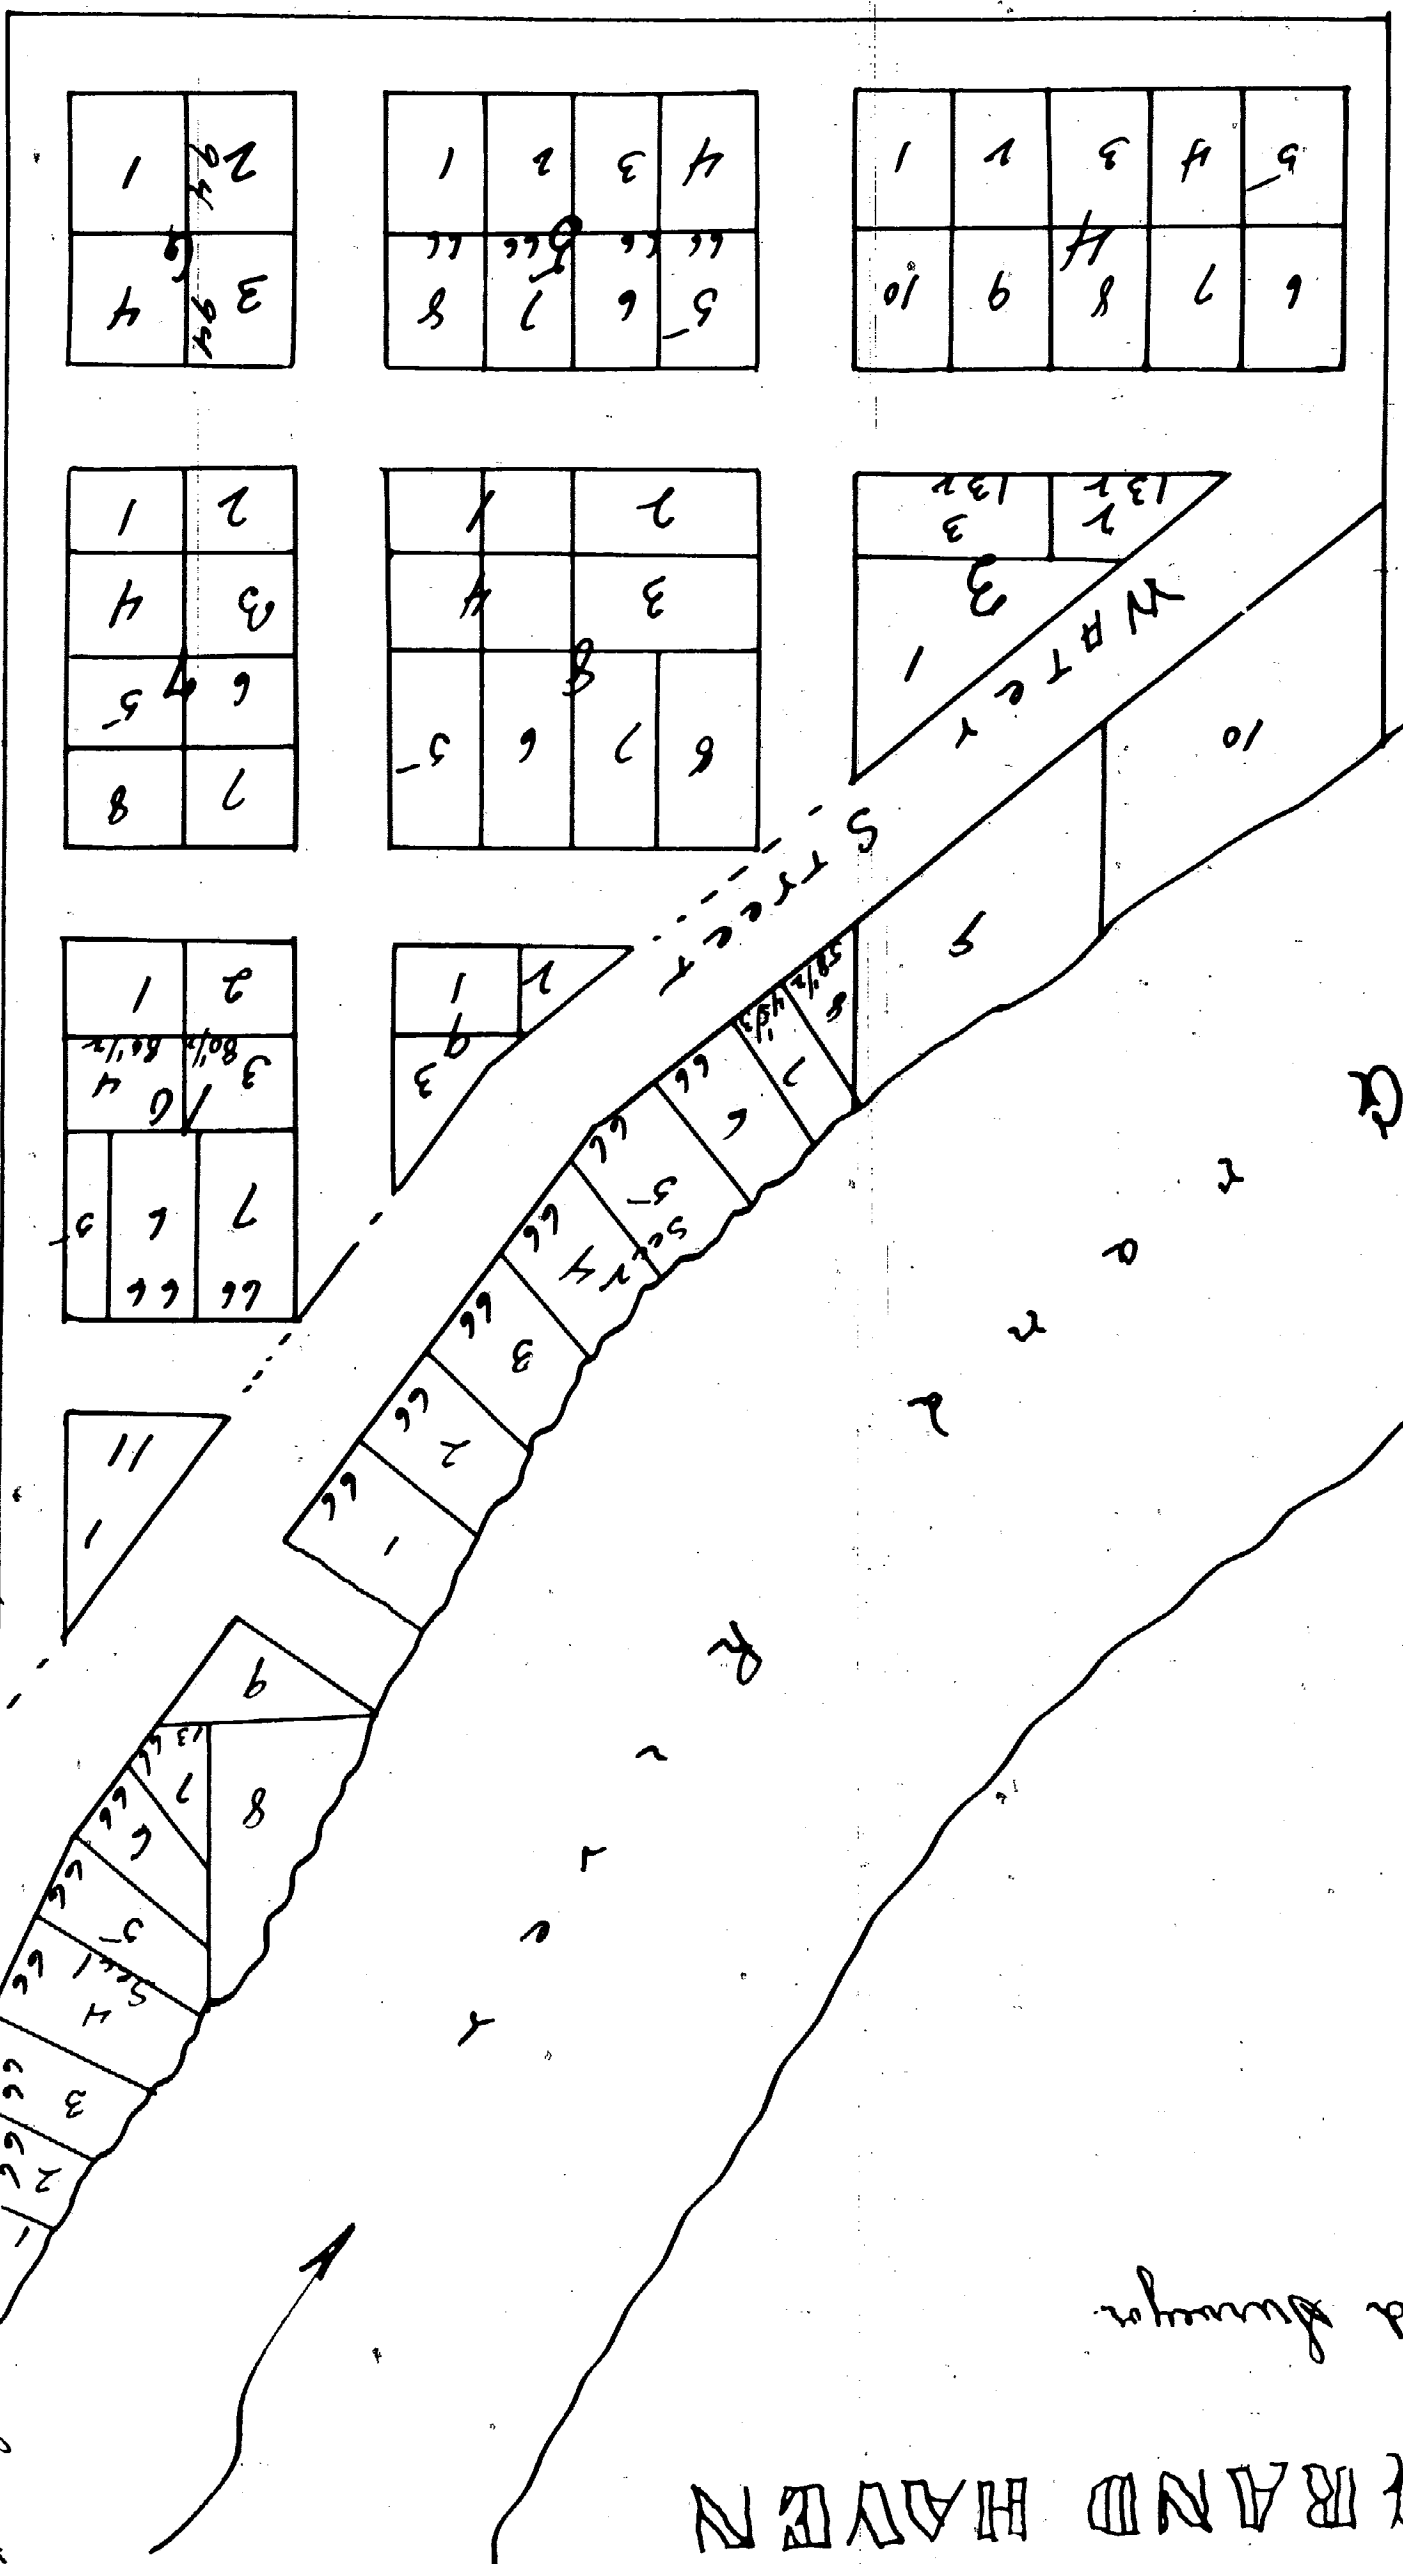

State of Michigan } On the second day of Sept
Ottawa County } ss. A. 1847. Jurament of Affirmation

I have me a notary Public for said County
Thos. Canham, the foregoing names of the said
Village / that is and well known and believe
to be that is identical the same for the
said and purpose herein expressed
W. B. Nichols, Notary



 17 B. Walker. Military Route

[illegible]

Lot No 1	15	CHANGED	to Lot No 19 Bu
2	"	"	"
3	"	"	"
4	"	"	"
5	"	"	"
33	"	"	"
34	"	"	"
35	"	"	"
36	"	"	"
37	"	"	"
38	"	"	"
39	"	"	"
40	"	"	"
48	"	"	"
49	"	"	"
0	"	"	"

[illegible]

10297

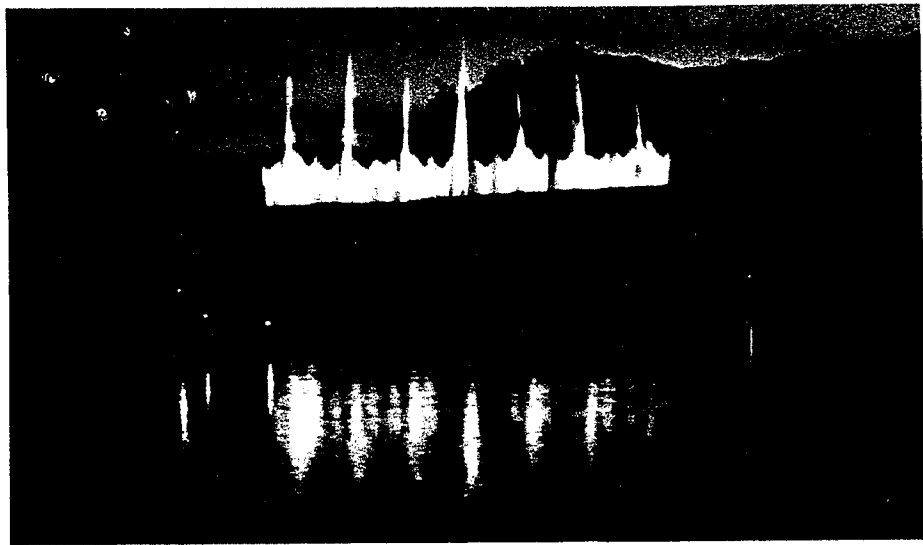

Grand Haven Musical Fountain

City of Grand Haven

Grand Haven, Michigan 49417
Telephone 616/842-3210

July 14, 1981

Michigan Department of Treasury
Bureau of Local Government Services
Treasury Building
Lansing, Michigan 48922


Dear Sir (Madam):

I have enclosed a copy of a resolution by the Grand Haven City Council vacating a portion of Sand Street. Also attached is a map of the area to assist you in locating the vacated portion of Sand Street.

Sincerely yours,

William Swier Jr.
City Clerk

WS/cs
Enclosures (2)

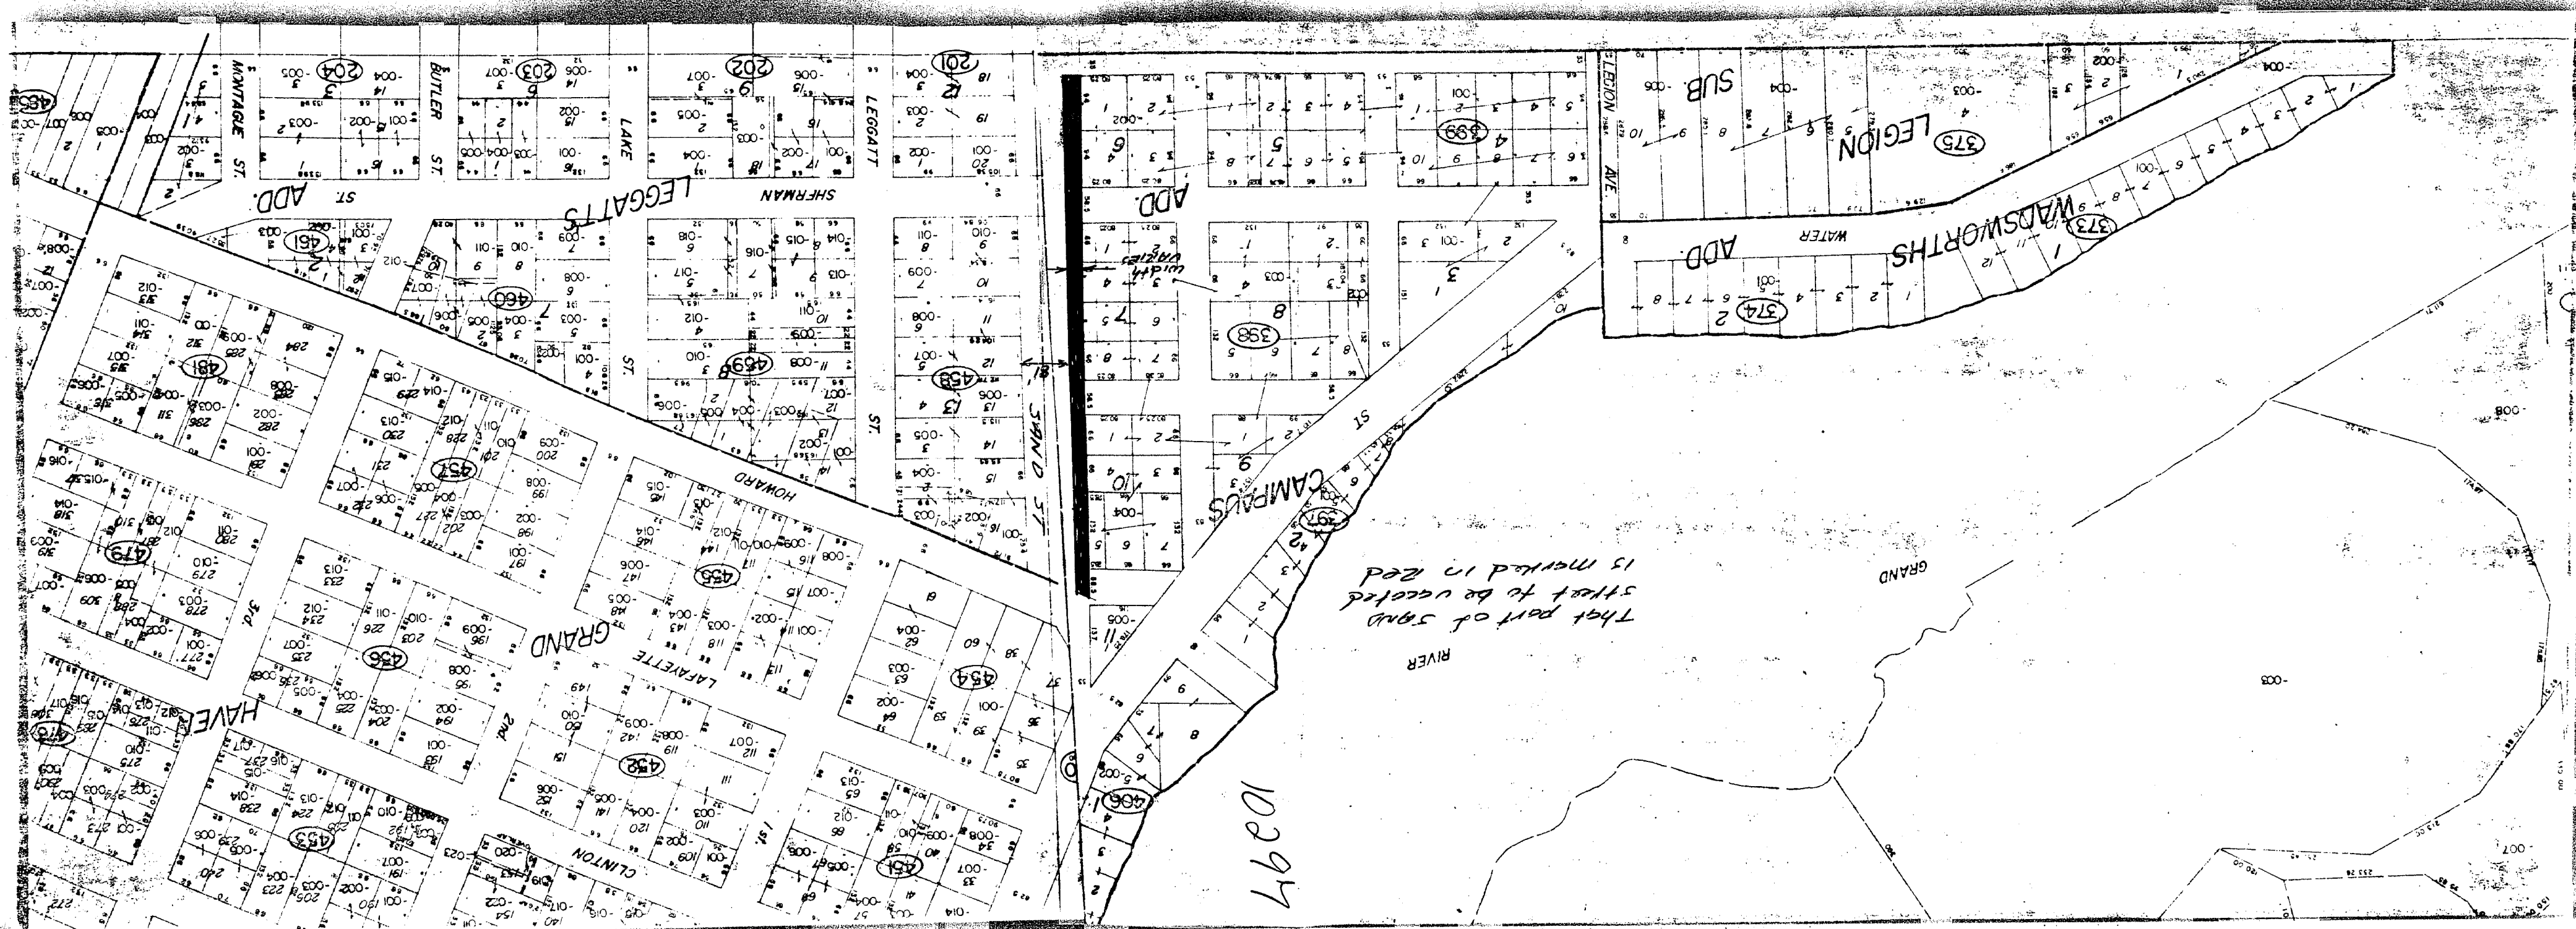

10297

That part of SAND street to be vacated is marked in red

EXCERPTS OF MINUTES

At a regular meeting of the City Council of the City of Grand Haven, Ottawa County, Michigan, held in the City Hall in said City on the 29th day of June, 1981, with a quorum present;

Present: Councilmembers Boon, Klaassen, Rose, Verseput, Mayor Bol

Absent: None

The following resolution was offered by Councilmember Rose and supported by Councilmember Verseput:

"RESOLUTION

WHEREAS, the Ordinances of the City of Grand Haven, as authorized by the laws of the State of Michigan, provide that the City Council of the City of Grand Haven has the power to vacate or abolish any highway, street, lane or alley, and other matters, whenever such Council shall deem the same to be a public improvement or necessary for the public convenience, and when the Council deems it advisable to vacate, discontinue or abolish any highway, street or any part thereof, the said Ordinance provides, pursuant to Title VII of the Code of Ordinances of the City of Grand Haven, after a hearing by the Planning Commission of the City of Grand Haven and the making of a recommendation by such Planning Commission, and a hearing held by the City Council which considers the recommendation of such Planning Commission, the City Council may, by resolution, vacate a street, alley or public ground, or any part thereof; and

WHEREAS, the City Council of the City of Grand Haven scheduled and held a public hearing on Monday, June 29, 1981, to consider and determine whether it should vacate and abandon part of the following described street as situated in the City of Grand Haven, Ottawa County, Michigan; and

WHEREAS, notice has been given to the public with respect to this hearing, as provided in such Ordinance; and

WHEREAS, the parcel of property to be affected by the hearing is situated in the City of Grand Haven, County of Ottawa and State of Michigan, and described as follows:

All of that part of Sand Street (sometimes referred to as "Liberty Street") lying between Sherman and Howard Streets and being part of Campau's Addition and Leggat's Addition to the City of Grand Haven, except the East 81.00 feet thereof.

NOW, THEREFORE, BE IT RESOLVED, that the City Council of the City of Grand Haven deems it advisable to vacate that part of Sand Street as situated between Sherman and Howard Streets in the City of Grand Haven, and comprising part of the Plat of Campau's Addition along the Westerly side thereof, and part of the Plat of Leggat's Addition along the Easterly side thereof, as herein described, viz:

All of that part of Sand Street (sometimes referred to as "Liberty Street") lying between Sherman and Howard Streets and being part of Campau's Addition and Leggat's Addition to the City of Grand Haven, except the East 81.00 feet thereof.

BE IT FURTHER RESOLVED, that title to said part of Sand Street, as situated between Sherman and Howard Streets, as herein vacated, shall vest in the property owners adjoining such part of Sand Street as provided by the statutes and laws of the State of Michigan.

BE IT FURTHER RESOLVED, that the City of Grand Haven retains and reserves unto itself, and its successors and assigns, a non-exclusive utility line easement for that portion of Sand Street, as vacated herein, and for its entire length, both for utilities presently existing therein and any which may hereafter be located therein by the City of Grand Haven and its successors and assigns, with the further condition that no permanent structures may be located within said portion of Sand Street vacated herein except utility structures.

BE IT FURTHER RESOLVED, that within thirty (30) days of the date of adoption of this resolution the City Clerk of the City of Grand Haven shall record a certified copy of this resolution with the Register of Deeds office for the County of Ottawa, State of Michigan, and forward a certified copy of this resolution to the Treasurer of the State of Michigan."

Yes: Boon, Klaassen, Rose, Verseput, Mayor Bol

No: None

RESOLUTION DECLARED ADOPTED.

Dated this 29th day of June, 1981.

William Swier, Jr.
William Swier, Jr.
City Clerk
City of Grand Haven

CERTIFICATE

STATE OF MICHIGAN)
ss.
COUNTY OF OTTAWA)

WILLIAM SWIER, JR., being first duly sworn, deposes and says that he is the CITY CLERK of the CITY OF GRAND HAVEN, and the above described resolution was adopted at a regular meeting of the City Council of the City of Grand Haven held on the 29th day of June, 1981, at which a quorum was present.

William Swier, Jr.
William Swier, Jr.

Subscribed and sworn to before me, a Notary Public, in and for said County, this 13th day of July, 1981.

PREPARED BY THOMAS M. BOVEN
SCHOLTEN AND FARR
A PROFESSIONAL CORPORATION
ATTORNEYS AT LAW
SUITE 202
SECURITY FIRST BANK & TRUST CO. BLDG.
GRAND HAVEN, MICH. 49417

Clara M. Salisbury
Clara M. Salisbury
Notary Public
Ottawa County, Michigan

My Commission Expires: 8-14-82