


I hereby certify that this Plat is a correct copy of the Plat now on Record in the Register of Deeds Office being made under the supervision of the Auditor General by tracing the Plat on Record and affixing thereto a carefully compared copy of the Certificate
 Dated the 28th day of March 1911
 Alton B. Hunt
 Clerk, Aud Gen Rept.

ST. NAME CHG.
 520-54
 23
 101

Survey of Jackson Township
 In witness whereof we have hereunto set our hands and seals this 1st day of May 1905
 Wesley Dean Register of Deeds
 Charles W. Reed Township Clerk
 (SEE LIAISON of DEEDS Page 529)

PLAT
OF
FORD'S N. ADDITION, FORD'S EXTENSION
&
ELM GROVE ADDITION
TO THE
VILLAGE OF
JACKSON.

DRAWN BY C. H. HALLITT

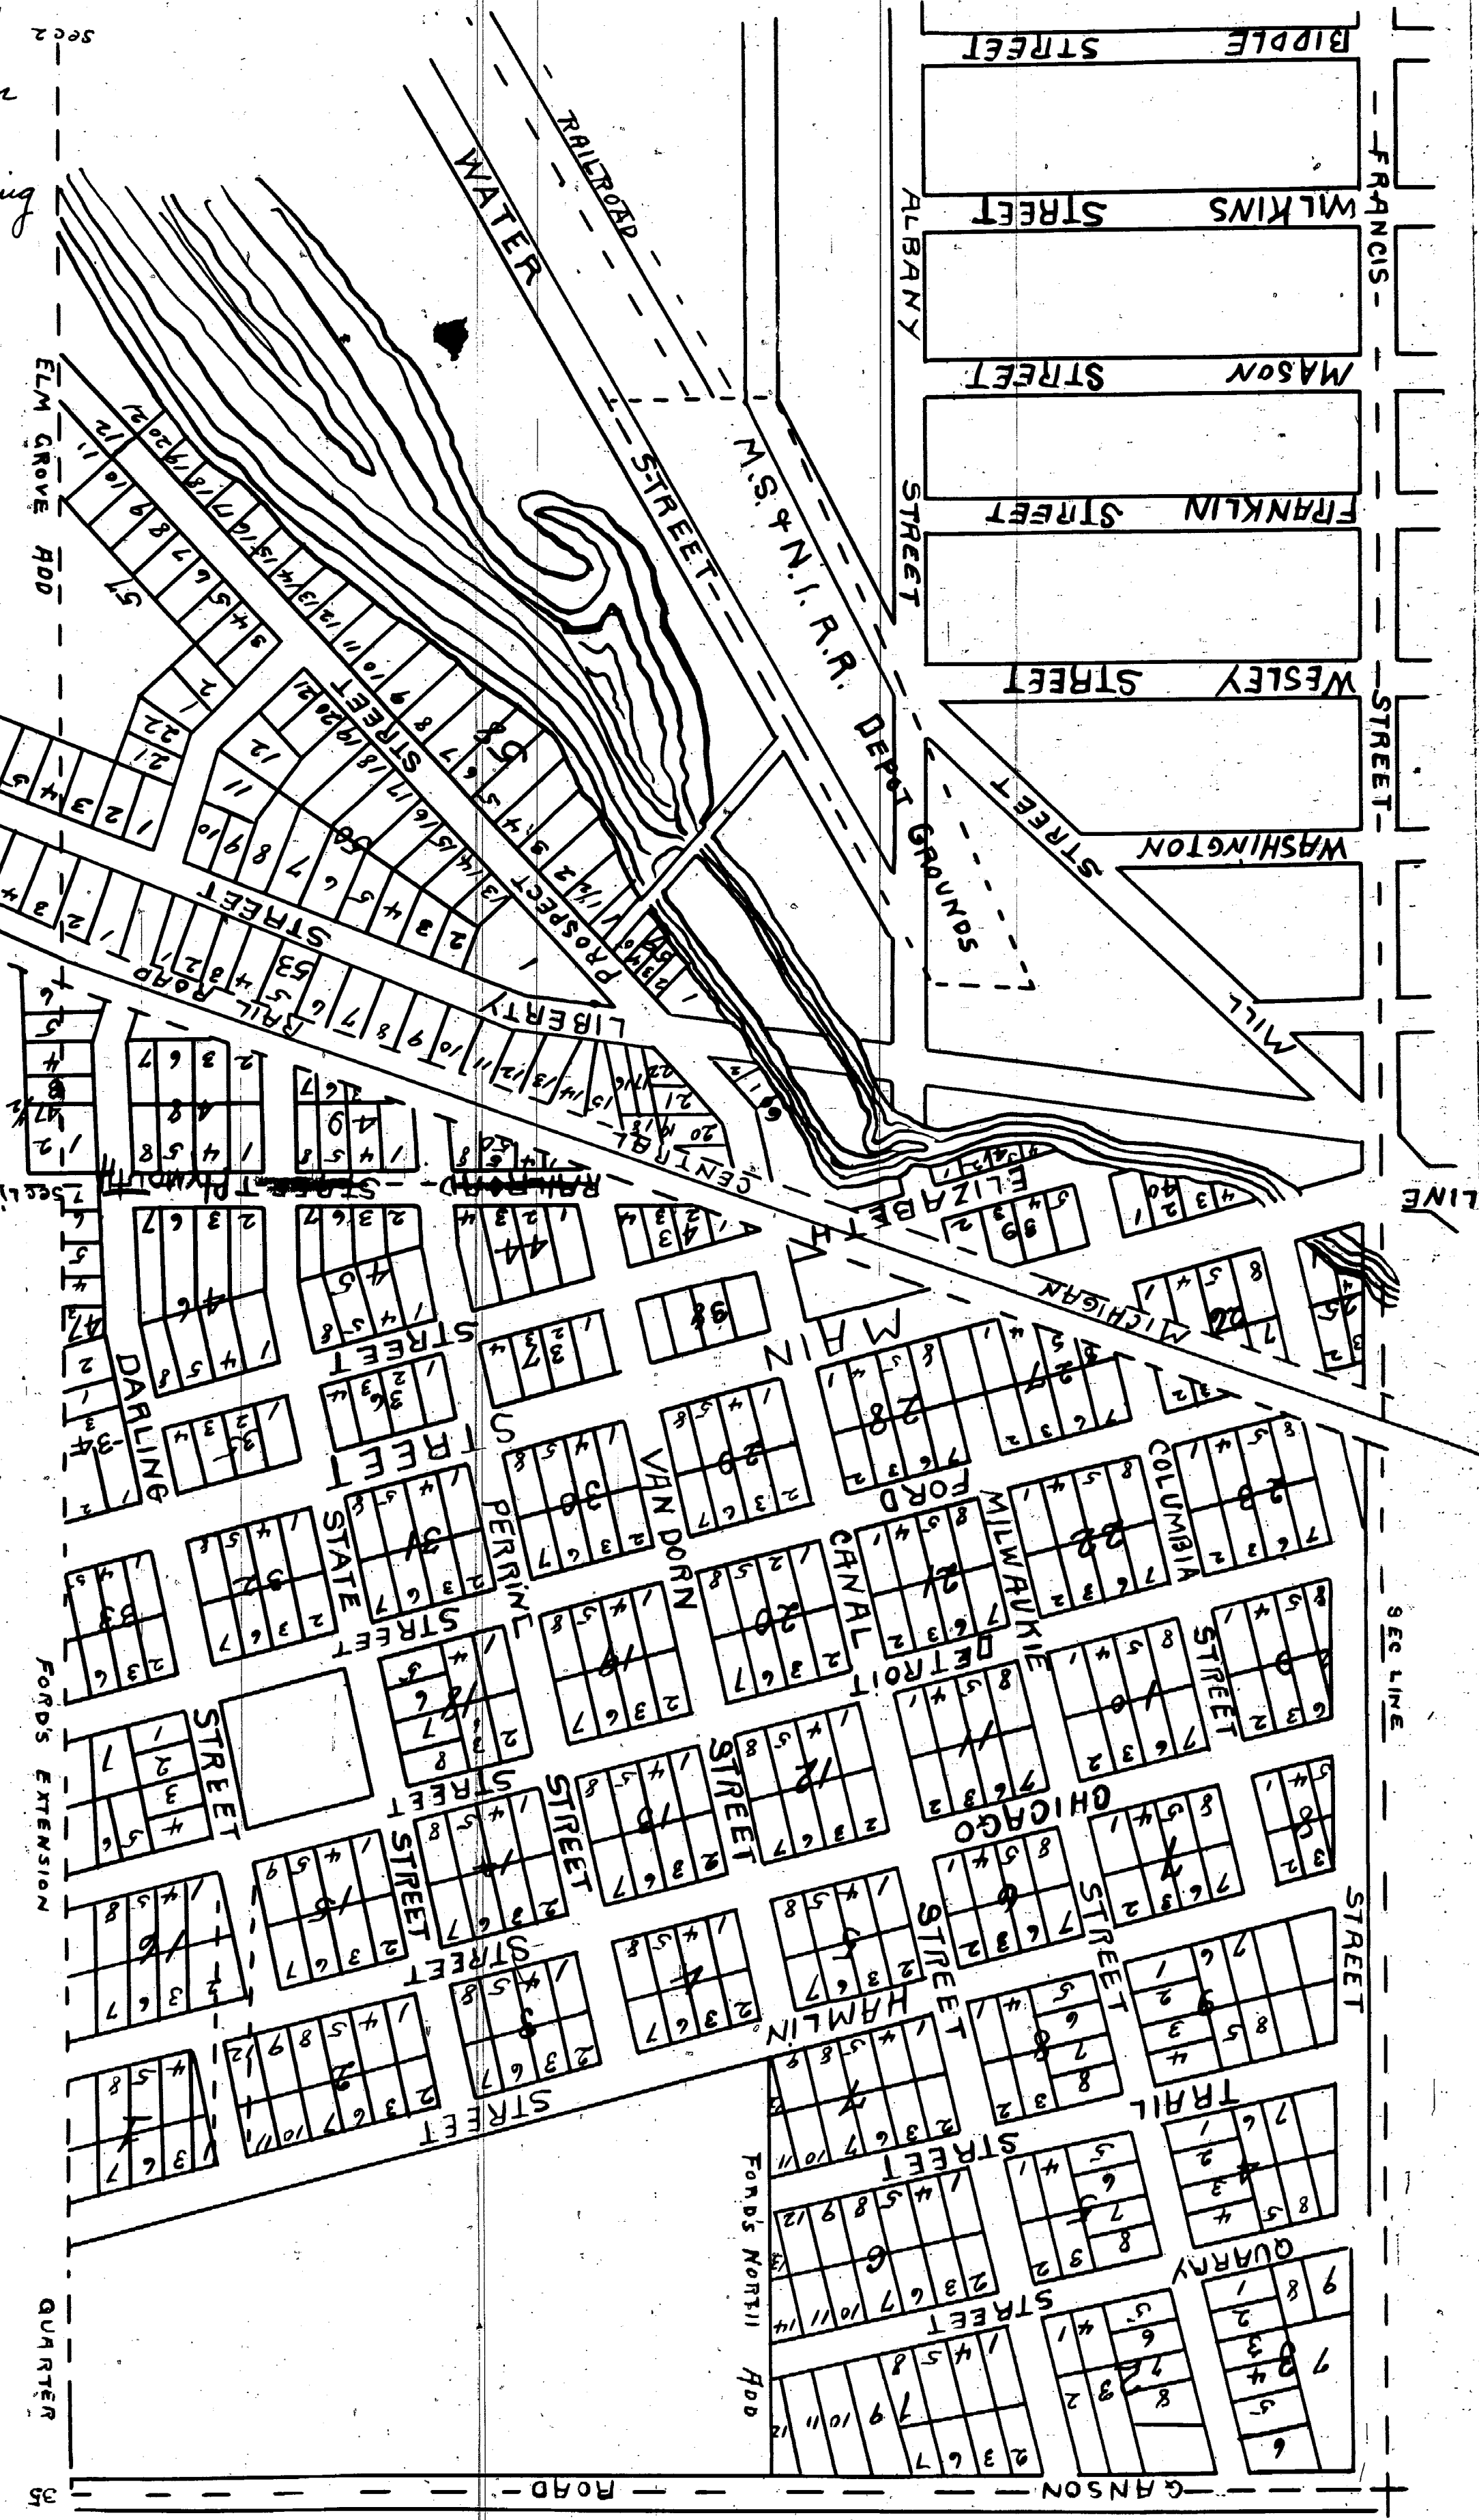

RESOLUTION

BY THE CITY COMMISSION:

WHEREAS, a petition has been filed by all of the persons, firms, and corporations owning property abutting on or located in, under or over a portion of a certain street in the City of Jackson, Michigan, for the vacation of said portion of said street more particularly described as:

Ford's Eastern Extension to the Village of Jacksonburgh - Detroit Street between State Street and Waterloo Avenue bounded by State House Square on the South and Block 15, Ford's Eastern Extension to the Village of Jacksonburgh on the North.

WHEREAS, it is determined that all persons, firms, and corporations who and which will be affected by said vacation have filed with the City Commission their written consent to the same, and that it is necessary for the health, welfare, comfort, and safety of the people of the City to vacate and discontinue such portion of said street; and

NOW, THEREFORE, BE IT RESOLVED that said street be and the same is hereby vacated, and the land shall revert to the abutting property free from any claim or right on the part of the public and that all public claims and rights in to said street are hereby forever barred.

BE IT FURTHER RESOLVED that the vacation of said street is upon the condition that the title to all water, sewer, and gas pipe, appurtenances and facilities; and all electric and communication poles, wires, conduits, cables, appurtenances and facilities now or hereafter in, under or over said street are reserved to and shall remain in the respective owners thereof, their successors or assigns, together with the easement and continued right to occupy said street, within the right-of-way thereof for public utility purposes, with present and additional facilities and to operate, repair, maintain, replace and remove the same to the same effect and in the same manner as if said street remained a public way.

BE IT FURTHER RESOLVED that the vacation of said street is upon the condition that Jackson Public Schools shall be required to close the street to through traffic in a manner to be approved by the City of Jackson Department of Engineering and Public Works.

* * * * *

State of Michigan)
County of Jackson) ss
City of Jackson)

I, Sandra L. Price, City Clerk in and for the City of Jackson, County and State aforesaid do hereby certify that the foregoing is a true and complete copy of a resolution adopted by the Jackson City Commission on the 18th day of February, 1992.

IN WITNESS WHEREOF, I have hereunto
affixed my signature and the Seal of the City
of Jackson, Michigan, on this 19th day of
February, 1992.

Sandra L. Price City Clerk

- B. RESOLUTION TO VACATE DETROIT STREET BETWEEN STATE STREET AND WATERLOO AVENUE BOUNDED BY STATE HOUSE SQUARE ON THE SOUTH AND BLOCK 15, FORD'S EASTERN EXTENSION TO THE VILLAGE OF JACKSONBURGH ON THE NORTH, AT THE REQUEST OF JACKSON PUBLIC SCHOOLS. (CITY PLANNING COMMISSION RECOMMENDS VACATION OF THE STREET.)

Motion was made by Comr. Dupuis and supported by Comr. Lakomowski to adopt the resolution.


The motion was adopted by the following vote. Yeas: Comrs. Smith, Griffin, DeLuca, Dupuis, Dirlam, Howe, Lakomowski, and Mayor Granger--8. Nays: 0. Absent: Comr. Barham--1.

The foregoing is an excerpt from the
City Commission Proceedings of
February 18, 1992

Sandra L. Price City Clerk

FORD'S EASTERN EXT.

No Scale

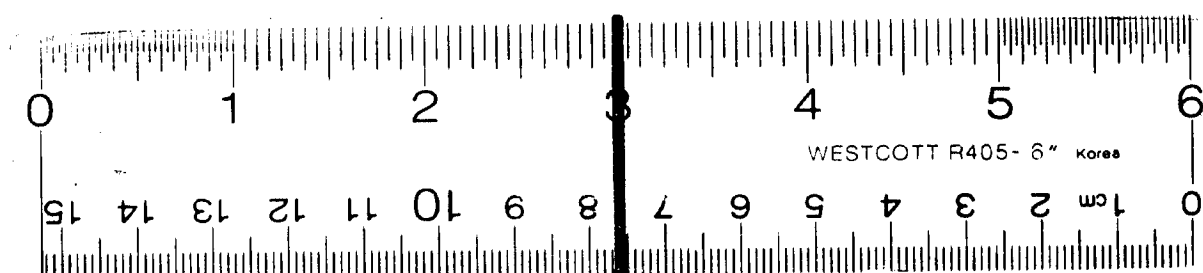

16 X

RESOLUTION

BY THE CITY COMMISSION:

WHEREAS, petition has been filed by all of the persons, firms and corporations owning property abutting on or located in, under or over a street in the City of Jackson, Michigan, for the vacation of said street more particularly described as:

All of East Avenue, north of Michigan Avenue and south of Homewild, and all of Pearl Street, East of Waterloo and West of North East Avenue.

WHEREAS, it is determined that all persons, firms, and corporations who and which will be affected by said vacation have filed with the City Commission their written consent to the same, and that it is necessary for the health, welfare, comfort, and safety of the people of the City to vacate and discontinue such street.

NOW, THEREFORE, BE IT RESOLVED that said street be and the same is hereby vacated effective as of March 1, 1991, and that as of that date the land shall revert to the abutting property free from any claim or right on the part of the public and that all public claims and rights in to said street are hereby forever barred.

BE IT FURTHER RESOLVED that the vacation of said street is upon the condition that the title to all water, sewer, and gas pipe, appurtenances and facilities; and all electric and communication poles, wires, conduits, cables, appurtenances and facilities now in, under or over said street that the City or any other utility deems not practical to move are reserved to and shall remain in the respective owners thereof, their successors or assigns, together with the easement and continued right to occupy said street, within the right-of-way thereof for public utility purposes, with present and additional facilities and to operate, repair, maintain, replace and remove the same to the same effect and in the same manner as if said street remained a public way.


13845 Brad's Subdivision

STATE OF MICHIGAN
COUNTY OF JACKSON SS:
CITY OF JACKSON)

I, Sandra L. Conant, City Clerk in and for the City of Jackson, County and State aforesaid, do hereby certify that the foregoing is a true and complete copy of a resolution adopted by the Jackson City Commission on the 13th day of November, 1990.

IN WITNESS WHEREOF, I have hereunto affixed my signature and seal of the City of Jackson, Michigan, on this 13th day of November, 1990.

Sandra L. Conant City Clerk

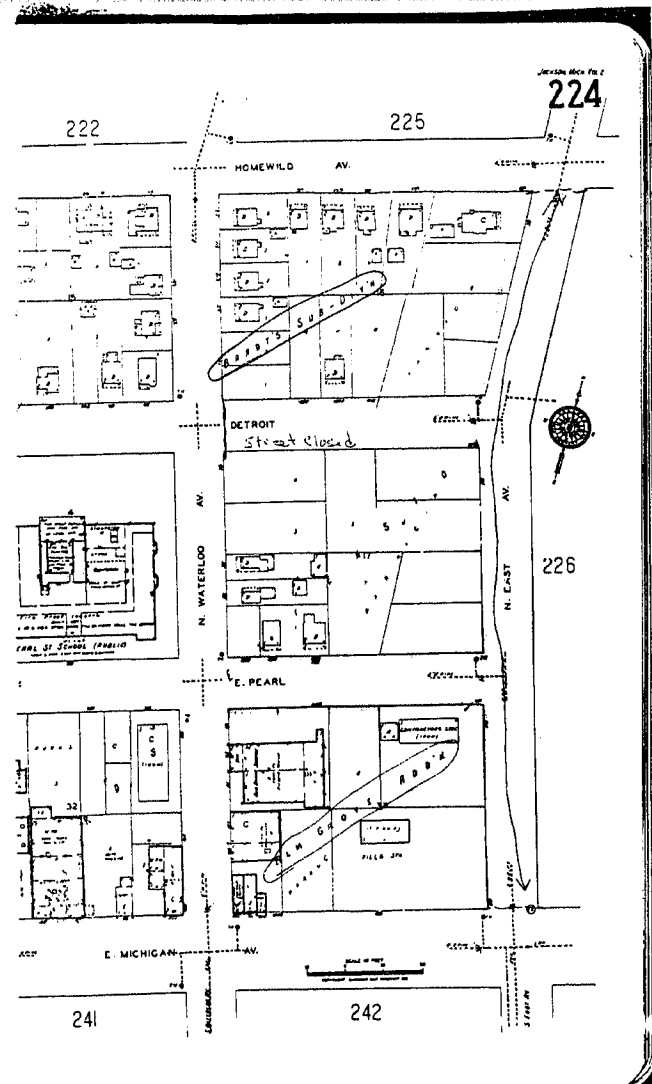

Jackson

10397

RESOLUTION

BY THE CITY COMMISSION:

WHEREAS, petition has been filed by all of the persons, firms and corporations owning property abutting on or located in, under or over a street in the City of Jackson, Michigan, for the vacation of said street more particularly described as:

Parcel of land in the S 1/2 of Sec. 35, T2S, R1W, City of Jackson, Blackman Twp., Jackson County, Michigan; Being more specifically desc as beg at the NW cor of Lot 4, Blk 17, Ford's Ext of the Vil of Jackson, a recorded plat, as recorded in Liber 1 of Plats, page 1, Jackson County Records; th N 14°31'52" W alg the Ely ln of Waterloo Avenue (so-called) 66' to the SW cor of Lot 1, Blk 16, Ford's Ext of the Vil of Jackson; th N 75°21'13" E alg the Sly ln of said Blk 16, 314.27' to the existing Wly ln of East Avenue (so-called); th S 17°53'29" E alg the existing Wly ln of East Avenue 65.83' to the Nly ln of Blk 17, Ford's Ext of the Vil of Jackson; th S 75°18'29" W alg the Nly ln of sd Blk 17, 317.74' to the pl of beg otherwise known as Detroit Street lying between the easterly line of Waterloo Avenue and the westerly line of East Avenue.

AND WHEREAS, it is determined that all persons, firms and corporations who and which will be affected by said vacation have filed with the City Commission their written consent to the same, and that it is necessary for the health, welfare, comfort and safety of the people of the City to vacate and discontinue such street;

NOW, THEREFORE, BE IT RESOLVED, that said street be and the same is hereby vacated, and the land shall revert to the abutting property free from any claim or right on the part of the public and that all public claims and rights in and to said street are hereby forever barred, and

BE IT FURTHER RESOLVED, that the vacation of said street is upon the condition that the title to all water, sewer, and gas pipe, appurtenances and facilities; and all electric and communication poles, wires, conduits, cables, appurtenances and facilities now or hereafter in, under or over said street are reserved to and shall remain in the respective owners thereof, their successors or assigns, together with the easement and continued right to occupy said street, within the right-of-way thereof for public utility purposes, with present and additional facilities and to operate, repair, maintain, replace and remove the same to the same effect and in the same manner as if said street remained a public way.

State of Michigan)
County of Jackson) as
City of Jackson)

I, Betty J. Granger, Clerk in and for the City of Jackson, County and State aforesaid, do hereby certify that the foregoing is a true and complete copy of a resolution adopted by the Jackson City Commission on May 21, 1980.

IN WITNESS WHEREOF, I have hereto
affixed my signature and the seal
of the City of Jackson, Michigan,
this 22nd day of May, 1980.

Betty J. Granger City Clerk

10397

