10470

Memoranda of Surveys of SW 1/4 Sec 31 T4N R 15W

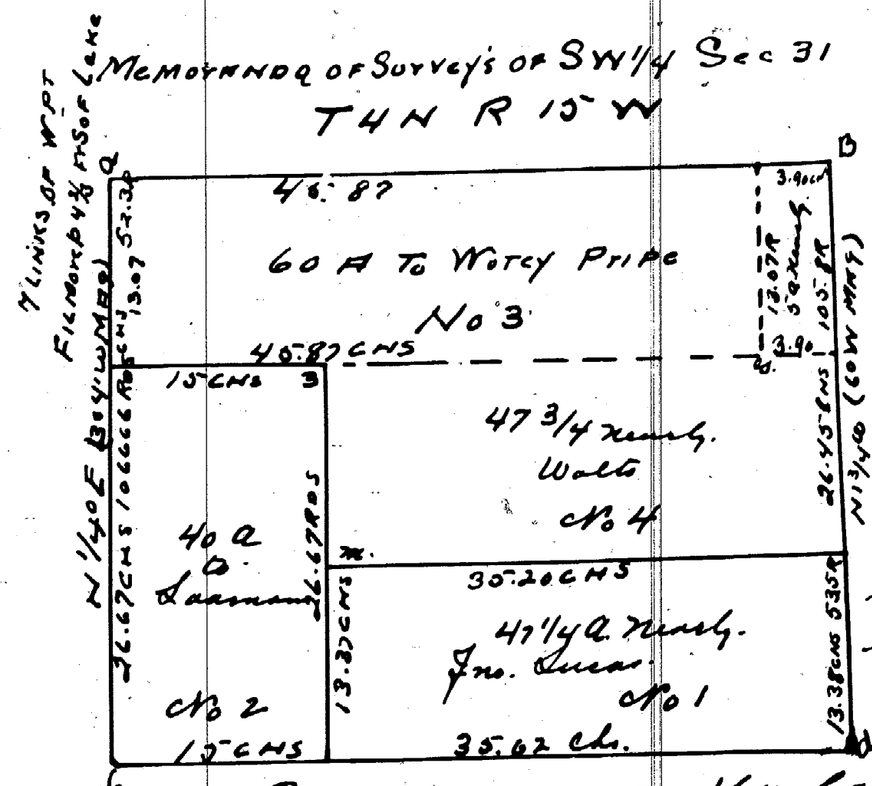

Dec 31. 1867 c.d. Measured 50.45 ch. } D. Updyke } Chainmen as below.
" 6d " 39.70 " } J. John }

July 1868 c " 49.70 chs } A Kuhlman } Chainmen Swan.
" ae " 39.74 " } J. Tuttle }
en " 15.00 " } A. Tuttle }

Oct 1838 Surv " 13.37 ch } H. Haaman } Chainmen Kenyon
H. Wally }

May 20 Chain compared with that of Chichester & Kenyon found to agree with Various Measurements. Correction have been estimated to said. Cd. to be. 50.62 ch. Bd. to be. 39.63 ch. 9 Qr. Post has. Fellows set 7 links south of U.S. Post from Chichester. the Center Qr. Post has not 31 Planned on line joining N. & W 1/4 Posts sec 31 C. N.W. Corner of sec 31 Cors of Ts 3 & 4 S. — R. 15 & 16 W and Found Qr. Post of sec. 31. were found. Can evan. appearing in County Surveyor Act 1st 1869. A Johnson of Allegan. Co. Mich. to be surveyed and platted and Lots Numbered as represented on the other side of the Paper. and authorize the same to be put upon the record of said County thereof. Witness my hand and seal this day and year above written.

John. Swan. (L.S.)

Witness of Chas. Chichester

State of Michigan } ss. On this 15th day of March 1870 before me a Notary
Allegan County } Public in & for said County personally came John. Swan. known
to me the Person. who executed the above instrument and acknowledged
the same to be his free act and deed. Chas. Chichester Notary Public.
Allegan. Co. Mich.

Recorded and recorded the. 30th 1870 at 5 o'clock. P.M.
Wm C. Weeks. Register.

I hereby certify that the Plat is a correct copy of the Plat now on record in the Register of Deeds office, being made under the supervision of the undersigned by tracing the Plat on record and attaching thereto a carefully compared copy of the certificate

Dated this 3rd day of May 1911

Ray C. Warner
County Auditor