


Chas of J Godfrey Land Received for Record this 12th day of January A.D. 1847
in Hamtramck at 11 1/2 O'clock A.M. Chas. V. S. Register

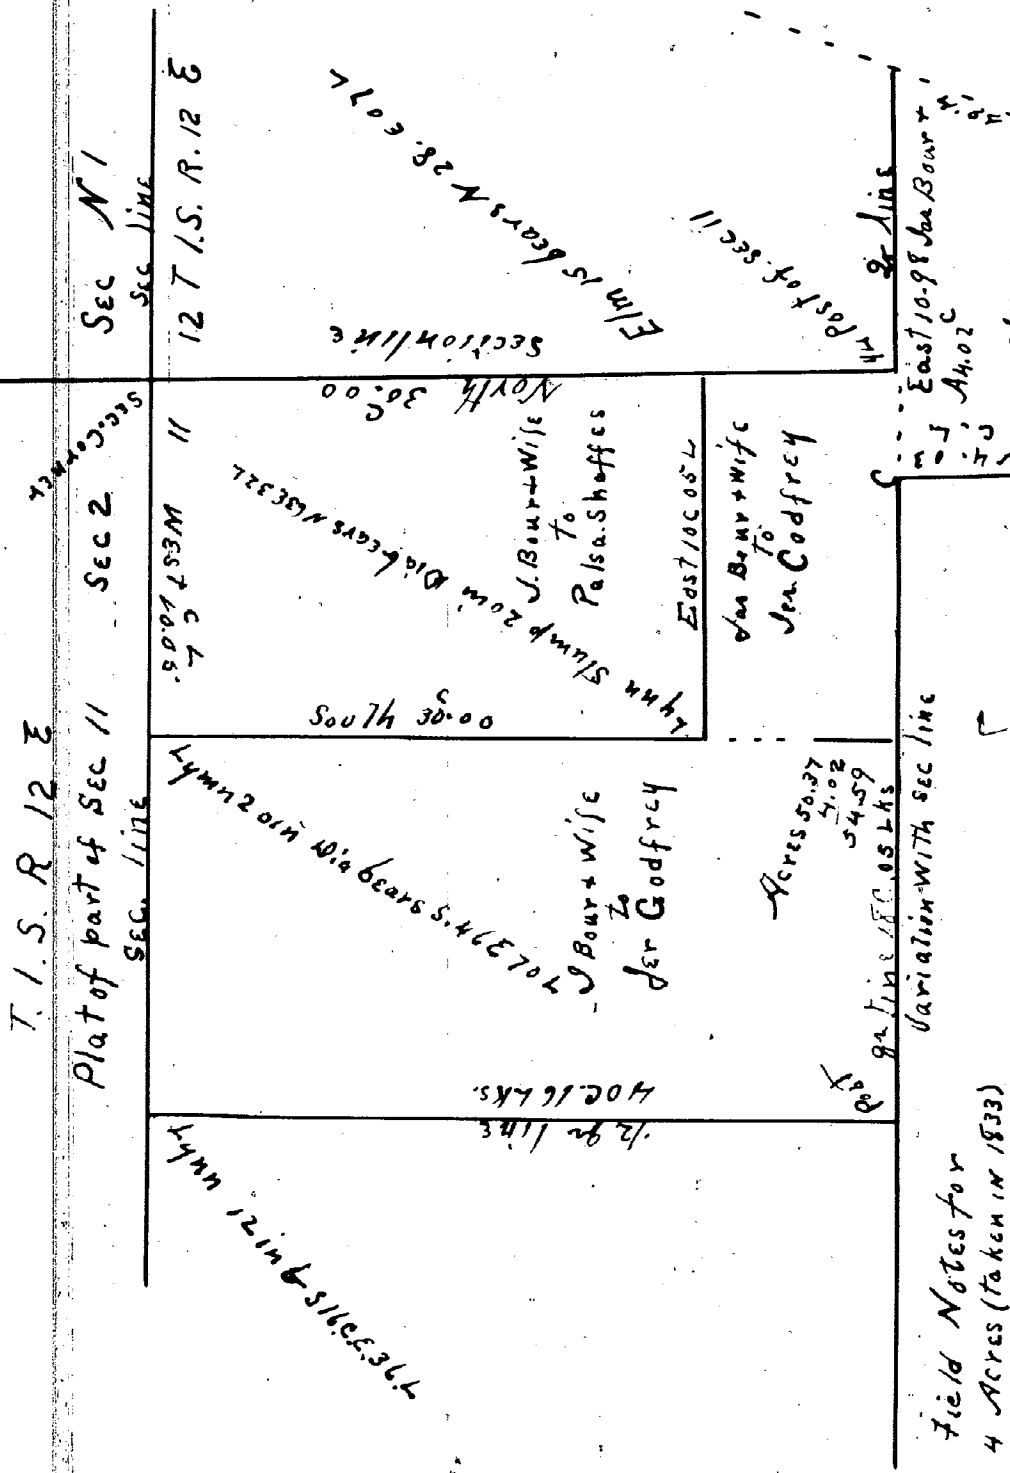

Field Notes for
4 Acres (taken in 1833)

Timber	Dia	Courses	Dist
A	Beech	12 N 11 W	1.46
	do	14 S 14 E	1.36
B	Beech	12 S 13 E	.13
	do	18 N 70 W	.26
C	E/m	20 W 57 E	.18
	Maple	4 N 20 E	.02
D	B Ash	8 S 92 E	.92
	E/m	26 N 61 W	.75

In the Dead this course is East But the Post + trees
are still standing + must be with
Detail 19 June 1846 A E Nathan

I hereby certify that this plat is a correct copy of the plat
now on record in the Registry of Deeds office being made
under the supervision of the Auditor General by tracing
the plat on record and affixing thereto a carefully compared
copy of the Dedication + certification
Dated this 3rd day of May 1910
John B. L. Lantier
Clerk Aud. Gen. Dep.

Plat of Part of the
Beaufait Farm

I certify the above survey and plat to be correct
from actual survey Dated 7th March 1846
A E Nathan
Surveyor

Louis Chaplin					

Subdivision of Canebe claim No 19 made at the request of the grantee of Louis Beaufait
on the 6th of March A.D. 1846

We hereby acknowledge ourselves each one of us the undersigned to be
satisfied with the above subdivision and agree to accept to the same
and divest the same to be recorded
Dated March 7th 1846
In presence of
W J Young
A E Nathan

Daniel Moore
Louis L Beaufait
Elizabeth Driskill
George Kraft

Plat for Record this 9th day of
April A.D. 1847 at 5 o'clock P.M.
Chas. V. S. Register

Jefferson Avenue N. E. To be opened 100 ft wide as shown as
the terms below are opened in the City Limits
No 1 George Crabbe grantee of
Catherine Beaufait wife of
Francis Beaufait Decded
May 30 - 1845
No 2 Vilot Beaufait
Decded May 30 1845
Dated May 30 1845