

City Council
March 21, 1910

Res. 20th day of May 1910
Geo. W. Russell
Clerk and Secy. Regt.

I hereby certify that this plat is a correct copy of the plat now on record in the Register of Deeds office being made under the supervision of the Auditor General by having the plat be record and affixing thereto a carefully compared copy of the Declaration and Certificate.

Record for Record this 12th December 1884
at 3 1/2 O'clock P.M. Henry Campbell
Register



10673

RESOLUTION

Wyandotte, Michigan
June 17, 1963

RESOLUTION by Councilman Clifford E. Clack

At a regular session of the City Council of the City of Wyandotte.

RESOLVED BY THE CITY COUNCIL OF THE CITY OF WYANDOTTE:

WHEREAS, this Council by resolution has deemed it advisable to vacate as a public alley the hereinafter described land in the City of Wyandotte, County of Wayne, State of Michigan, more particularly described as:

The northerly portion of the (20) twenty foot wide alley lying west of Biddle Avenue from Oak Street to the alley north. More particularly described as that portion of the alley lying west of the south 2.51 feet of lot 7 and the north 47.77 feet of lot 8, both measured along the alley line and lying east of the north 50.28 feet of lot 10, all of the above lots being located in Block 56, Plat of Part of Wyandotte, Ecorse Township (now The City of Wyandotte), Wayne County, Michigan, and being a part of Fractional Sections 28, 32, 33 and part of Section 29, Town 3 South, Range 11 East,

and,

WHEREAS, due notice has been given of the hearing on objections to said vacation; and

WHEREAS, said hearing having taken place in accordance with such publication, and no objections having been offered, and this Council still being of the opinion that said improvement and vacation is advisable; now, therefore,

BE IT RESOLVED:

That the above described parcel of land shall be and the same is hereby declared VACATED, DISCONTINUED AND ABOLISHED as a public alley.

I move the adoption of the foregoing resolution.

Motion by Councilman Clifford E. Clack

Supported by Councilman Bernard Smith

YEAS	COUNCILMEN	NAYS
☒	Clack	☐
☒	Groat	☐
☒	McCauley	☐
☒	Palamara	☐
☒	Smith	☐
☒	Sullivan	☐

ABSENT: McCauley

STATE OF MICHIGAN,
County of Wayne,
City of Wyandotte

I, STANLEY RATYNSKI, City Clerk of the City of Wyandotte, in said county and state, do hereby certify that the annexed is a true copy of a resolution adopted by the City Council of the said City of Wyandotte, on the 17th day of June, A.D. 1963. That I have compared the same with the original resolution on file in my office, and that said copy is a full, true and correct transcript therefrom and of the whole of said resolution.

In Witness Whereof I have hereunto set my Hand and have caused the corporate seal of the City of Wyandotte to be hereunto affixed, this

17th day of January, A.D. 1964
Stanley Ratynski
City Clerk.

CERTIFICATE

I, Stanley Ratynski, City Clerk of the City of Wyandotte, Michigan, do hereby certify that on June 17, 1963, the City Council of the City of Wyandotte, adopted a Resolution vacating a public alley in the City of Wyandotte, County of Wayne, State of Michigan, said alley being more particularly described as:

The northerly portion of the (20) twenty foot wide alley lying west of Biddle Avenue from Oak Street to the alley north. More particularly described as that portion of the alley lying west of the south 2.51 feet of lot 7 and the north 47.77 feet of lot 8, both measured along the alley line and lying east of the north 50.28 feet of lot 10, all of the above lots being located in Block 56, Plat of Part of Wyandotte, Ecorse Township (now the City of Wyandotte), Wayne County, Michigan, and being a part of Fractional Sections 28, 32, 33 and part of section 29, Town 3 South, Range 11 East.

I do further certify that the name or names of any plat, subdivision or addition in said City affected by such Resolution are as follows:

Block 56, Plat of Part of Wyandotte, Ecorse Township (now the City of Wyandotte), Wayne County, Michigan, and being a part of Fractional Sections 28, 32, 33 and part of Section 29, Town 3 South, Range 11 East.

Dated: January 17, 1964.

Stanley Ratynski
Stanley Ratynski
City Clerk

STATE OF MICHIGAN)
COUNTY OF WAYNE) ss

On this 17 day of January, 1964, before me, a Notary Public in and for said County, personally came Stanley Ratynski, known to me to be the person described in and who executed the foregoing certificate, and being by me first duly sworn, did depose and say that he is the duly elected City Clerk of the City of Wyandotte, Michigan, and that the foregoing certificate is true of his own knowledge, and acknowledged that he executed the same for the intents and purposes therein set forth.

Leon J. Jankowski
Notary Public, Wayne County, Michigan
My commission expires: May 19-1964

January 7, 1965

Stanley Ratynski
Wyandotte City Clerk
Wyandotte, Michigan


RESOLUTION TO VACATE A PORTION OF ALLEY, PLAT OF PART
OF WYANDOTTE, CITY OF WYANDOTTE, WAYNE COUNTY, ADOPTED
JUNE 17, 1963

In order to post our records, it will be necessary
that we have a sketch showing its location.

ALLISON GREEN
Acting Auditor General

By Amy Van Driesen

AVD/va

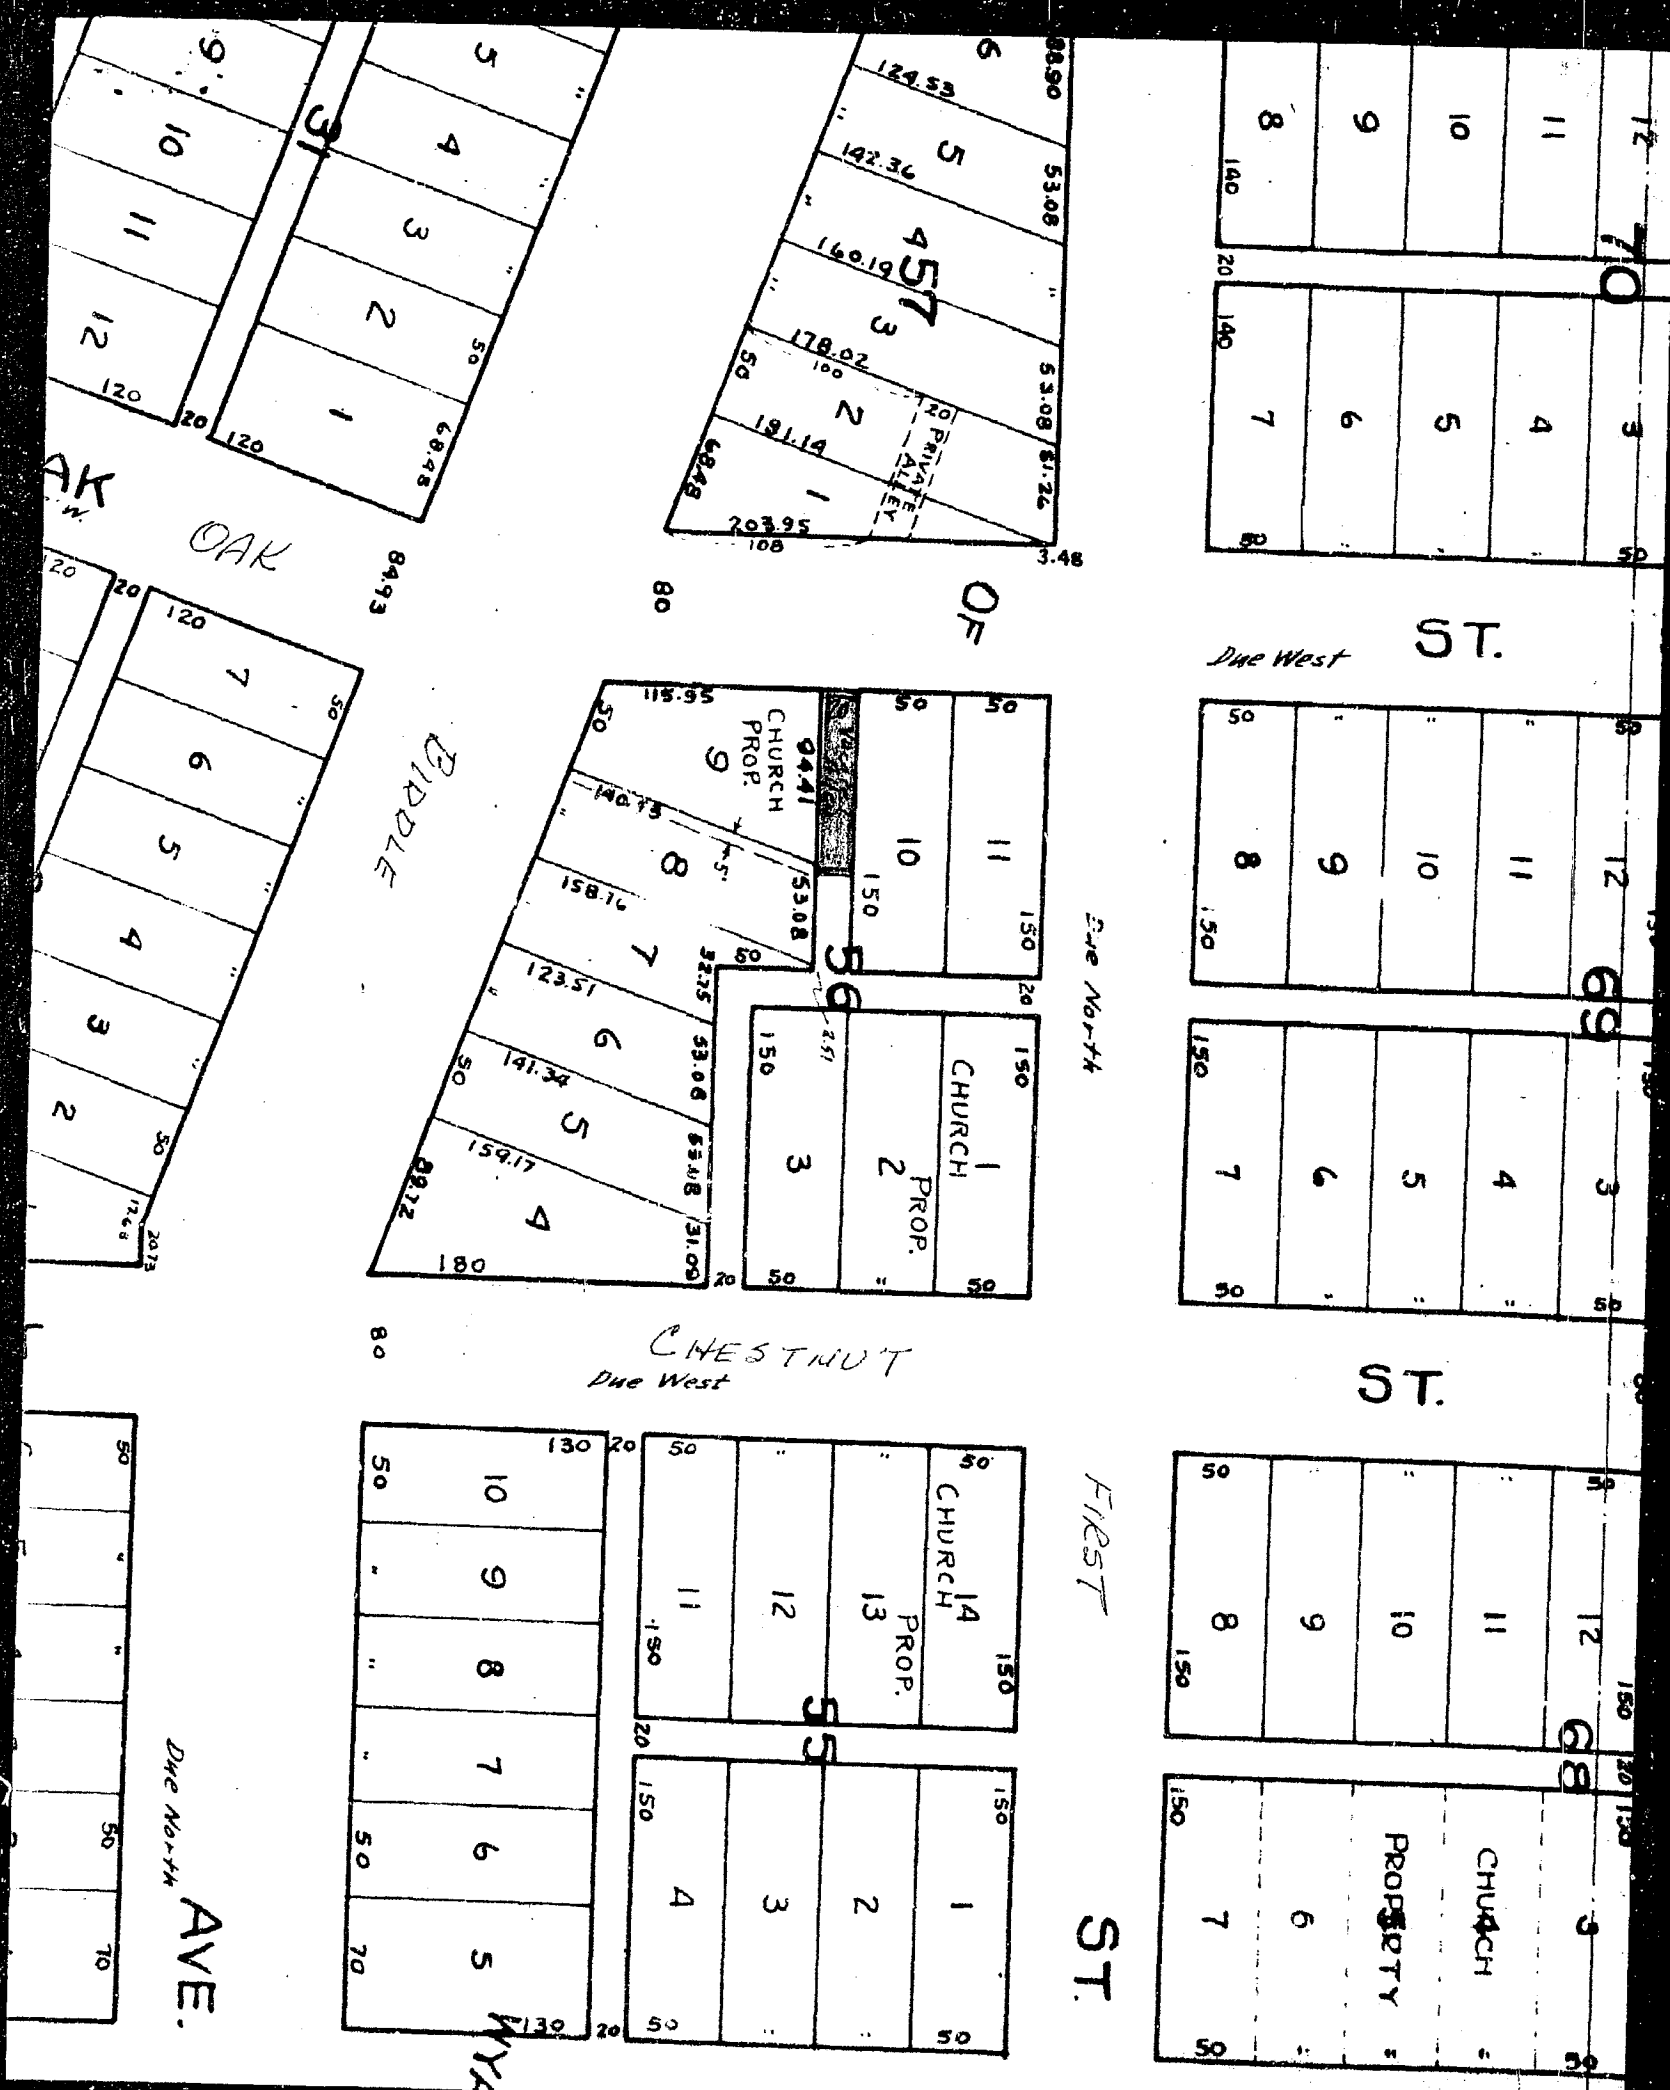

DA 508

CERTIFICATE OF AUTHENTICITY

This is to certify that the microphotographs appearing on this film,

starting with Vacation Notices 1966

and ending with Vacation Notices JAN 1966 WAYNE Co City of Wyandotte

are accurate and complete reproductions of the records of (Dept.)

Auditor GEN as delivered to the State Records

Center in the regular course of business for microphotographing.

6-21-66 Richard Dase
Date Produced Camera Operator